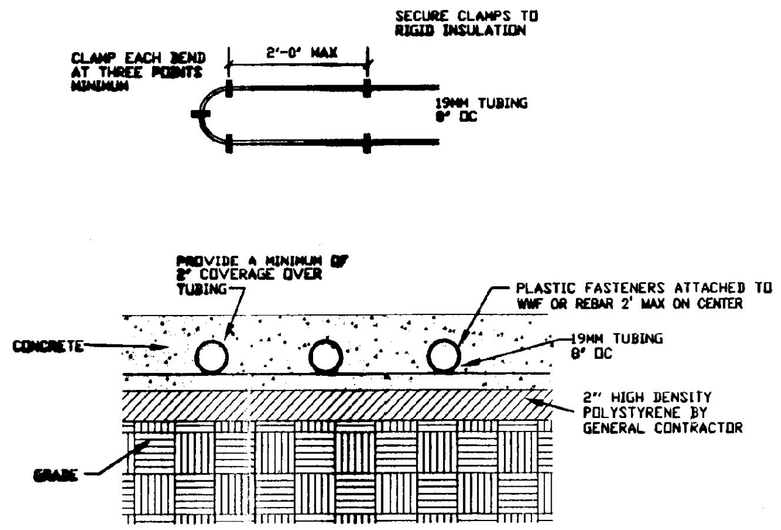

SNOW MELTING TUBING INSTALLATION DETAIL

NOT TO SCALE

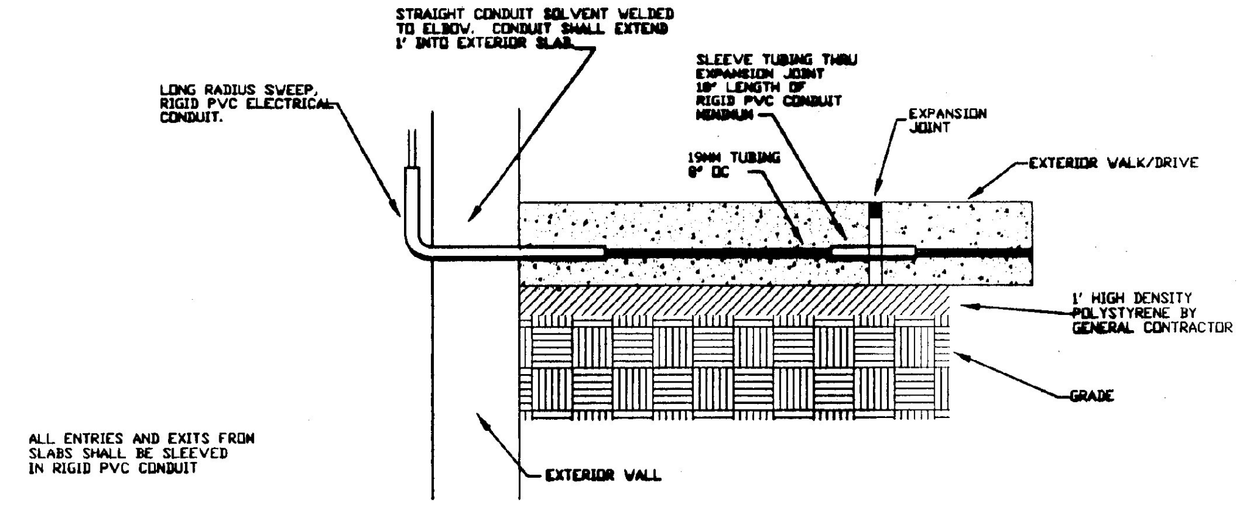

SNOW MELTING TUBING INSTALLATION DETAIL

NOT TO SCALE

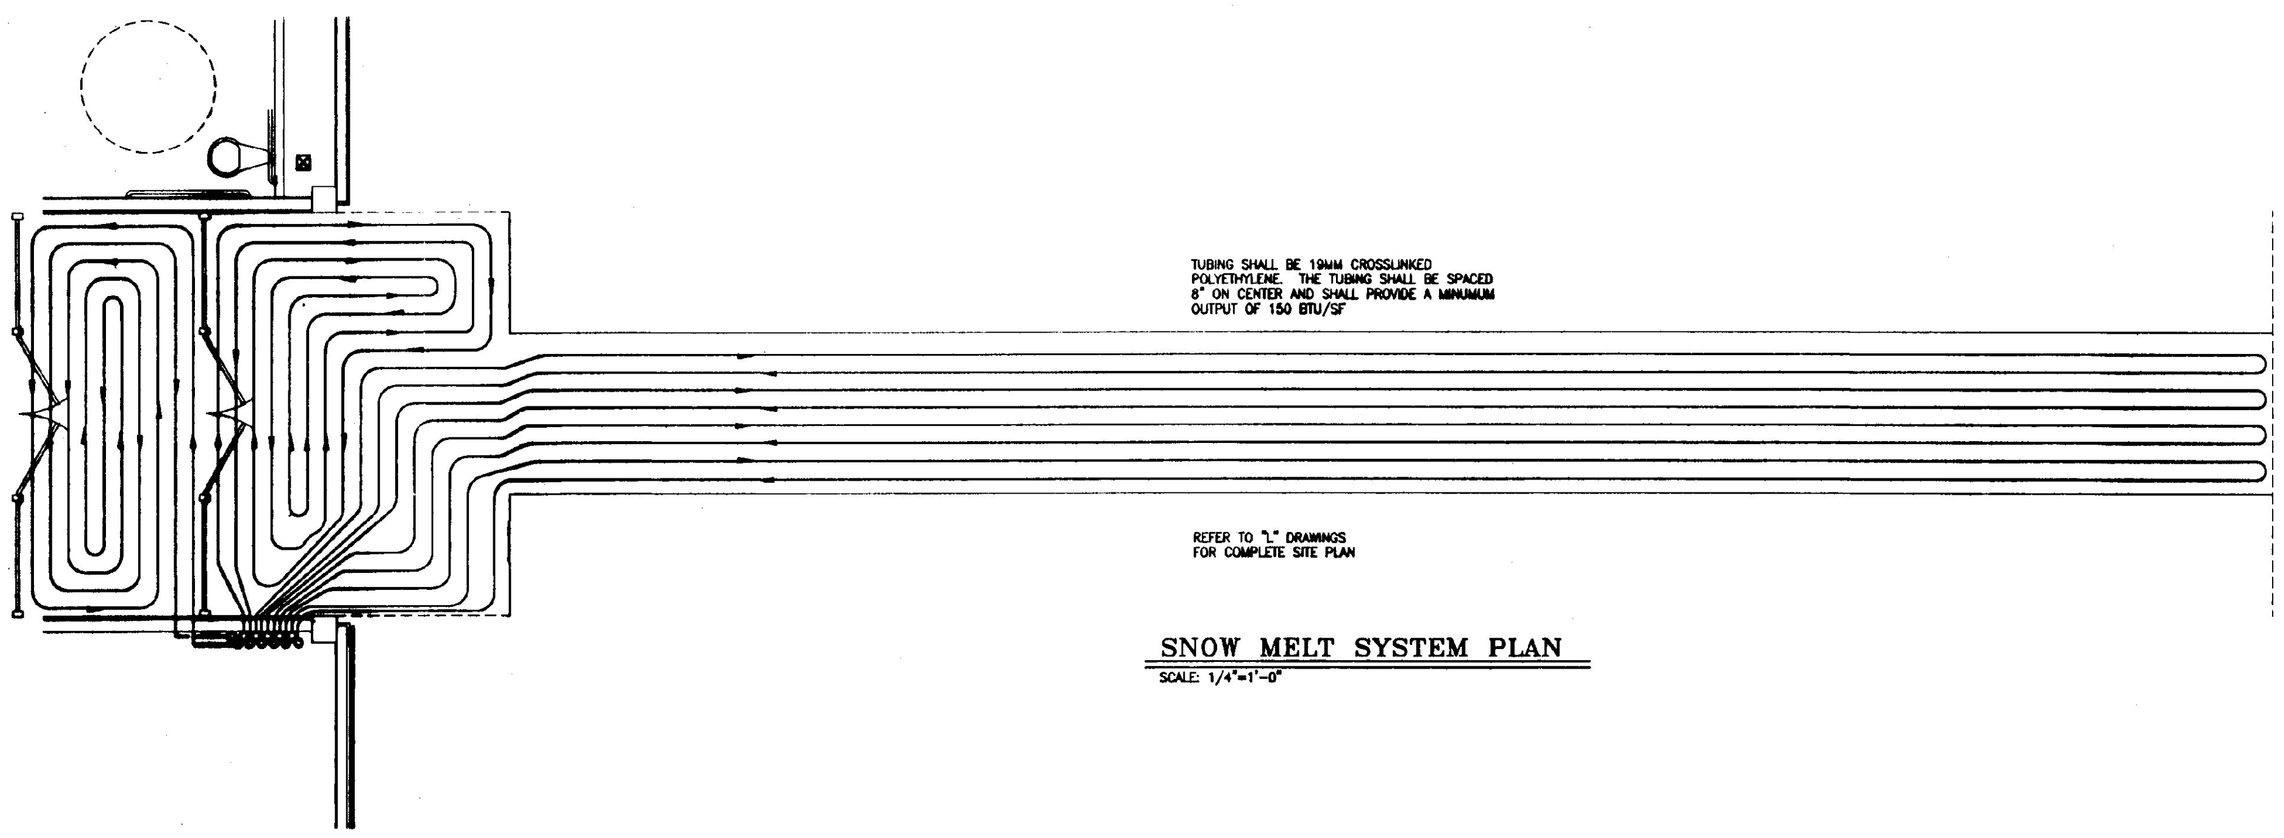

SNOW MELT SYSTEM PLAN

SCALE: 1/4"=1'-0"

RECORD DRAWING

NO.	DATE	REVISIONS	DRWN	CHKD

TIMOTHY D. SMITH & ASSOCIATES, PC ARCHITECTS
OLD RAILROAD STATION
802-442-8184
NORTH BENNINGTON, VERMONT 05257
FAX 802-442-5241

WRIGHT ENGINEERING, LTD.
CIVIL ENGINEERS
120 MERCHANTS ROW - P.O. BOX 178
RUTLAND, VERMONT 05702-0178
802-775-0511 FAX 775-5015

ROBT W. HALL
CONSULTING ENGINEERS, INC.
540 MEADOW STREET EXTENSION, STE. 2
AGAWAM, MASSACHUSETTS 01001-0002
413-789-0669 FAX 789-2896

T.J. BOYLE AND ASSOCIATES
LANDSCAPE ARCHITECTS
301 COLLEGE STREET
BURLINGTON, VERMONT 05401
802-658-3555 FAX 863-1642

STATE OF VERMONT REGISTERED PROFESSIONAL ENGINEER No. 5814 ROBERT F. WRIGHT

1-16-98

PROJECT NO.IM 091-1 (30)
SOUTHEAST VERMONT WELCOME CENTER
GUILFORD, VERMONT
PRELIMINARY DRAWINGS

SHEET TITLE: SNOW MELT SYSTEM PLANS & DETAILS

DSGN BY: RFG
DRWN BY: RFG
CHKD BY: RFG
CHKD BY: RWH

STATE OF VERMONT
AGENCY OF ADMINISTRATION
DEPARTMENT OF
BUILDINGS & GENERAL SERVICES

DATE: 1-16-98 SHEET NO.____ _OF_____SHEETS

M-3