




TYPICAL URINAL SENSOR WIRING DIAGRAM  
NOT TO SCALE

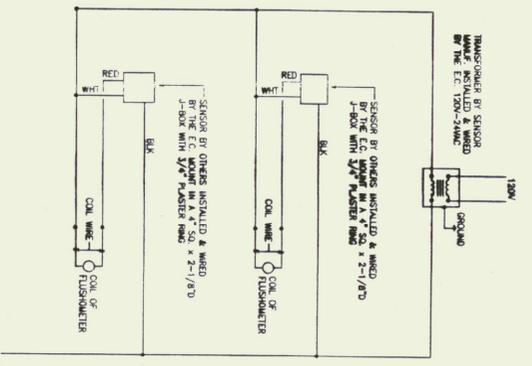


TYPICAL SINK SENSOR WIRING DIAGRAM  
NOT TO SCALE

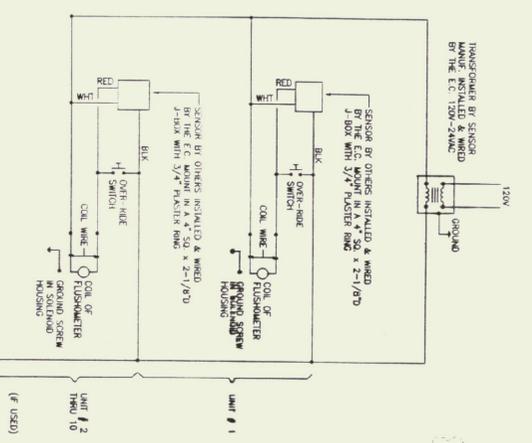

TYPICAL WATER CLOSET SENSOR WIRING DIAGRAM  
NOT TO SCALE

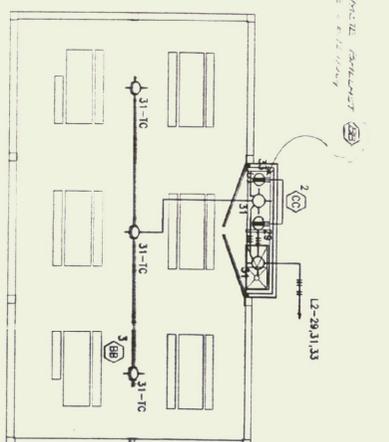


PICNIC SHED ELECTRICAL PLAN  
SCALE 1/8" = 1'-0"

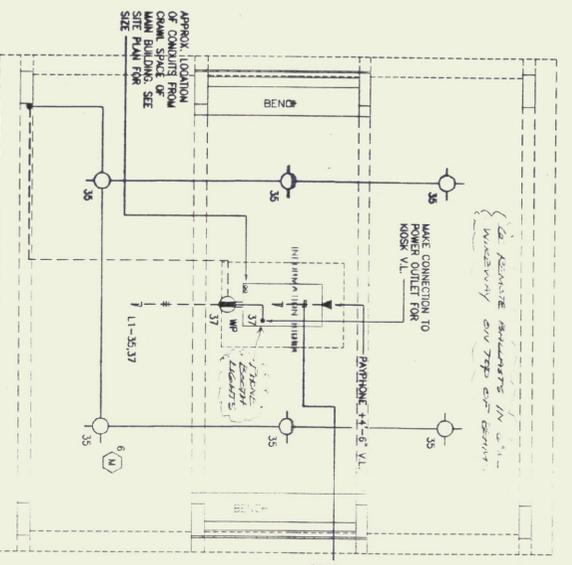


SCALE 1/8" = 1'-0"


- SCHEDULE NOTES**
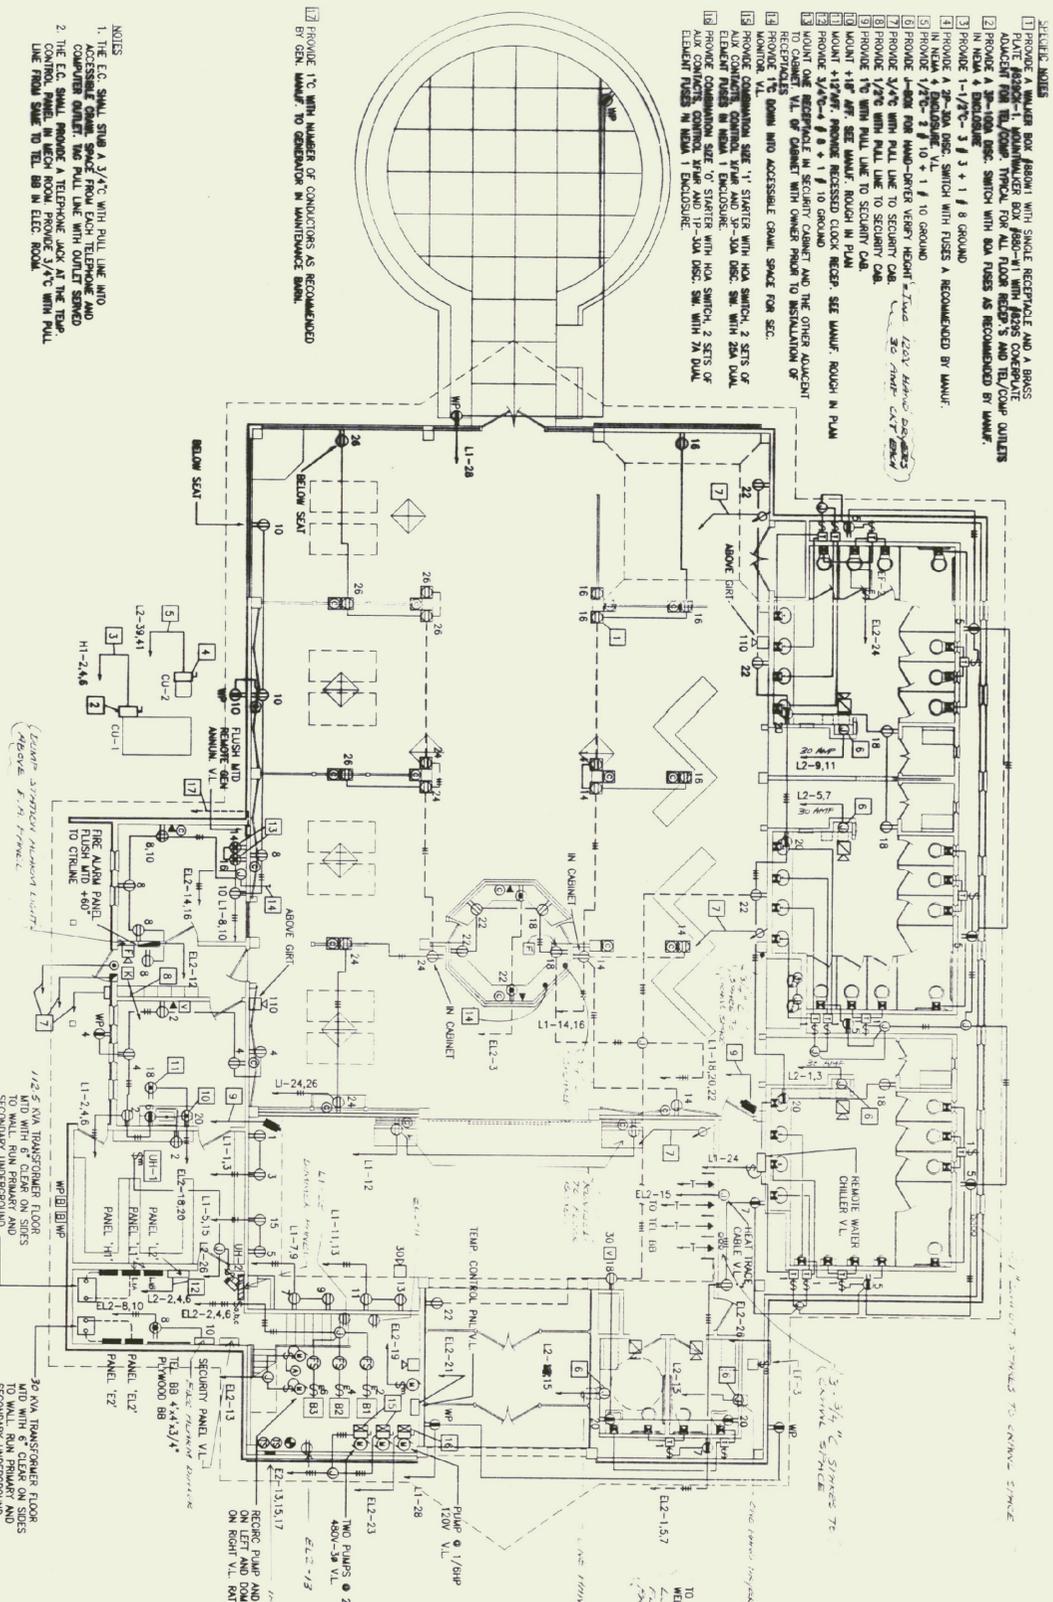

BUILDING POWER PLAN  
SCALE 1/8" = 1'-0"

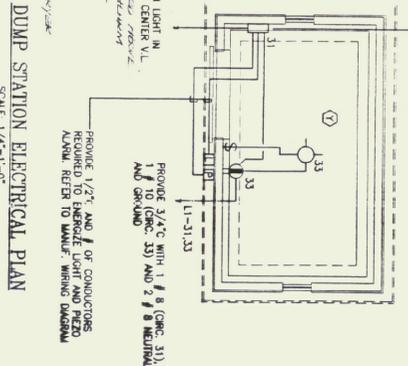

DUMP STATION ELECTRICAL PLAN  
SCALE 1/4" = 1'-0"

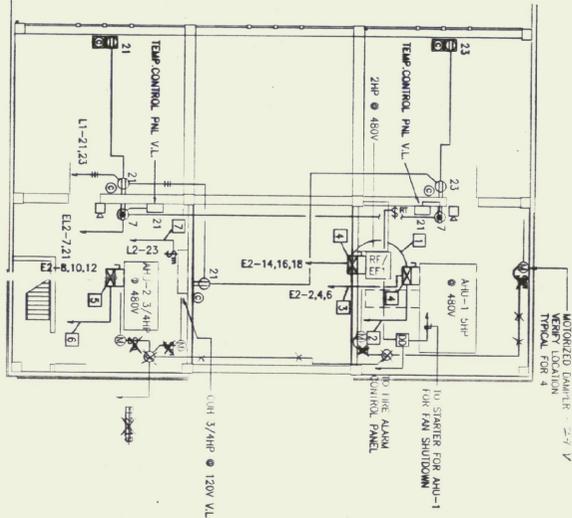

UPPER LEVEL POWER PLAN  
SCALE 1/8" = 1'-0"

NO.	DATE	REVISIONS	DRWN	CHKD

TIMOTHY D. SMITH & ASSOCIATES, PC ARCHITECTS  
 OLD RAILROAD STATION  
 802-442-8184  
 NORTH BENNINGTON, VERMONT 05257  
 FAX 802-442-5241

ROBT W. HALL  
 CONSULTING ENGINEERS, INC.  
 640 WINDY STREET EXTENSION, STE. 2  
 BURLINGTON, VERMONT 05401  
 802-486-0800  
 FAX 802-486-0800

T.J. BOYLE AND ASSOCIATES  
 LANDSCAPE ARCHITECTS  
 301 COLLEGE STREET  
 BURLINGTON, VERMONT 05401  
 802-486-3535  
 FAX 802-486-1562



PROJECT NO. IM 091-1 (30)  
 SOUTHEAST VERMONT WELCOME CENTER  
 GUILFORD, VERMONT

DESIGN BY: MLB  
 DRAWN BY: MLB  
 CHECKED BY: RMH

STATE OF VERMONT  
 AGENCY OF ADMINISTRATION  
 DEPARTMENT OF  
 BUILDINGS & GENERAL SERVICES

DATE: 01-16-98  
 SHEET NO. OF SHEETS