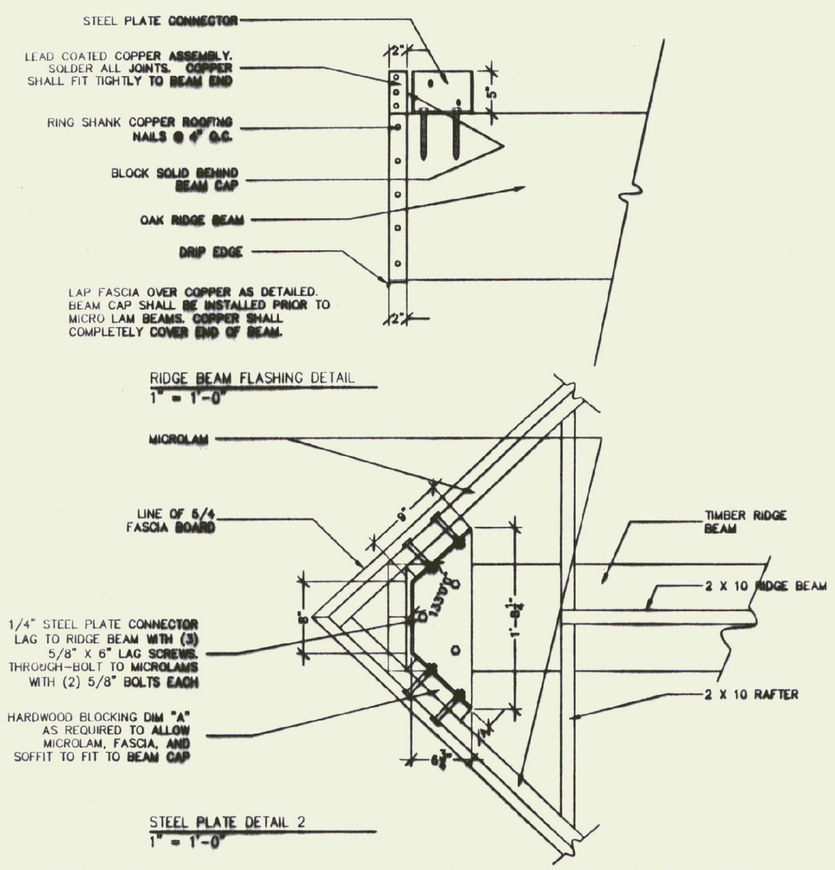

CS-6 | SOUTHEAST VERMONT WELCOME CENTER GUILFORD VERMONT | HAY HOOD CONSTRUCTION DETAILS REVISIONS | TIMOTHY D. SMITH & ASSOCIATES, P.C. OLD RAILROAD STATION NORTH BENNINGTON 802 442-8184 | P.O. BOX 158 VERMONT 05257 FAX 442-5241 | JOB NO. 99462.00 | DWN. BY | CK. BY | 7/9/98

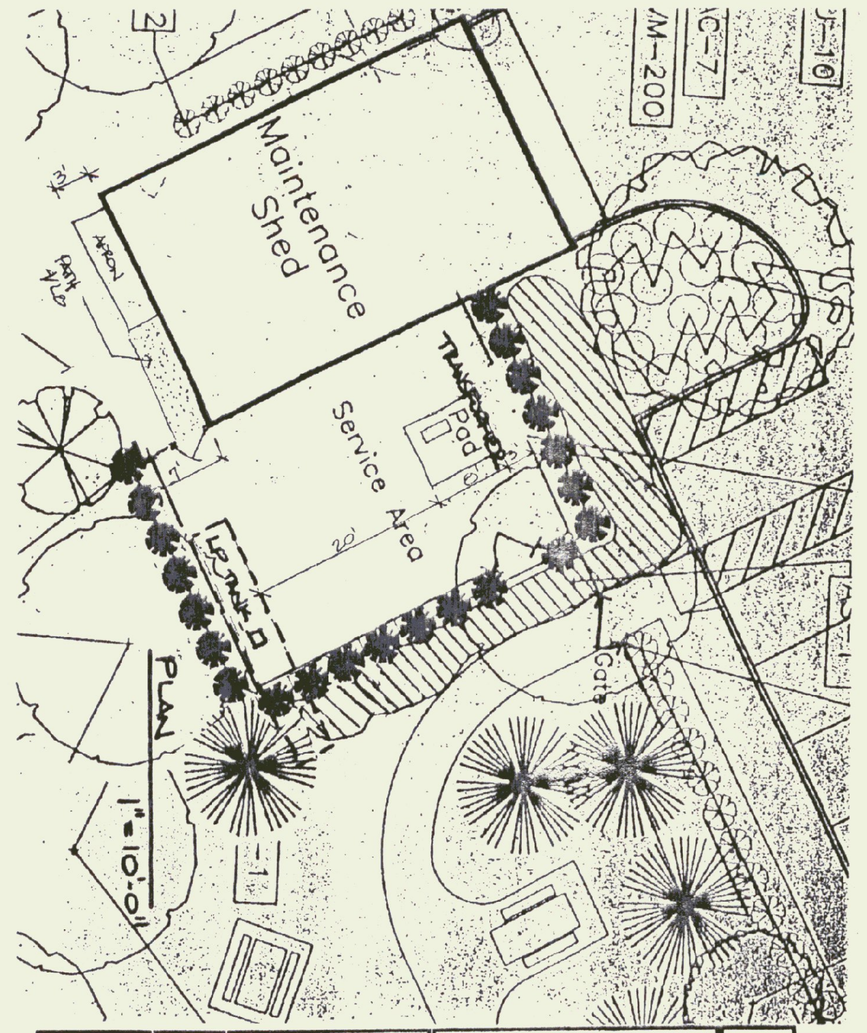

CS-7 | SOUTHEAST VERMONT WELCOME CENTER GUILFORD VERMONT | SERVICE AREA REVISION | TIMOTHY D. SMITH & ASSOCIATES, P.C. OLD RAILROAD STATION NORTH BENNINGTON 802 442-8184 | P.O. BOX 158 VERMONT 05257 FAX 442-5241 | JOB NO. 99462.00 | DWN. BY | CK. BY | 7/9/98

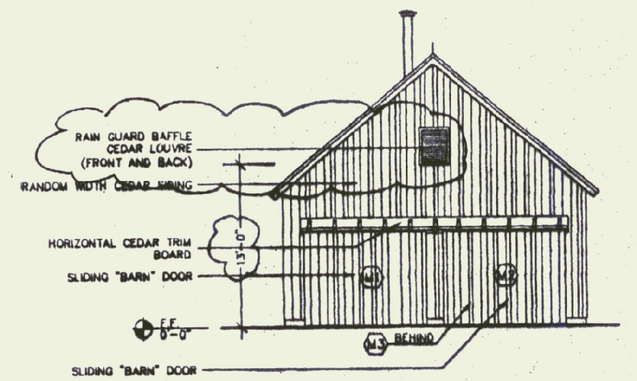

SCALE: 1/8" = 1'-0"

CS-8 | SOUTHEAST VERMONT WELCOME CENTER GUILFORD VERMONT | MAINTENANCE BUILDING LOUVRES | TIMOTHY D. SMITH & ASSOCIATES, P.C. OLD RAILROAD STATION NORTH BENNINGTON 802 442-8184 | P.O. BOX 158 VERMONT 05257 FAX 442-5241 | JOB NO. 99462.00 | DWN. BY | CK. BY | 10/5/98

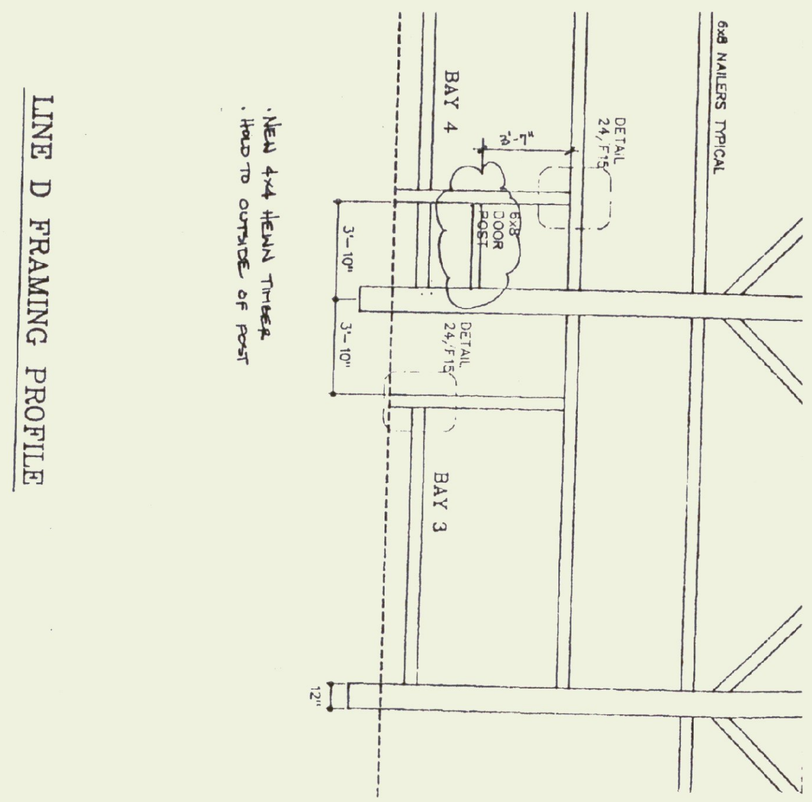

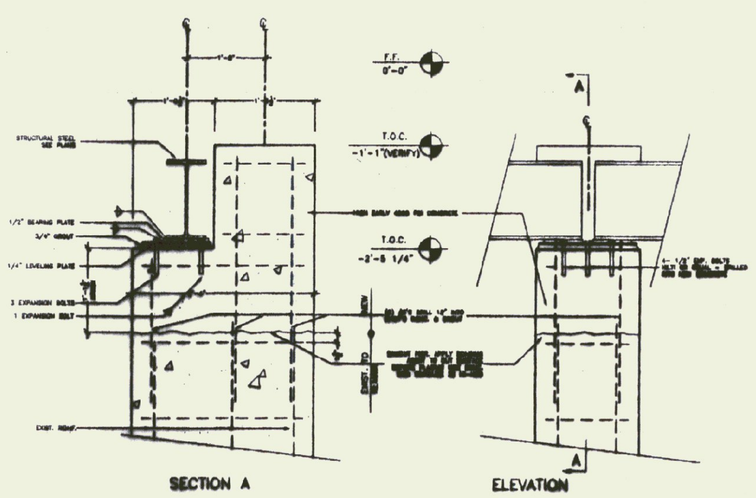

CS-9 | SOUTHEAST VERMONT WELCOME CENTER GUILFORD, VERMONT | PIER REPAIR DETAIL 1" = 1'-0" | TIMOTHY D. SMITH & ASSOCIATES, P.C. OLD RAILROAD STATION NORTH BENNINGTON 802 442-8184 | P.O. BOX 158 VERMONT 05257 FAX 442-5241 | JOB NO. 99462.00 | DWN. BY | CK. BY | 10/7/98

CS-10 | SOUTHEAST VERMONT WELCOME CENTER GUILFORD VERMONT | TIMBER FRAME - WINDOW GIRT | TIMOTHY D. SMITH & ASSOCIATES, P.C. OLD RAILROAD STATION NORTH BENNINGTON 802 442-8184 | P.O. BOX 158 VERMONT 05257 FAX 442-5241 | JOB NO. 99462.00 | DWN. BY | CK. BY | 10/7/98

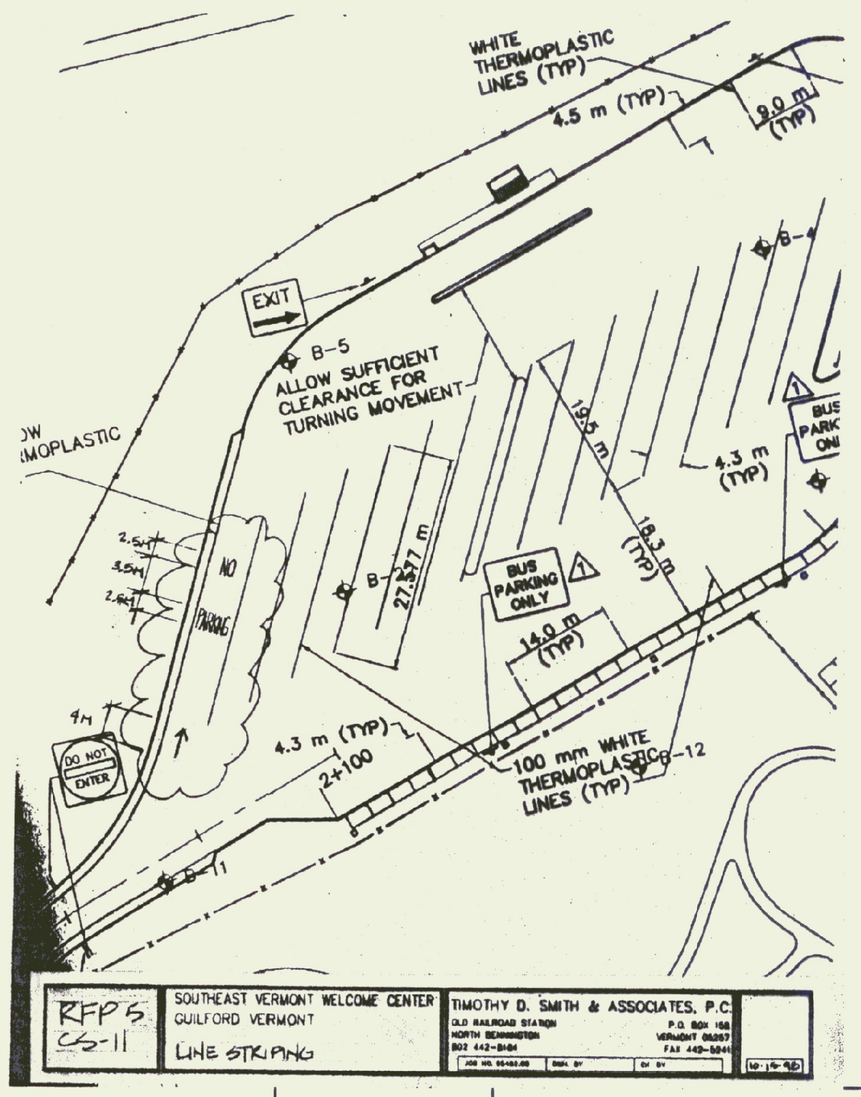

RFP 5 CS-11 | SOUTHEAST VERMONT WELCOME CENTER GUILFORD VERMONT | LINE STRIPING | TIMOTHY D. SMITH & ASSOCIATES, P.C. OLD RAILROAD STATION NORTH BENNINGTON 802 442-8184 | P.O. BOX 158 VERMONT 05257 FAX 442-5241 | JOB NO. 99462.00 | DWN. BY | CK. BY | 10/6/98

RECORD DRAWING

NO.	DATE	REVISIONS	DRWN	CHKD

TIMOTHY D. SMITH & ASSOCIATES, PC ARCHITECTS
OLD RAILROAD STATION NORTH BENNINGTON, VERMONT 05257
802-442-8184 FAX 802-442-5241

WRIGHT ENGINEERING, LTD. CIVIL ENGINEERS
198 MERCHANTS ROW - P.O. BOX 176 RUTLAND, VERMONT 05702-0176
802-775-5511 FAX 775-8915

ROBT W. HALL CONSULTING ENGINEERS, INC.
540 MEADOW STREET EXTENSION, STE. 2 AGAWAM, MASSACHUSETTS 01001-0062
413-789-0960 FAX 789-3295

T.J. BOYLE AND ASSOCIATES LANDSCAPE ARCHITECTS
361 COLLEGE STREET BURLINGTON, VERMONT 05401
802-658-3555 FAX 863-1562

PROJECT NO.IM 091-1 (30)
SOUTHEAST VERMONT WELCOME CENTER
GUILFORD, VERMONT

SHEET TITLE: DIMENSION CLARIFICATION

DSGN BY:
DRWN BY:
CHKD BY:
CHKD BY:

STATE OF VERMONT
AGENCY OF ADMINISTRATION
DEPARTMENT OF
BUILDINGS & GENERAL SERVICES

DATE: 3-14-2000 SHEET NO._____OF_____SHEETS

AB 3