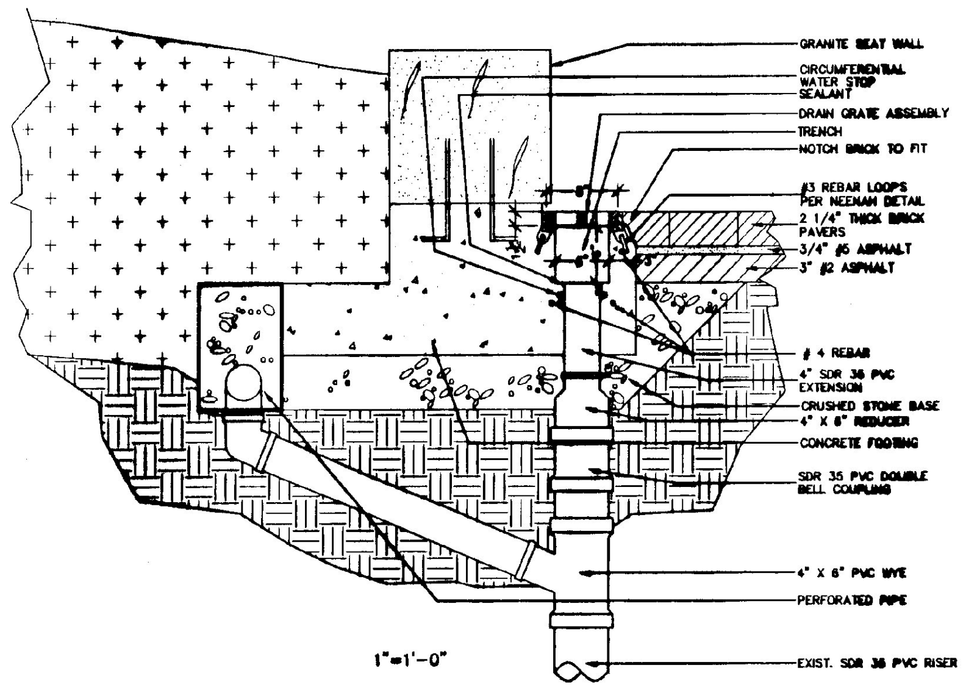

TIMOTHY D. SMITH & ASSOCIATES, P.C.
P.O. BOX 158
OLD RAILROAD STATION
NORTH BENNINGTON, VERMONT 05257
802 442-8184 FAX 442-5241

SOUTHEAST VERMONT WELCOME CENTER
GUILFORD VERMONT

TRENCH DRAIN SECTION

CS-12

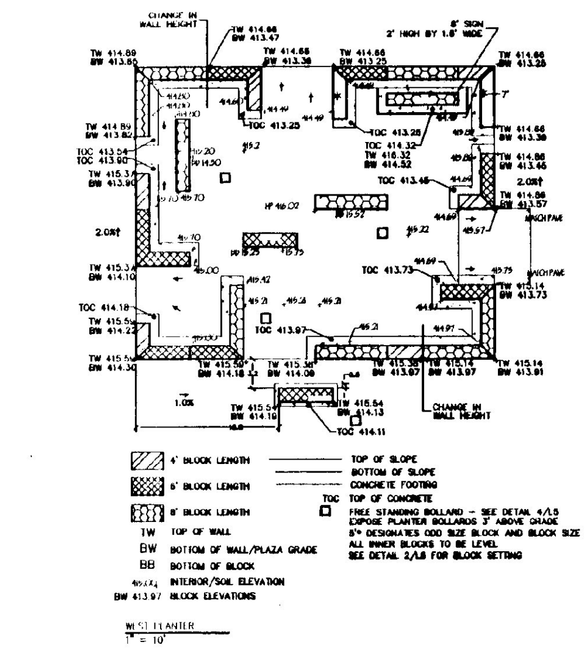

CS-13a REVISED

SOUTHEAST VERMONT WELCOME CENTER
GUILFORD VERMONT
SEATWALL MODIFICATIONS

TIMOTHY D. SMITH & ASSOCIATES, P.C.
OLD RAILROAD STATION P.O. BOX 158
NORTH BENNINGTON VERMONT 05257
802 442-8184 FAX 442-5241

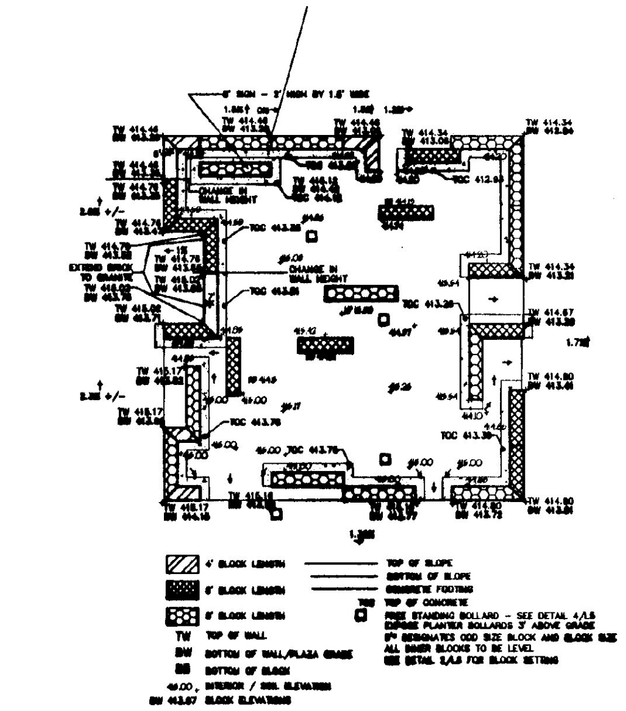

CS-13b REVISED

SOUTHEAST VERMONT WELCOME CENTER
GUILFORD VERMONT
SEATWALL MODIFICATIONS

TIMOTHY D. SMITH & ASSOCIATES, P.C.
OLD RAILROAD STATION P.O. BOX 158
NORTH BENNINGTON VERMONT 05257
802 442-8184 FAX 442-5241

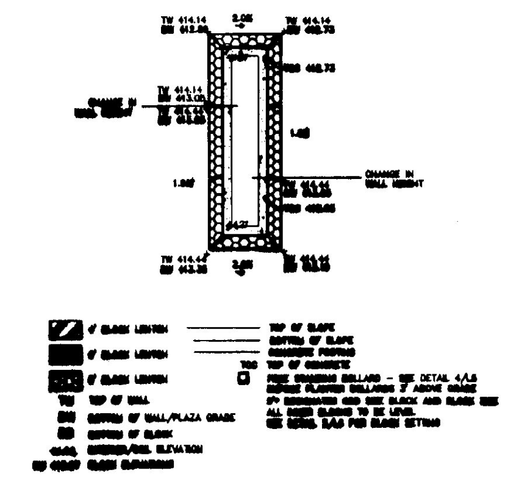
CHANGE IN WALL HEIGHT
