



CS-16 SOUTHEAST VERMONT WELCOME CENTER
GUILFORD VERMONT
PLAZA GRADING REVISIONS

TIMOTHY D. SMITH & ASSOCIATES, P.C.
P.O. BOX 158
NORTH BENNINGTON
VERMONT 05257
802-442-8184 FAX 802-442-5241

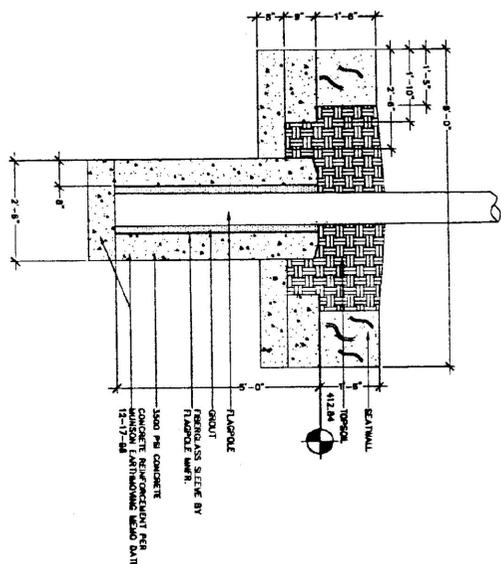


CS-17 SOUTHEAST VERMONT WELCOME CENTER
GUILFORD VERMONT
FLAGPOLE INSTALLATION

TIMOTHY D. SMITH & ASSOCIATES, P.C.
P.O. BOX 158
NORTH BENNINGTON
VERMONT 05257
802-442-8184 FAX 802-442-5241

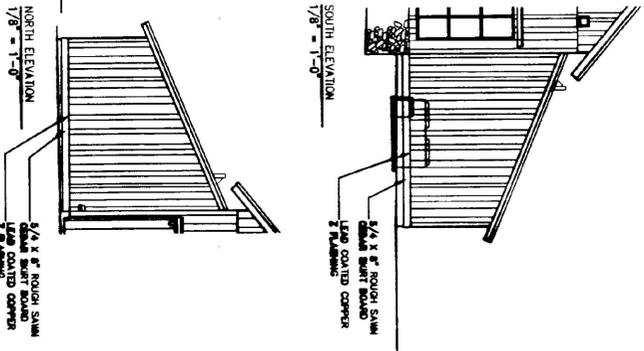


CS-18B SOUTHEAST VERMONT WELCOME CENTER
GUILFORD VERMONT
EAST WING SKIRT BOARD TRIM

TIMOTHY D. SMITH & ASSOCIATES, P.C.
P.O. BOX 158
NORTH BENNINGTON
VERMONT 05257
802-442-8184 FAX 802-442-5241

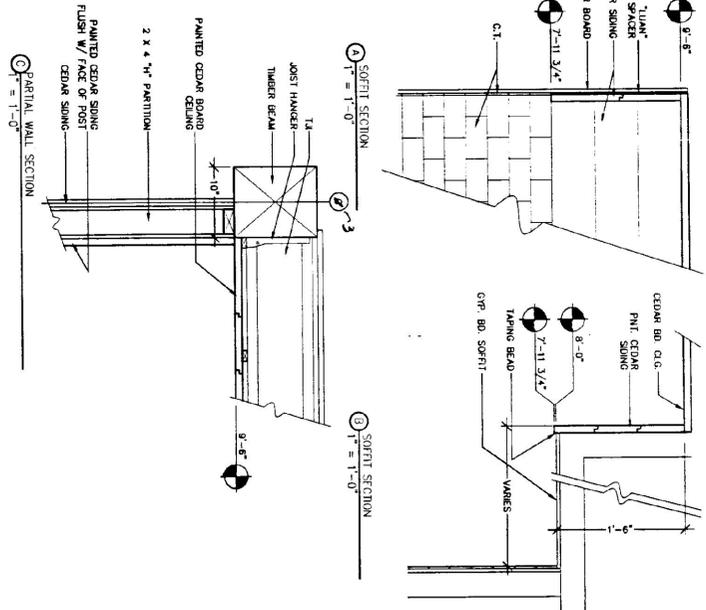


CS-20A SOUTHEAST VERMONT WELCOME CENTER
GUILFORD VERMONT
SOFFIT CLARIFICATIONS

TIMOTHY D. SMITH & ASSOCIATES, P.C.
P.O. BOX 158
NORTH BENNINGTON
VERMONT 05257
802-442-8184 FAX 802-442-5241

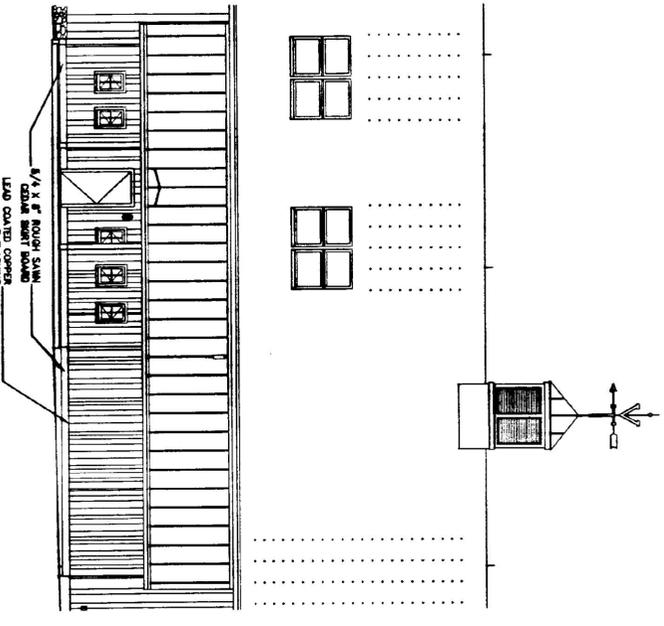

CS-18A SOUTHEAST VERMONT WELCOME CENTER
GUILFORD VERMONT
EAST WING SKIRT BOARD TRIM

TIMOTHY D. SMITH & ASSOCIATES, P.C.
P.O. BOX 158
NORTH BENNINGTON
VERMONT 05257
802-442-8184 FAX 802-442-5241

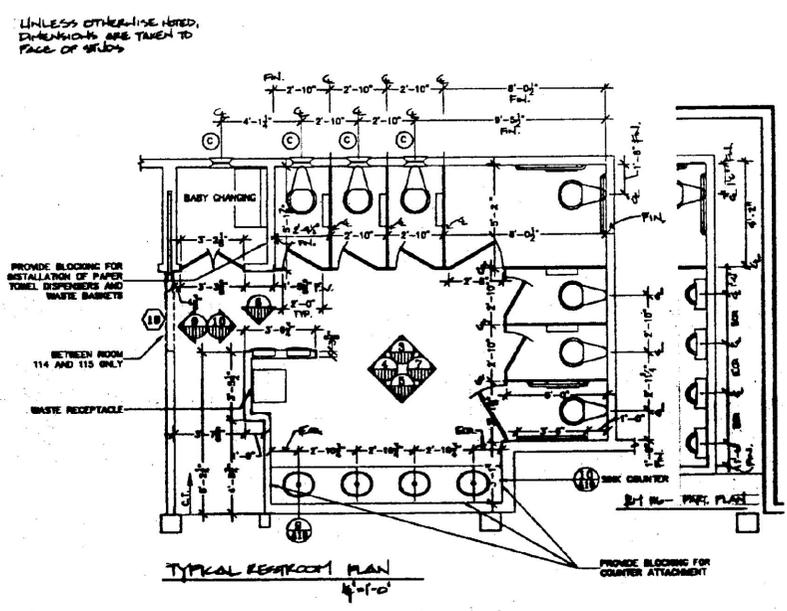

CS-19 SOUTHEAST VERMONT WELCOME CENTER
GUILFORD VERMONT
TOILET ROOM DIMENSIONAL CLARIFICATIONS

TIMOTHY D. SMITH & ASSOCIATES, P.C.
P.O. BOX 158
NORTH BENNINGTON
VERMONT 05257
802-442-8184 FAX 802-442-5241

RECORD
DRAWING

TIMOTHY D. SMITH & ASSOCIATES, PC ARCHITECTS
OLD RAILROAD STATION
802-442-8184

WRIGHT ENGINEERING, LTD.
CIVIL ENGINEERS
100 WASHINGTON ST. SUITE 200
BURLINGTON, VERMONT 05401
802-778-3811

ROBT W. HALL
CONSULTING ENGINEERS, INC.
50 W. COLLEGE STREET
BURLINGTON, VERMONT 05401
802-686-3535

T.J. BOYLE AND ASSOCIATES
LANDSCAPE ARCHITECTS
50 W. COLLEGE STREET
BURLINGTON, VERMONT 05401
802-686-3535

PROJECT NO. IM 091-1 (30)
SOUTHEAST VERMONT WELCOME CENTER
GUILFORD, VERMONT

STATE OF VERMONT
AGENCY OF ADMINISTRATION
DEPARTMENT OF
BUILDINGS & GENERAL SERVICES

NO. DATE REVISIONS DRAWN CHKD

SHEET TITLE: DIMENSION CLARIFICATION

CHGD BY: DATE: 3-14-2000 SHEET NO. OF SHEETS

AB