



NOTE:
 DETAIL FOR INSTALLATION OF
 THIS WINDOW SHALL BE AS SHOWN
 UNLESS OTHERWISE NOTED
 FROM SHOP DRAWINGS AND
 SPECIFICATIONS.


CS-23
 SOUTHEAST VERMONT WELCOME CENTER
 GUILFORD VERMONT
 WINDOW SILL CLARIFICATION
 TIMOTHY D. SMITH & ASSOCIATES, P.C.

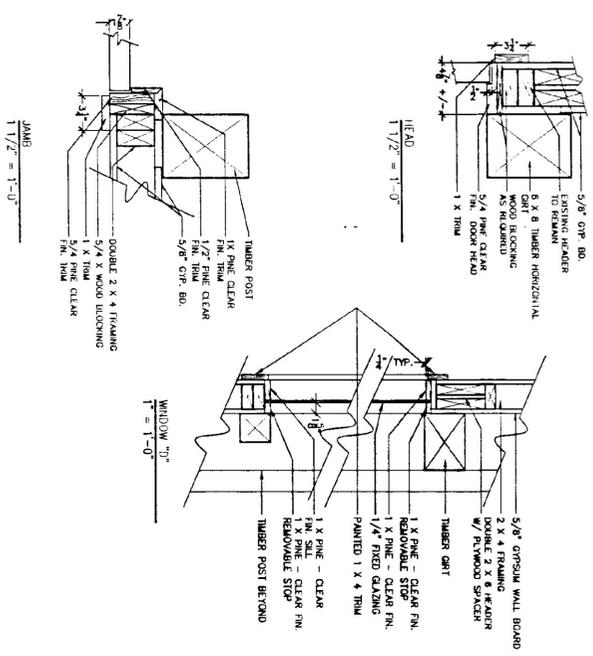


CS-24
 SOUTHEAST VERMONT WELCOME CENTER
 GUILFORD VERMONT
 WINDOW #9 HEAD AND JAMB REVISION
 TIMOTHY D. SMITH & ASSOCIATES, P.C.

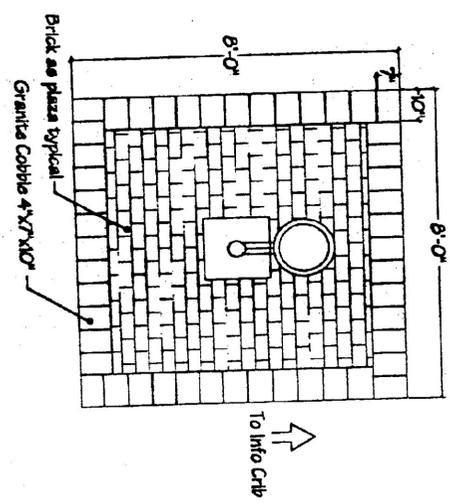


CS-25
 SOUTHEAST VERMONT WELCOME CENTER
 GUILFORD VERMONT
 REVERSE DRINKING FOUNTAIN PAVING
 TIMOTHY D. SMITH & ASSOCIATES, P.C.

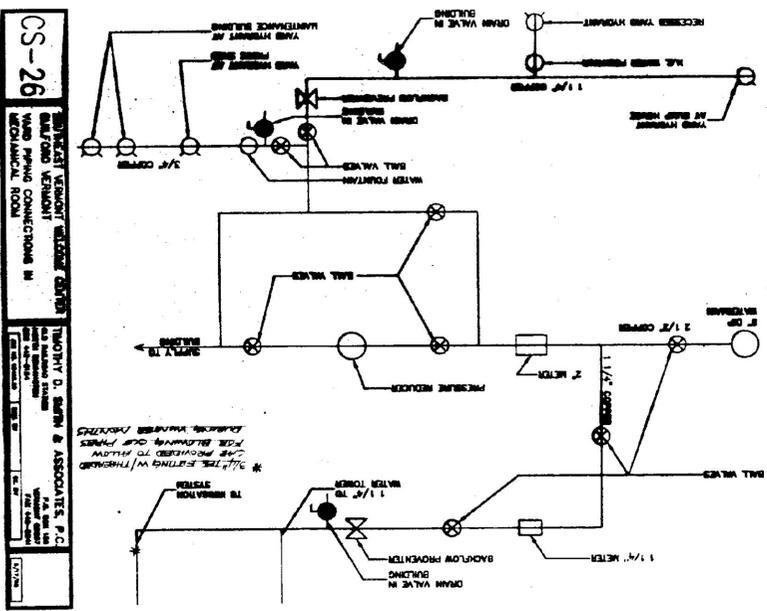

CS-26
 SOUTHEAST VERMONT WELCOME CENTER
 GUILFORD VERMONT
 TIMOTHY D. SMITH & ASSOCIATES, P.C.

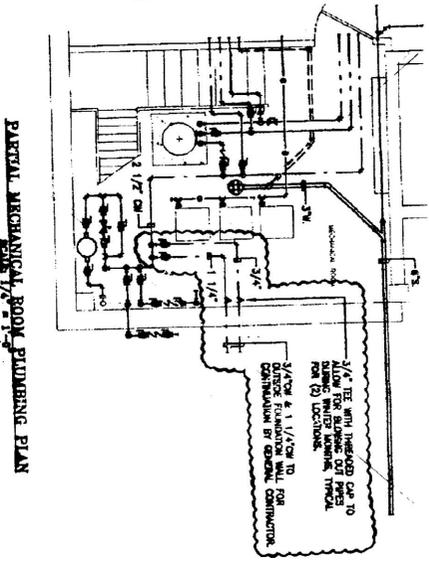

CS-Plr
 SOUTHEAST VERMONT WELCOME CENTER
 GUILFORD VERMONT
 WATER SERVICE REVISIONS
 TIMOTHY D. SMITH & ASSOCIATES, P.C.

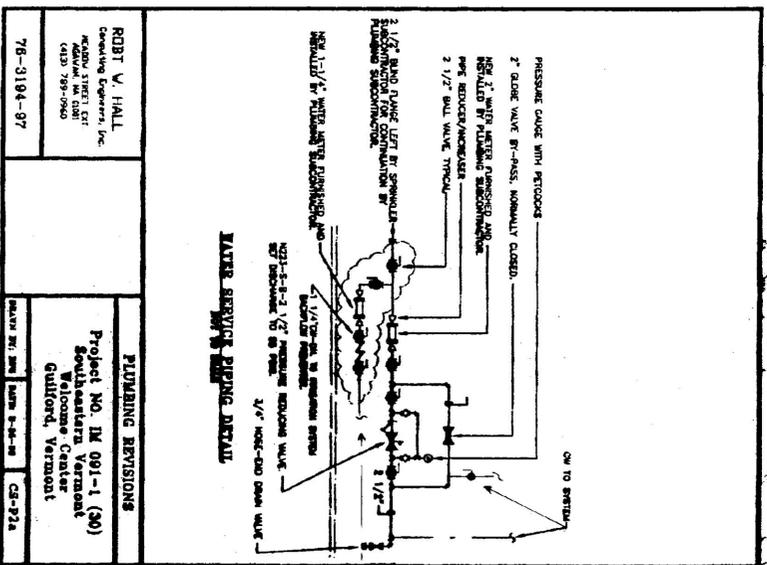

 SOUTHEAST VERMONT WELCOME CENTER
 GUILFORD VERMONT
 WATER SERVICE PIPING DETAIL
 ROBT W. HALL
 Consulting Engineers, Inc.

RECORD
 DRAWING

NO.	DATE	REVISIONS	DRWN	CHKD
PROJECT NO. JM 091-1 (30) SOUTHEAST VERMONT WELCOME CENTER GUILFORD, VERMONT				
SHEET TITLE: DIMENSION CLARIFICATION				
DSGN BY: _____ DRWN BY: _____ CHD BY: _____				
DATE: 3-14-2000 SHEET NO. _____ OF _____ SHEETS				
STATE OF VERMONT AGENCY OF ADMINISTRATION DEPARTMENT OF BUILDINGS & GENERAL SERVICES				