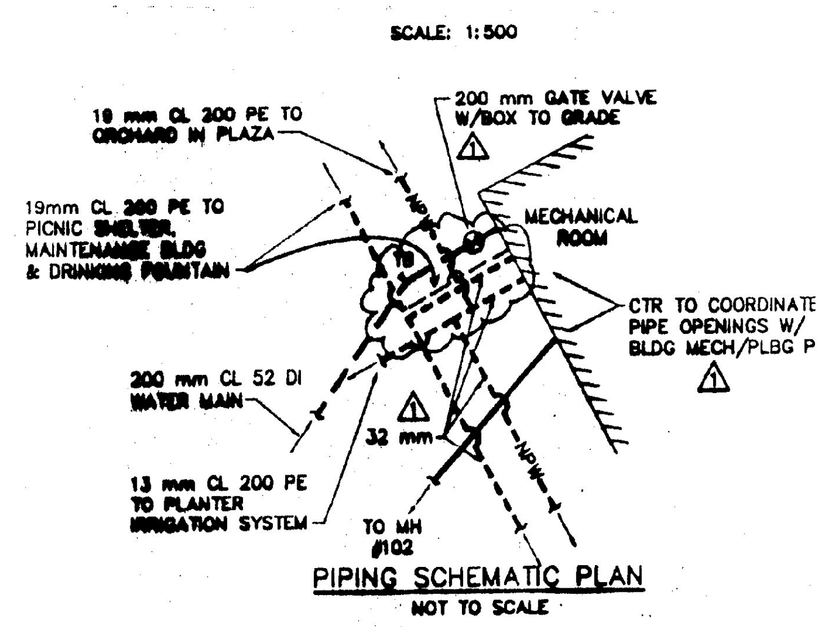

PIPING SCHEMATIC PLAN

NOT TO SCALE

CS-C1	SOUTHEAST VERMONT WELCOME CENTER GUILFORD VERMONT PIPING SCHEMATIC PLAN REVISION	TIMOTHY D. SMITH & ASSOCIATES, P.C. OLD RAILROAD STATION NORTH BENNINGTON 802 442-8184 P.O. BOX 158 VERMONT 05257 FAX 442-5241	

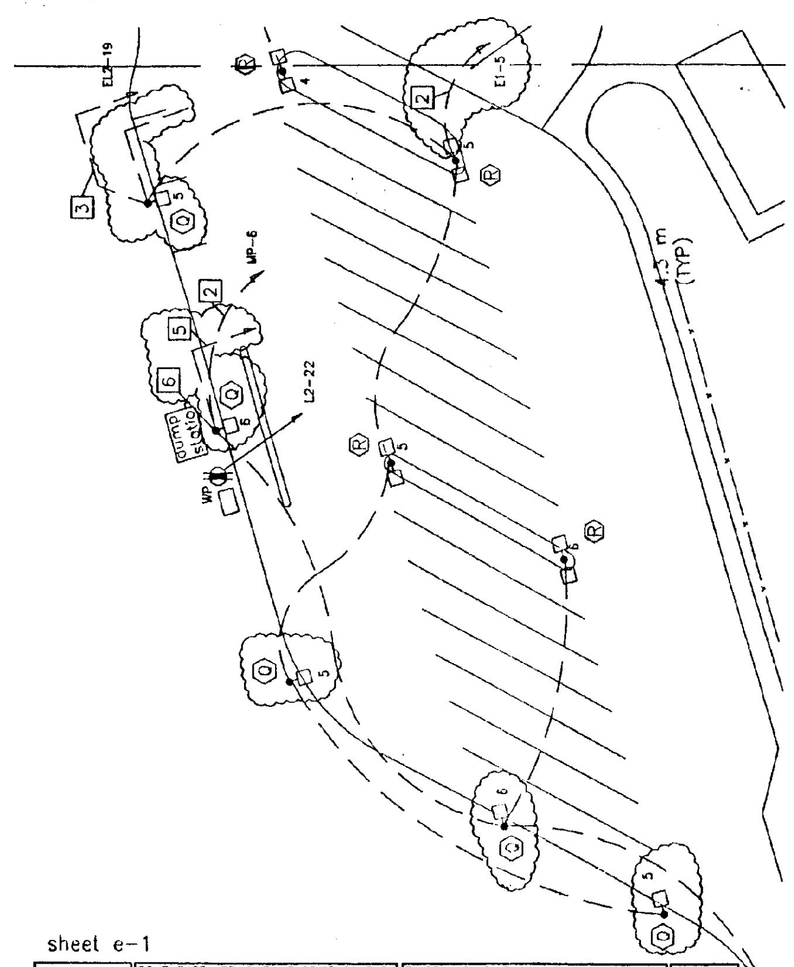

sheet e-1

	SOUTHEAST VERMONT WELCOME CENTER GUILFORD VERMONT SERVICE ENTRANCE & EMERGENCY GENERATOR CHANGE	TIMOTHY D. SMITH & ASSOCIATES, PC OLD RAILROAD STATION NORTH BENNINGTON 802-442-8184 P.O. BOX 158 VERMONT 05257 FAX 802-442-5241	CSE-1

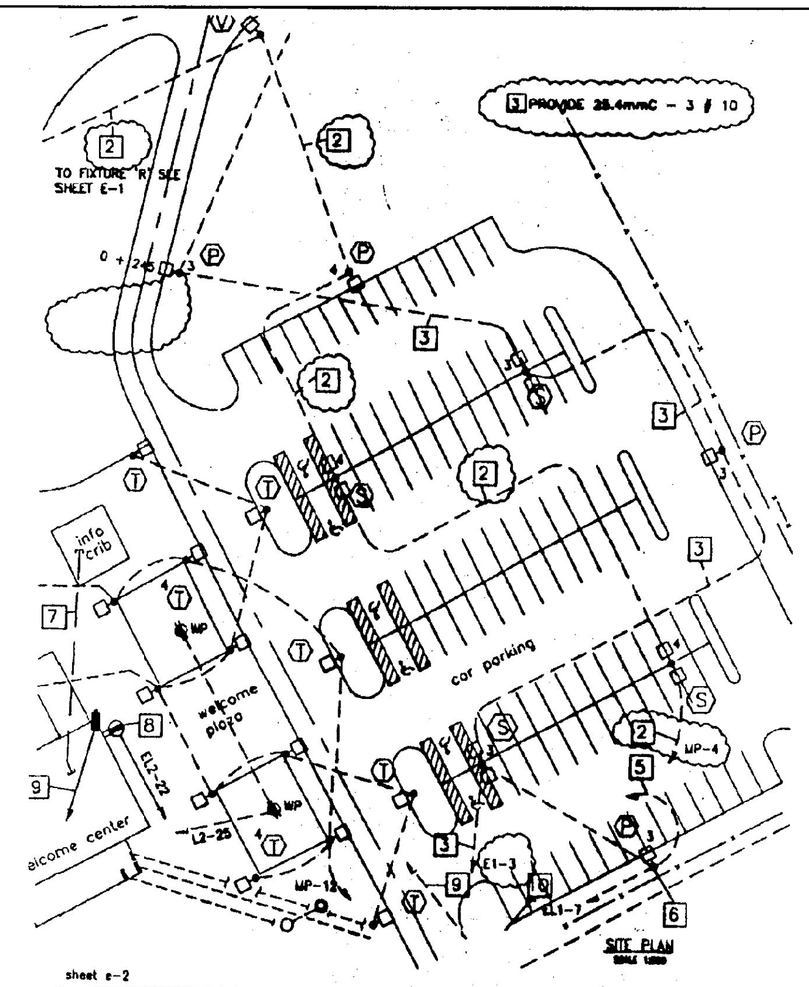

SITE PLAN

sheet e-2

	SOUTHEAST VERMONT WELCOME CENTER GUILFORD VERMONT SERVICE ENTRANCE & EMERGENCY GENERATOR CHANGE	TIMOTHY D. SMITH & ASSOCIATES, PC OLD RAILROAD STATION NORTH BENNINGTON 802-442-8184 P.O. BOX 158 VERMONT 05257 FAX 802-442-5241	CSE-2

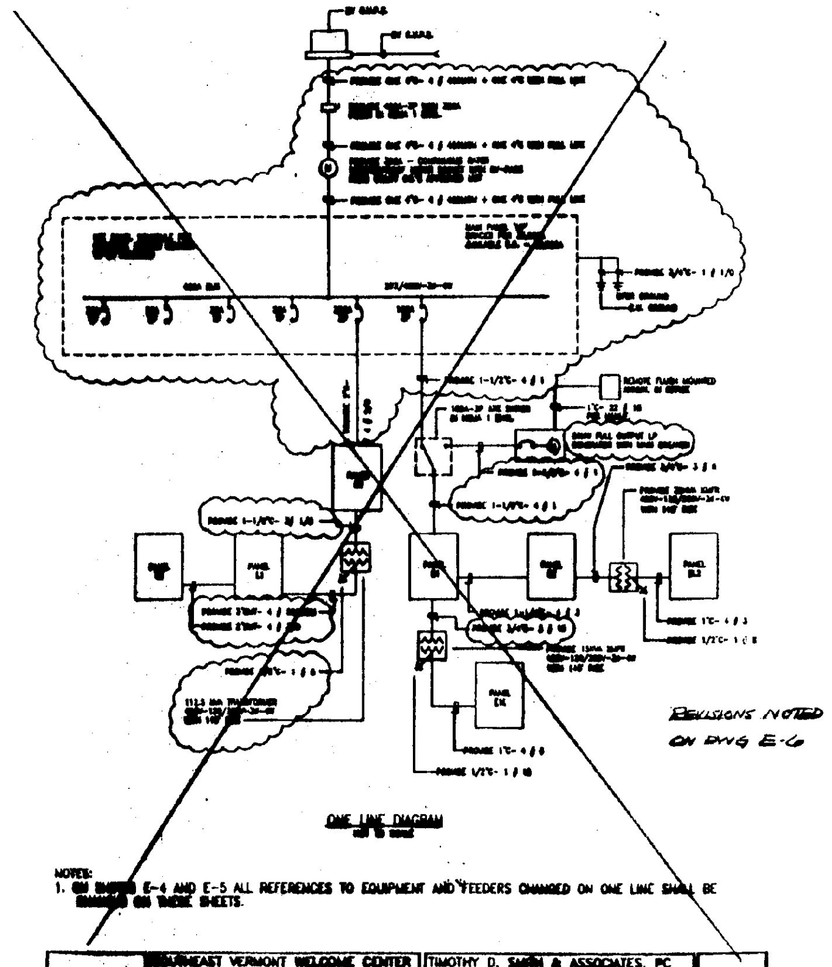

ONE LINE DIAGRAM

NOTES:
1. ON SHEETS E-4 AND E-5 ALL REFERENCES TO EQUIPMENT AND FEEDERS CHANGED ON ONE LINE SHALL BE CHANGED ON THESE SHEETS.

	SOUTHEAST VERMONT WELCOME CENTER GUILFORD VERMONT SERVICE ENTRANCE & EMERGENCY GENERATOR CHANGE	TIMOTHY D. SMITH & ASSOCIATES, PC	CSE-3

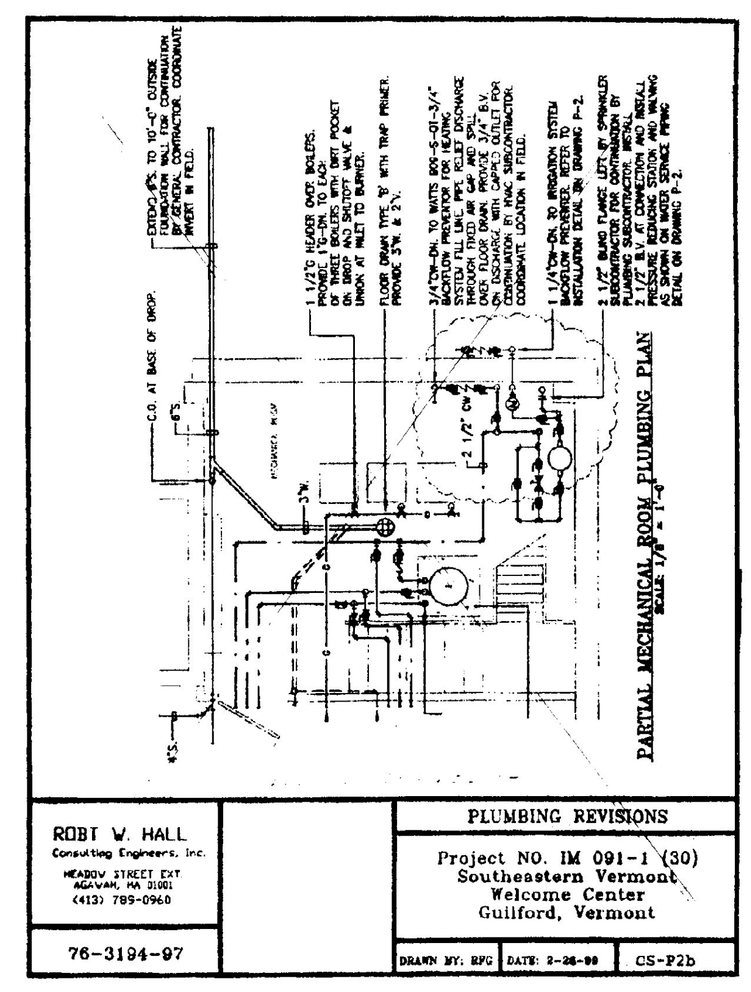

PARTIAL MECHANICAL ROOM PLUMBING PLAN
SCALE: 1/4" = 1'-0"

ROBT W. HALL Consulting Engineers, Inc. MEADOW STREET EXT AGAWAM, MA 01001 (413) 789-0960		PLUMBING REVISIONS Project NO. IM 091-1 (30) Southeastern Vermont Welcome Center Guilford, Vermont	
76-3194-97		DRAWN BY: RFG DATE: 2-26-99	CS-P2b

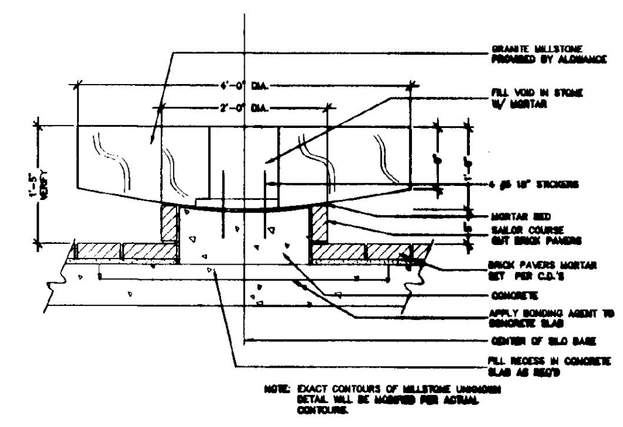

SECTION
1" = 1'-0"

AS-2	SOUTHEAST VERMONT WELCOME CENTER GUILFORD VERMONT SILO BASE MILLSTONE INSTALLATION SECTION	TIMOTHY D. SMITH & ASSOCIATES, P.C. OLD RAILROAD STATION NORTH BENNINGTON 802-442-8184 P.O. BOX 158 VERMONT 05257 FAX 442-5241	

RECORD DRAWING

NO.	DATE	REVISIONS	DRWN	CHKD

TIMOTHY D. SMITH & ASSOCIATES, PC ARCHITECTS
OLD RAILROAD STATION — NORTH BENNINGTON, VERMONT 05257
802-442-8184 — FAX 802-442-5241

WRIGHT ENGINEERING, LTD. — CIVIL ENGINEERS — 188 MERCHANTS ROW - P.O. BOX 178, RUTLAND, VERMONT 05702-0178, 802-775-2511, FAX 775-8915
ROBT W. HALL — CONSULTING ENGINEERS, INC. — 540 MEADOW STREET EXTENSION, STE. 2, AGAWAM, MASSACHUSETTS 01001-0002, 413-789-0960, FAX 789-3295
T.J. BOYLE AND ASSOCIATES — LANDSCAPE ARCHITECTS — 301 COLLEGE STREET, BURLINGTON, VERMONT 05401, 802-658-3555, FAX 863-1562

PROJECT NO.IM 091-1 (30)
SOUTHEAST VERMONT WELCOME CENTER
GUILFORD, VERMONT

SHEET TITLE: DIMENSION CLARIFICATION

DSGN BY:
DRWN BY:
CHKD BY:
CHKD BY:

STATE OF VERMONT
AGENCY OF ADMINISTRATION
DEPARTMENT OF
BUILDINGS & GENERAL SERVICES

DATE: 3-14-2000 SHEET NO._____OF_____SHEETS

AB 8