FOOTING CORRECTIVE MEASURES FOR WESTERN WALL OF WELCOME CENTER BUILDING (BATHROOM "SHED")

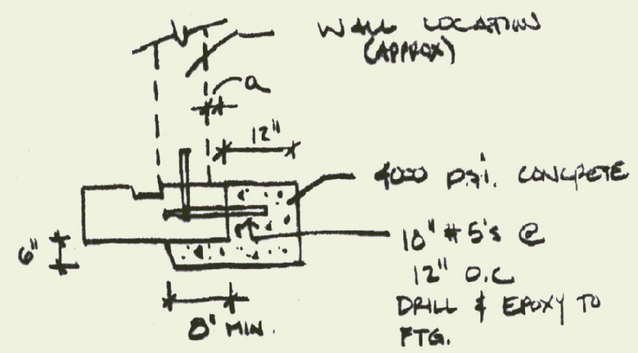

EXTEND FOOTING EXTENSION FOR ALL PARTS OF WALL WHERE "a" < 6"

SK-2

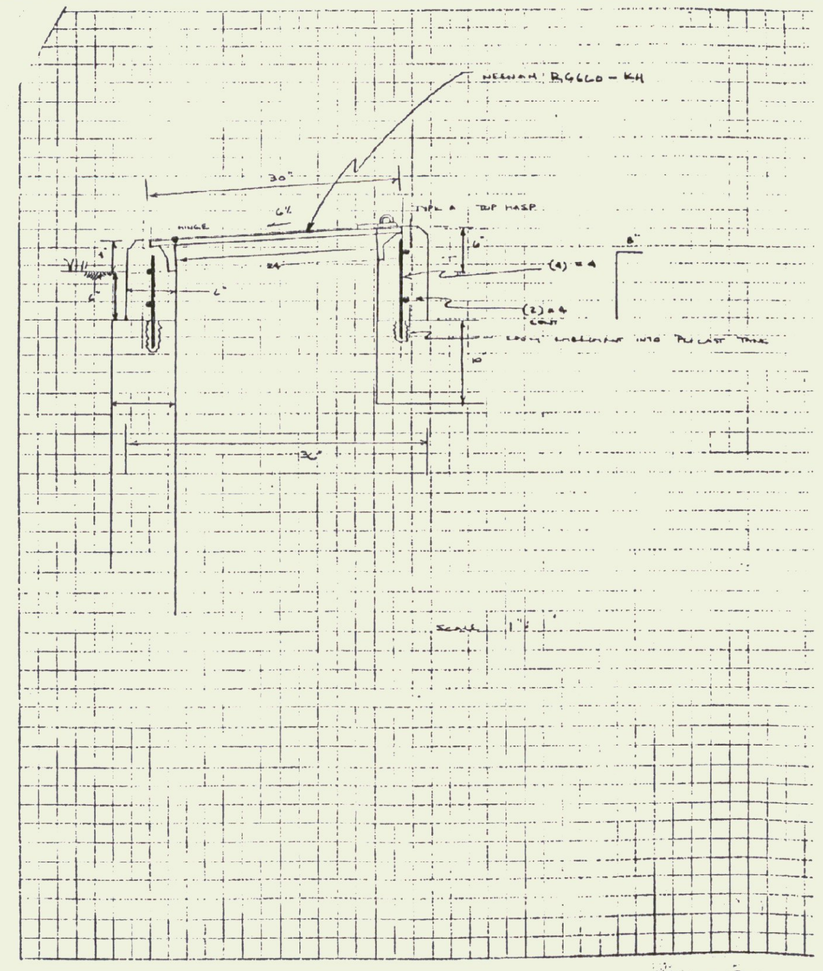

JOB# 1501 JOB NAME 1501 C.O. #3 DATE 7/21/98
SUBJECT: JOIST SIZE THRU BRASS WATER BY ES PAGE 1 OF 1

SK-3

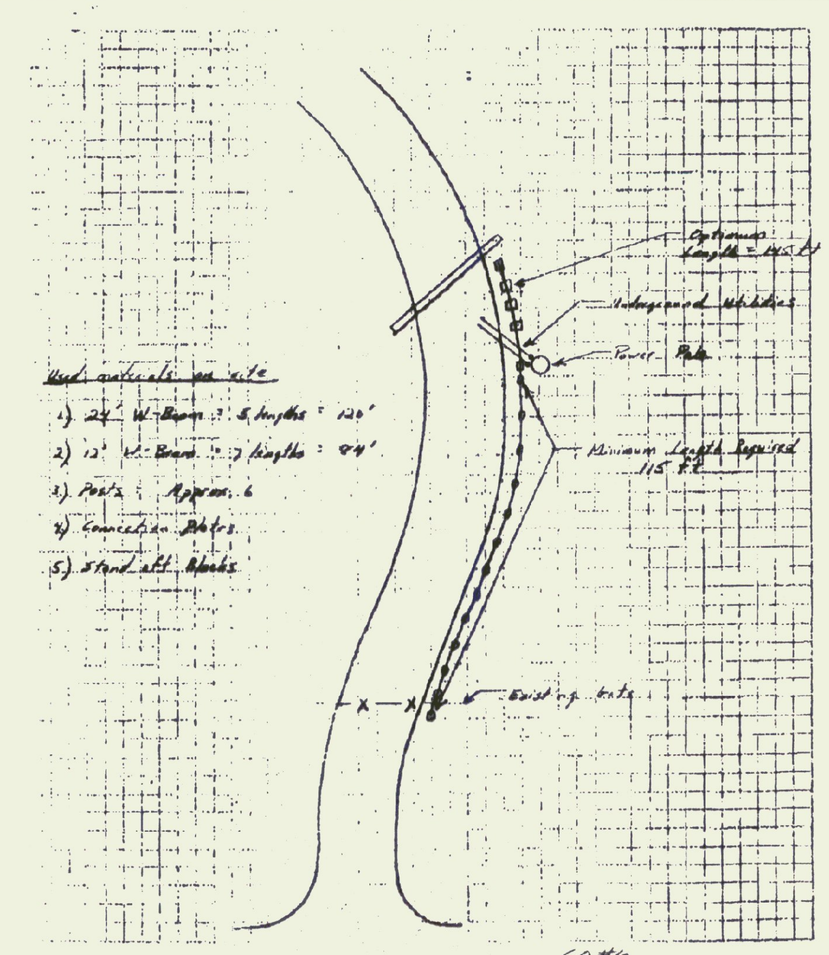

JOB# ___ JOB NAME SE Vt Welcome Cntr DATE 4/1/99
SUBJECT: Emergency Access Rd Guardrail BY ERH PAGE 2 OF 2

SK-4

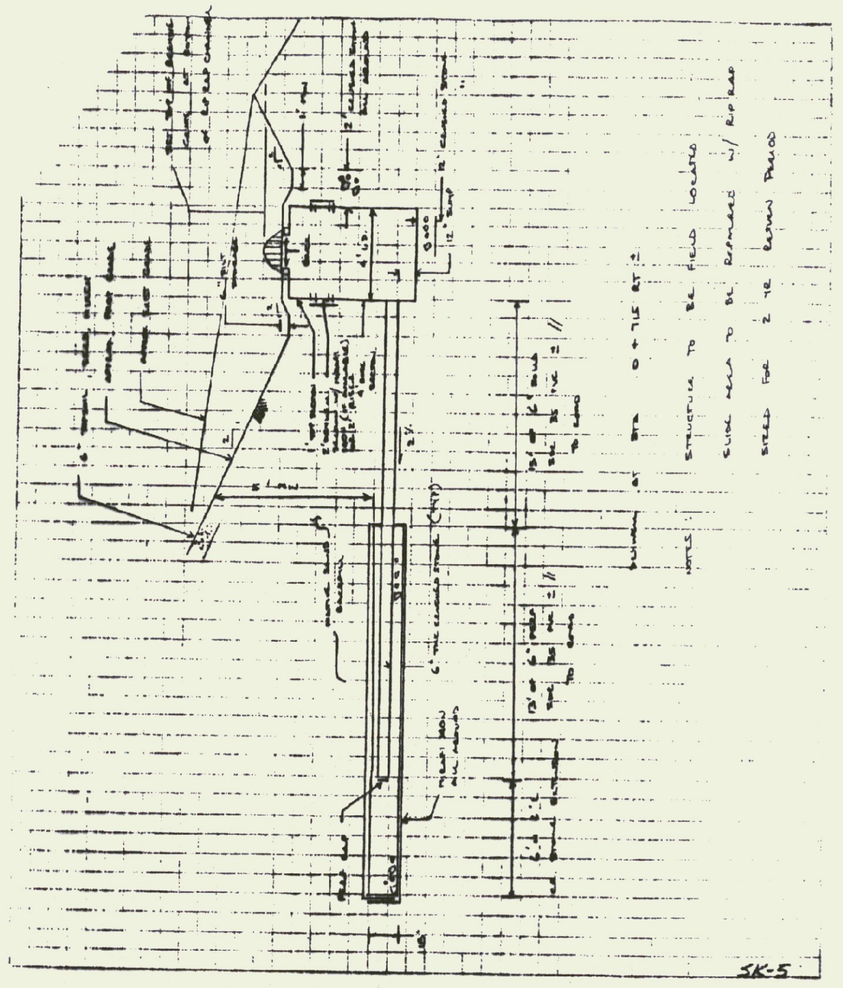

JOB NAME 1501 CONT BRANCH C.O. #6 DATE 5/7/99
SUBJECT: BRANCH @ 0+715 RT BY KS PAGE 1 OF 1

SK-5

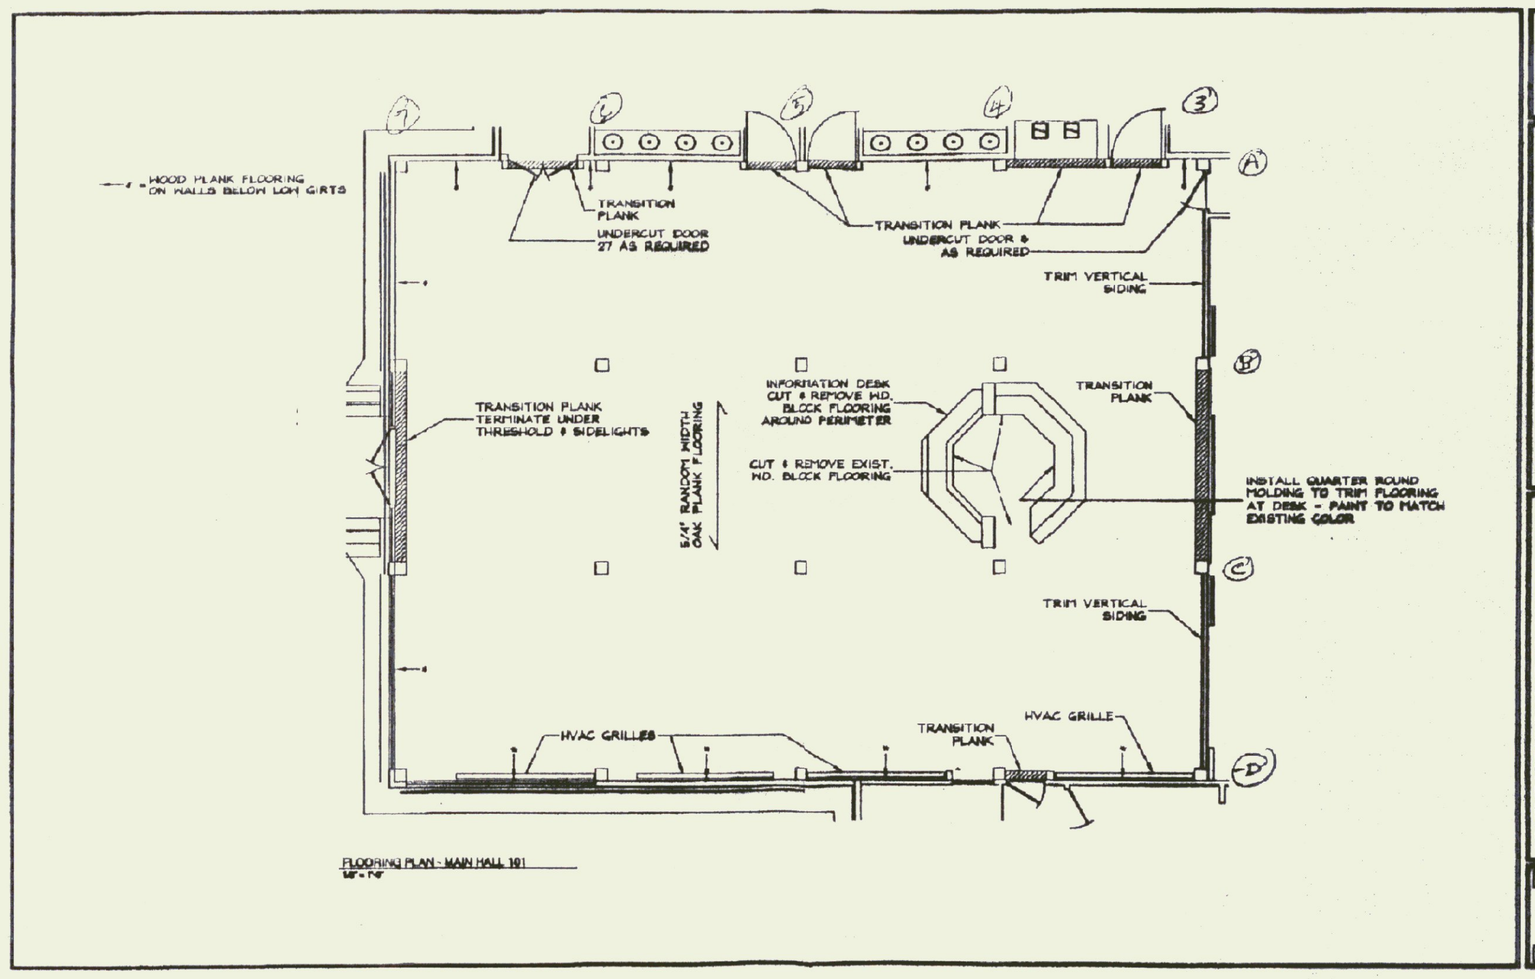

FLOORING PLAN - MAIN HALL 101
1/4" = 1'-0"

TIMOTHY D. SMITH & ASSOCIATES, P.C.
OLD RAILROAD STATION
NORTH BENNINGTON, VERMONT 05257
802-442-8184 FAX 802-442-5241
DATE 5/28/99
DR. BY: CK. BY: JOB NO.

SOUTHEAST VERMONT WELCOME CENTER
GUILFORD, VERMONT
NEW OAK PLANK FLOORING PLAN
MAIN HALL 101

A1

RECORD DRAWING

NO.	DATE	REVISIONS	DRWN	CHKD

TIMOTHY D. SMITH & ASSOCIATES, PC ARCHITECTS
OLD RAILROAD STATION NORTH BENNINGTON, VERMONT 05257
802-442-8184 FAX 802-442-5241

WRIGHT ENGINEERING, LTD. CIVIL ENGINEERS
128 MERCHANTS ROW - P.O. BOX 176 RUTLAND, VERMONT 05702-0176
802-775-2511 FAX 775-8915

ROBT W. HALL CONSULTING ENGINEERS, INC.
540 MEADOW STREET EXTENSION, STE. 2 AGAWAM, MASSACHUSETTS 01001-0062
413-789-0860 FAX 789-3295

T.J. BOYLE AND ASSOCIATES LANDSCAPE ARCHITECTS
301 COLLEGE STREET BURLINGTON, VERMONT 05401
802-658-3555 FAX 863-1562

PROJECT NO.IM 091-1 (30)
SOUTHEAST VERMONT WELCOME CENTER
GUILFORD, VERMONT

SHEET TITLE: DIMENSION CLARIFICATION

DSGN BY:
DRWN BY:
CHKD BY:
CHKD BY:

STATE OF VERMONT
AGENCY OF ADMINISTRATION
DEPARTMENT OF
BUILDINGS & GENERAL SERVICES

DATE: 3-14-2000 SHEET NO. ____ OF ____ SHEETS

AB 9