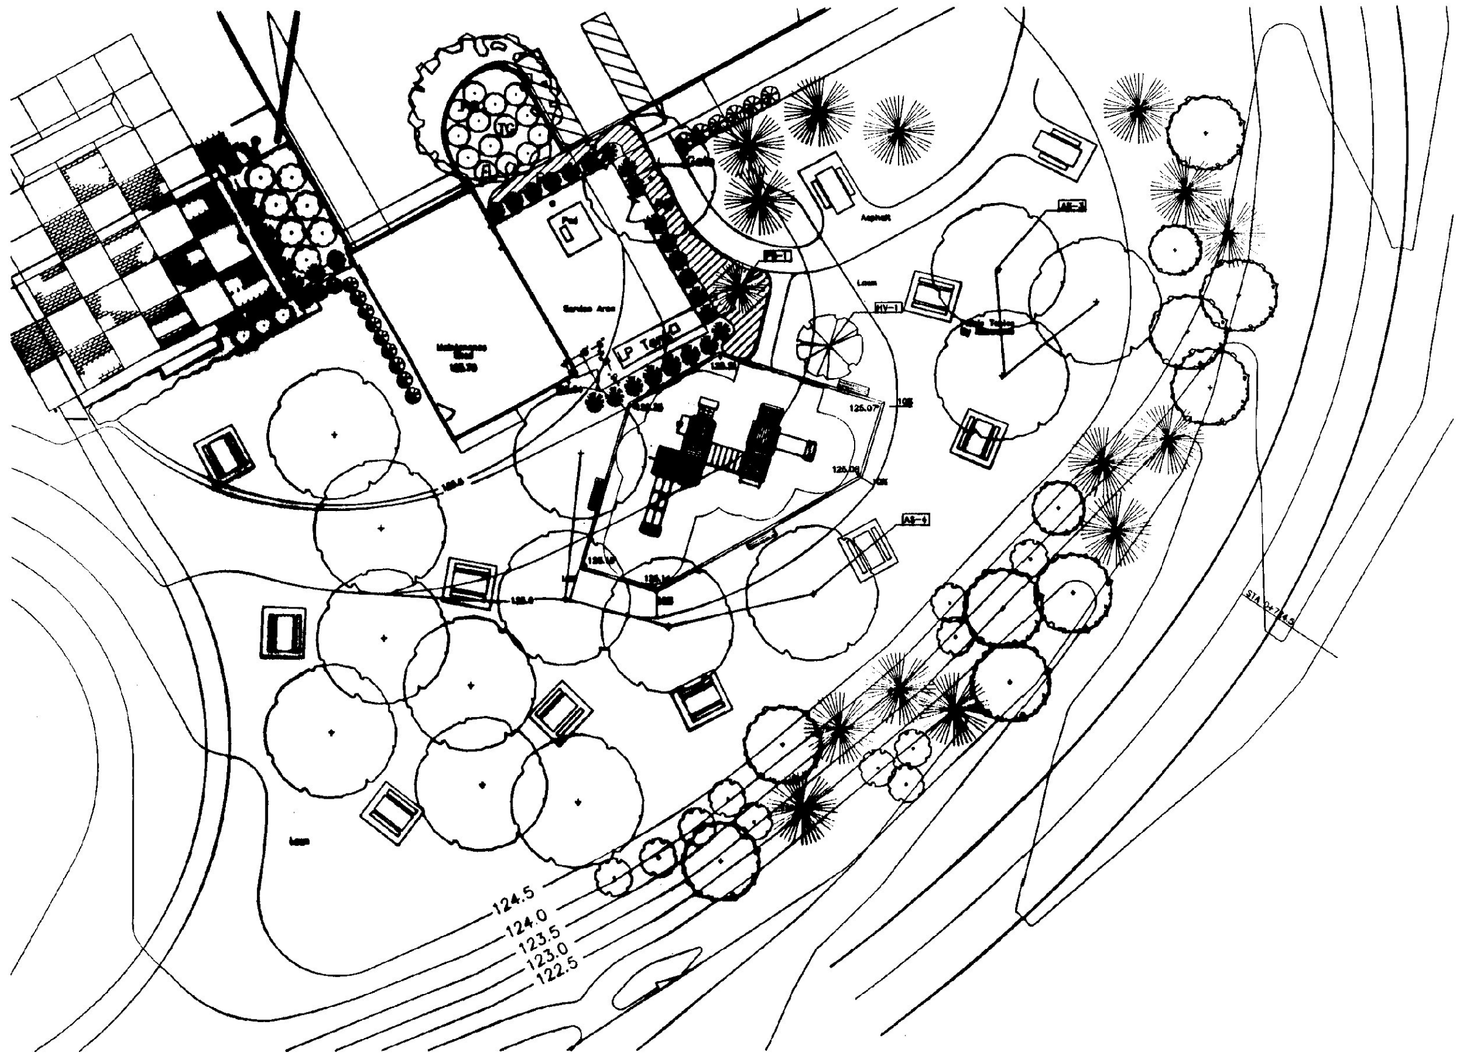

TIMOTHY D. SMITH & ASSOCIATES, P.C.
OLD RAILROAD STATION
NORTH BENNINGTON
802 442-8184
FAX 442-5241
JOB NO. 9446.02 | DWN. BY | CK. BY | DATE 10/1/96

SOUTHEAST VERMONT WELCOME CENTER
GUILFORD VERMONT
PICNIC AREA AND PLAYGROUND PLAN

PG-1

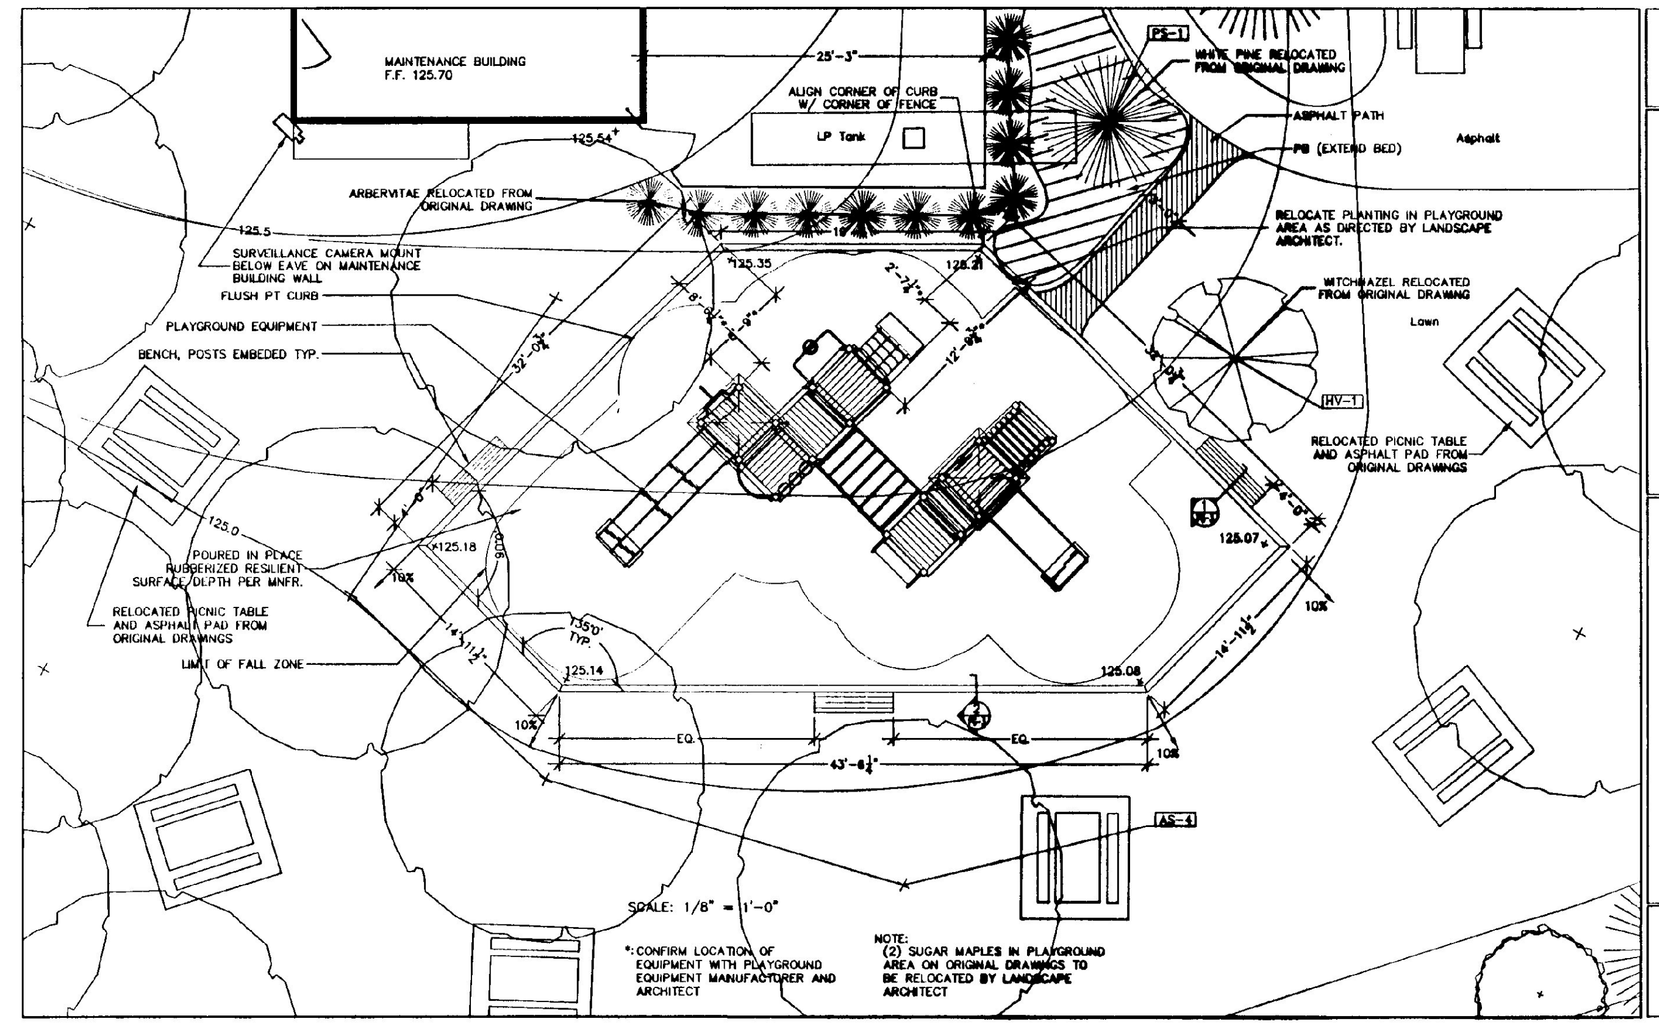

TIMOTHY D. SMITH & ASSOCIATES, P.C.
OLD RAILROAD STATION
NORTH BENNINGTON
802 442-8184
FAX 442-5241
JOB NO. | DWN. BY | CK. BY | DATE 10/1/96

SOUTHEAST VERMONT WELCOME CENTER
GUILFORD VERMONT
PLAYGROUND PLAN

PG-2

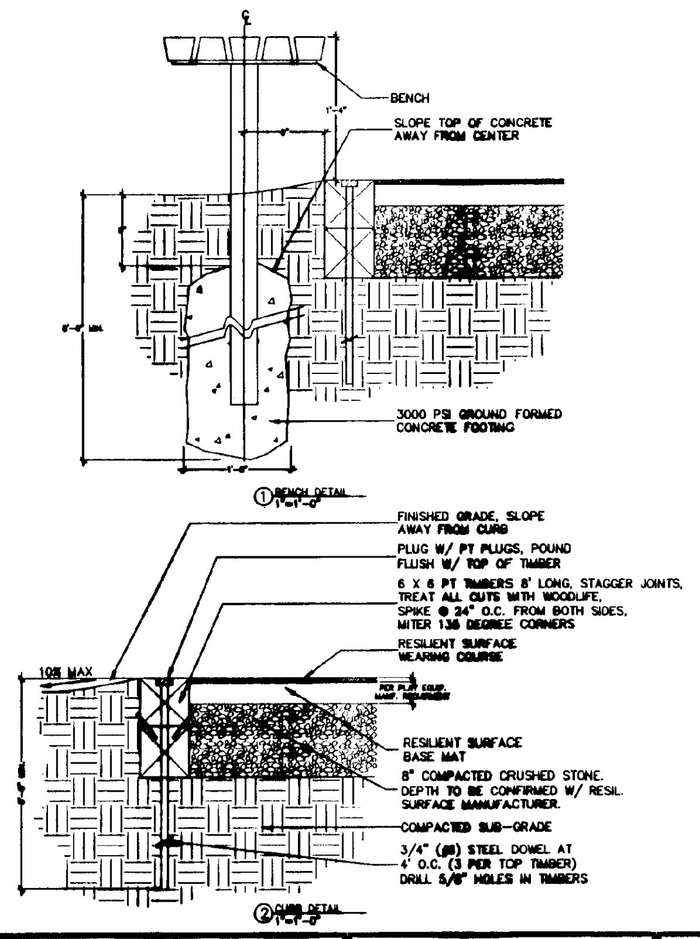

PG-3

SOUTHEAST VERMONT WELCOME CENTER
GUILFORD, VERMONT
PLAYGROUND CURB AND BENCH DETAILS

TIMOTHY D. SMITH & ASSOCIATES, P.C.
OLD RAILROAD STATION
NORTH BENNINGTON
802 442-8184
P.O. BOX 158
VERMONT 05257
FAX 442-5241
JOB NO. | DRN BY | CK. BY | DATE 10/1/96

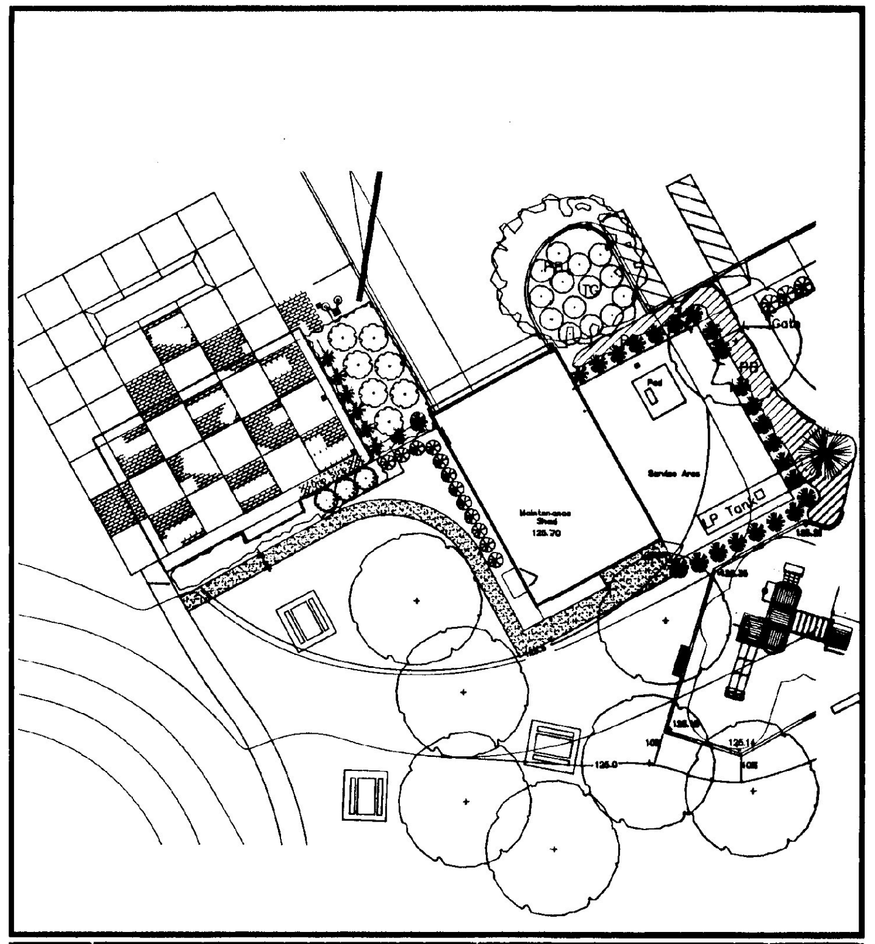

SK-6

SOUTHEAST VERMONT WELCOME CENTER
GUILFORD, VERMONT
MAINTENANCE PATH

TIMOTHY D. SMITH & ASSOCIATES, P.C.
OLD RAILROAD STATION
NORTH BENNINGTON
802 442-8184
P.O. BOX 158
VERMONT 05257
FAX 442-5241
JOB NO. | DWN BY | CK. BY | DATE 5/18/2000

RECORD DRAWING

NO.	DATE	REVISIONS	DRWN	CHKD

TIMOTHY D. SMITH & ASSOCIATES, PC ARCHITECTS
OLD RAILROAD STATION — NORTH BENNINGTON, VERMONT 05257
802-442-8184 — FAX 802-442-5241

WRIGHT ENGINEERING, LTD. — CIVIL ENGINEERS — 120 MERCHANTS ROW - P.O. BOX 178, RUTLAND, VERMONT 05702-0178, 802-775-2511, FAX 775-8915
ROBT W. HALL — CONSULTING ENGINEERS, INC. — 540 MEADOW STREET EXTENSION, STE. 2, AGAWAM, MASSACHUSETTS 01001-0002, 413-789-0860, FAX 789-3296
T.J. BOYLE AND ASSOCIATES — LANDSCAPE ARCHITECTS — 301 COLLEGE STREET, BURLINGTON, VERMONT 05401, 802-658-3555, FAX 863-1562

PROJECT NO.IM 091-1 (30)
SOUTHEAST VERMONT WELCOME CENTER
GUILFORD, VERMONT

SHEET TITLE: DIMENSION CLARIFICATION

DSGN BY:
DRWN BY:
CHKD BY:
CHKD BY:

STATE OF VERMONT
AGENCY OF ADMINISTRATION
DEPARTMENT OF
BUILDINGS & GENERAL SERVICES

DATE: 3-14-2000 SHEET NO._____OF_____SHEETS

AB 10