






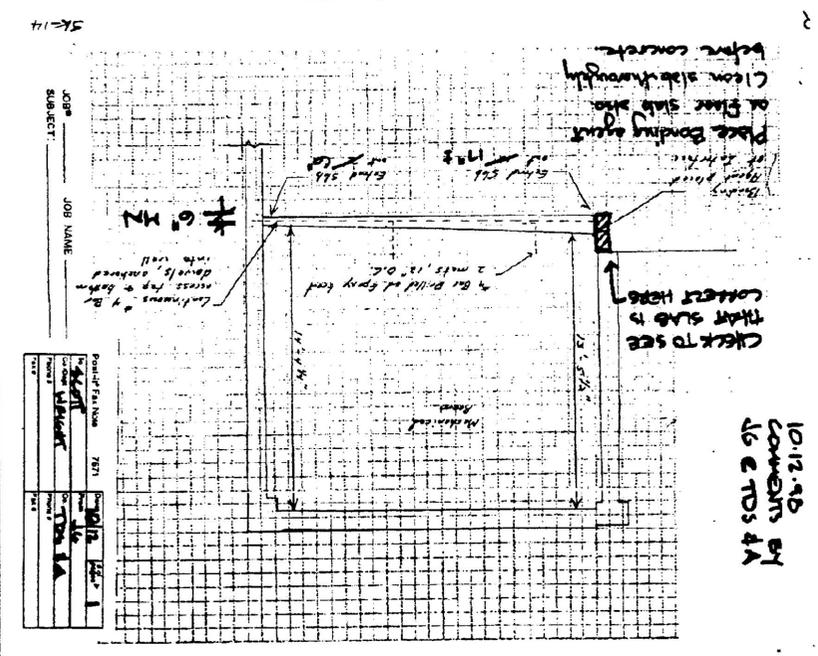


10-12-98
Comments by
JG & TDS 4A

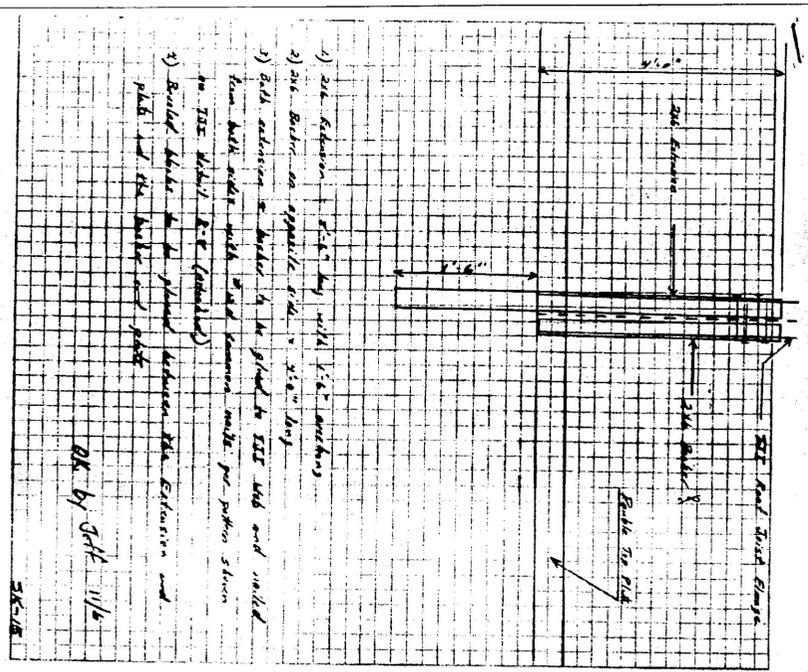

DATE: 11/1/98
PAGE: 1 OF 1

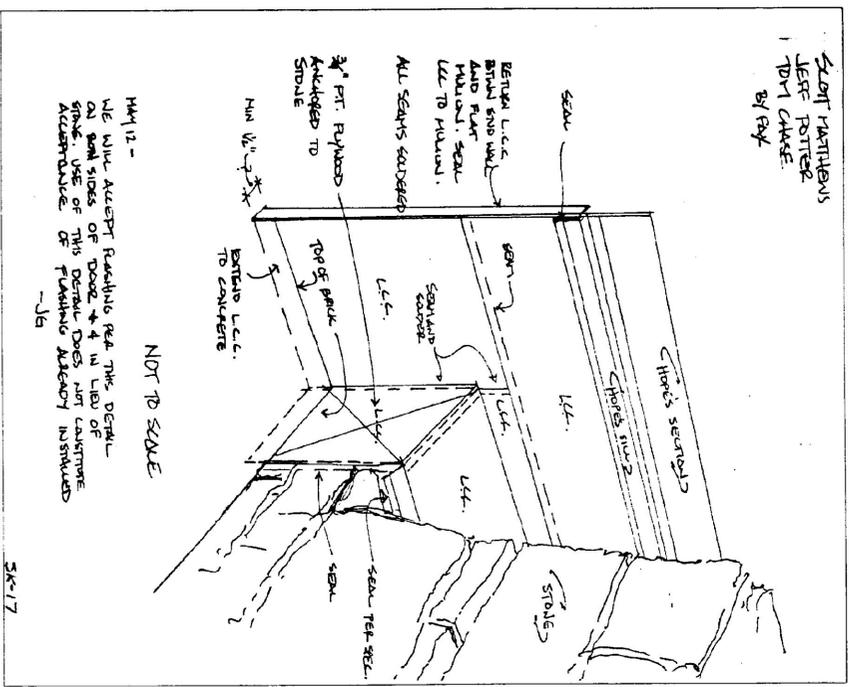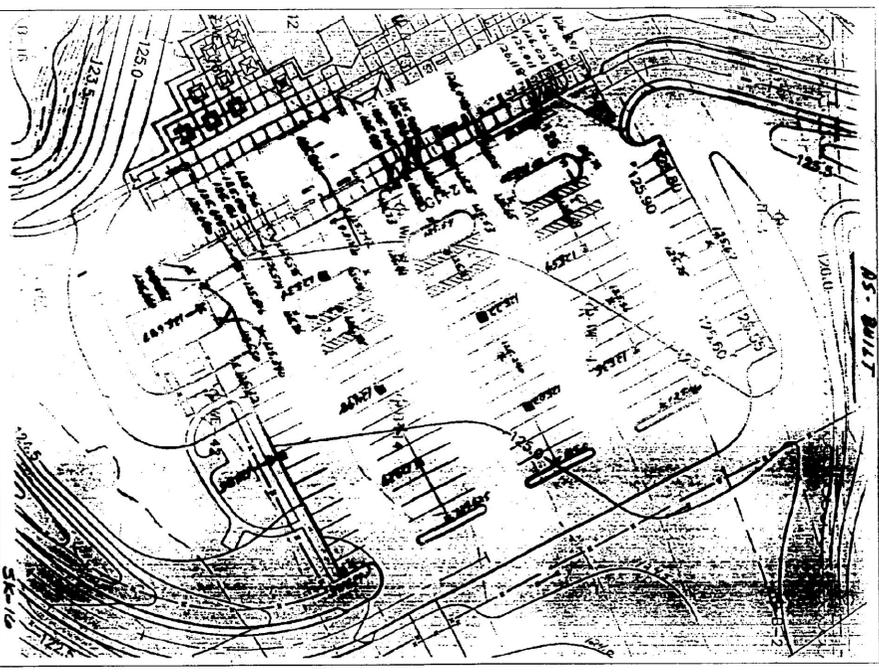


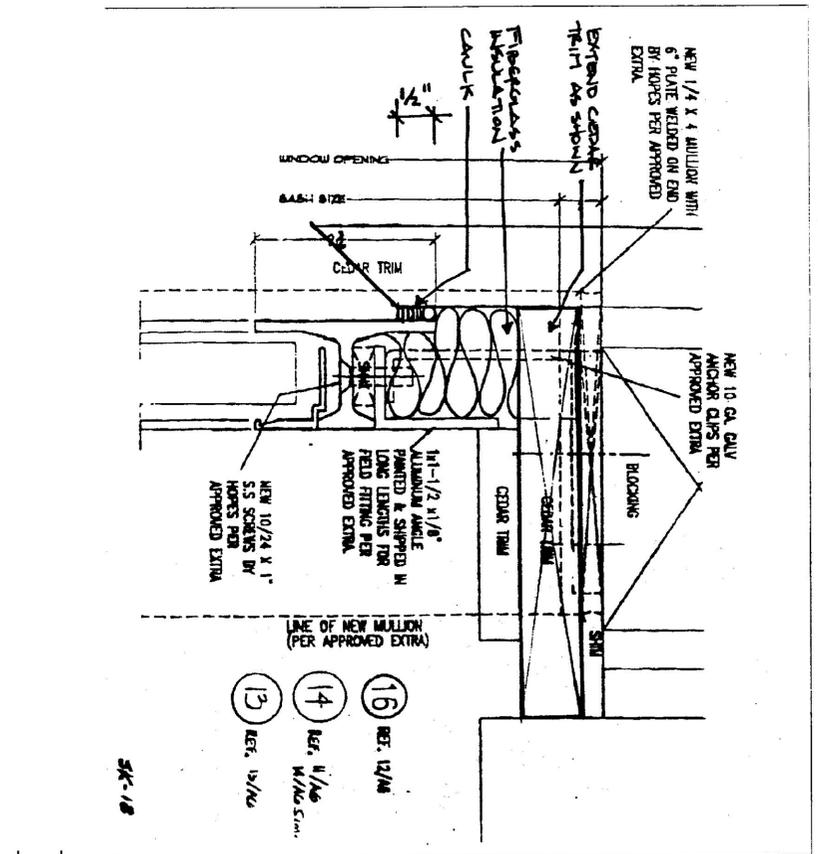

SK-18

RECORD
DRAWING

NO.	DATE	REVISIONS	DRWN CHKD
<p>TIMOTHY D. SMITH & ASSOCIATES, PC ARCHITECTS OLD RAILROAD STATION 802-442-8184</p> <p>WRIGHT ENGINEERING, LTD. CIVIL ENGINEERS 148 MERRIMACK ST. - P.O. BOX 176 WASHINGTON VERMONT 05671 802-536-8111</p> <p>ROBT W. HALL CONSULTING ENGINEERS, INC. 644 WINDMILL STREET WASHINGTON VERMONT 05671 802-536-8111</p> <p>T.J. BOYLE AND ASSOCIATES LANDSCAPE ARCHITECTS 100 COLLEGE STREET BURLINGTON VERMONT 05401 802-864-3565</p>			
<p>PROJECT NO. IM 091-1 (30) SOUTHEAST VERMONT WELCOME CENTER GUILFORD, VERMONT</p>			
SHEET TITLE:		DIMENSION CLARIFICATION	
DCSN BY:	DRWN BY:	CHKD BY:	DATE:
			3-14-2000
STATE OF VERMONT AGENCY OF ADMINISTRATION DEPARTMENT OF BUILDINGS & GENERAL SERVICES		SHEET NO. _____ OF _____ SHEETS	
AB		12	