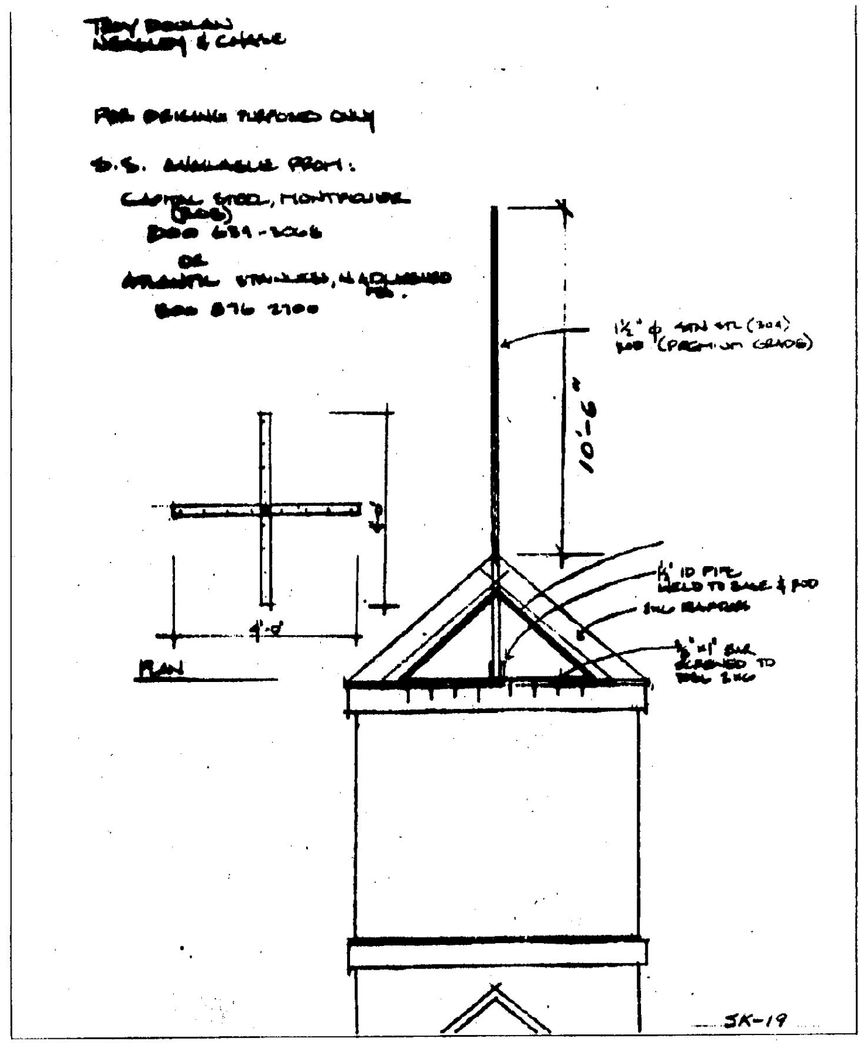

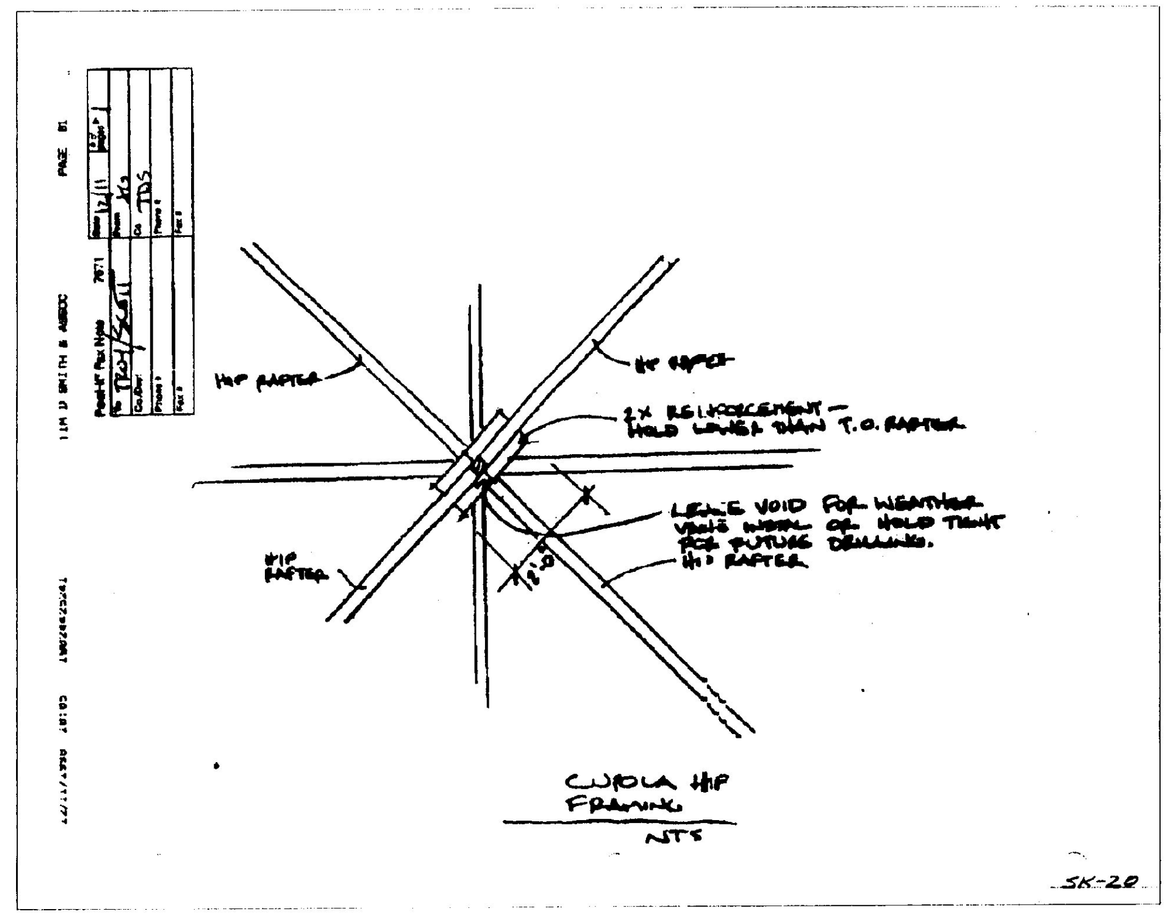

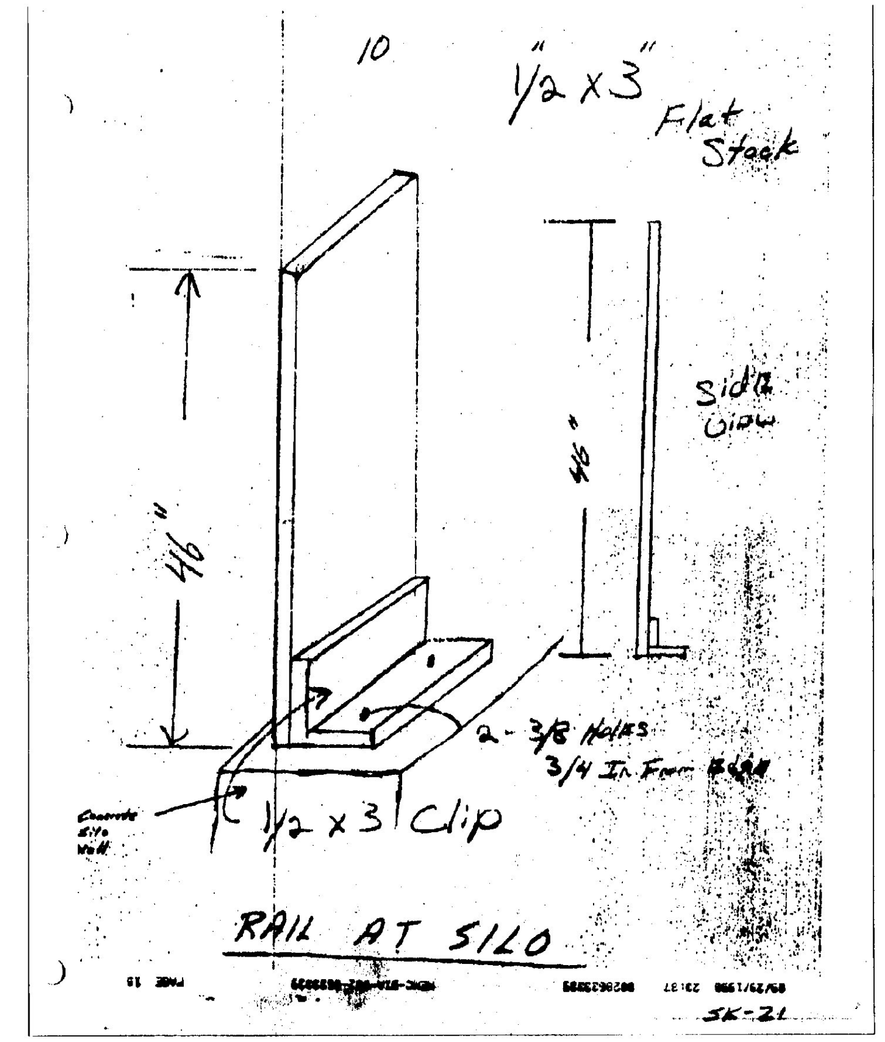

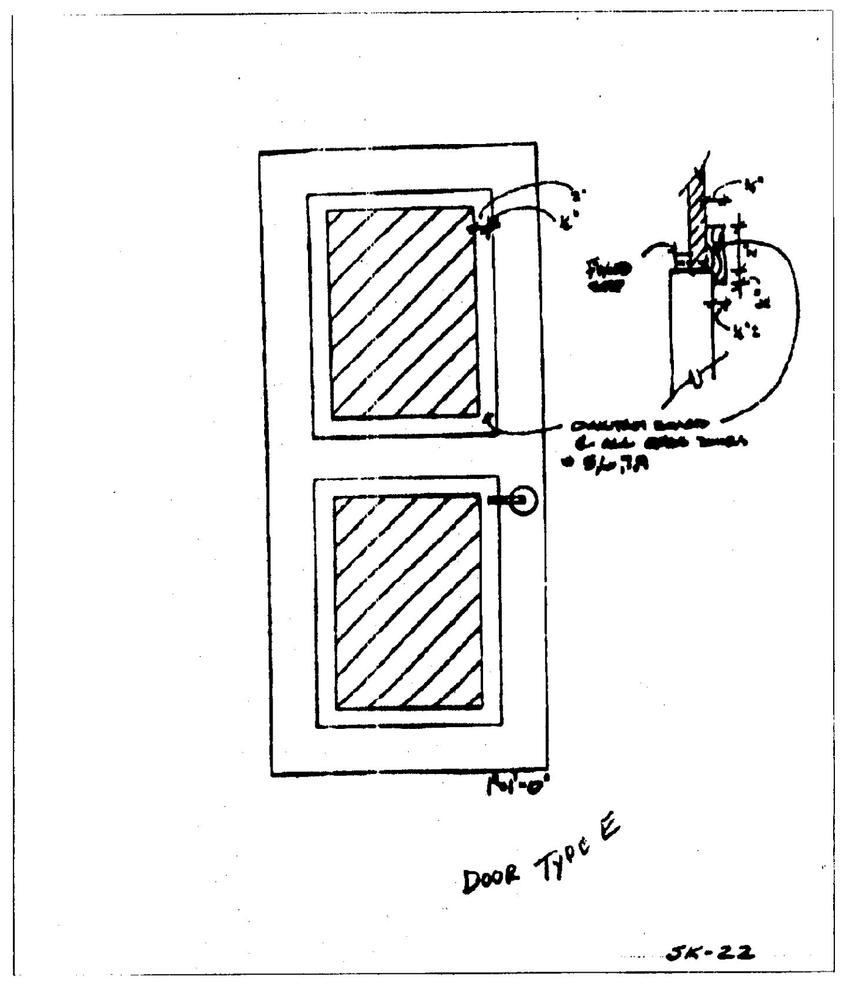

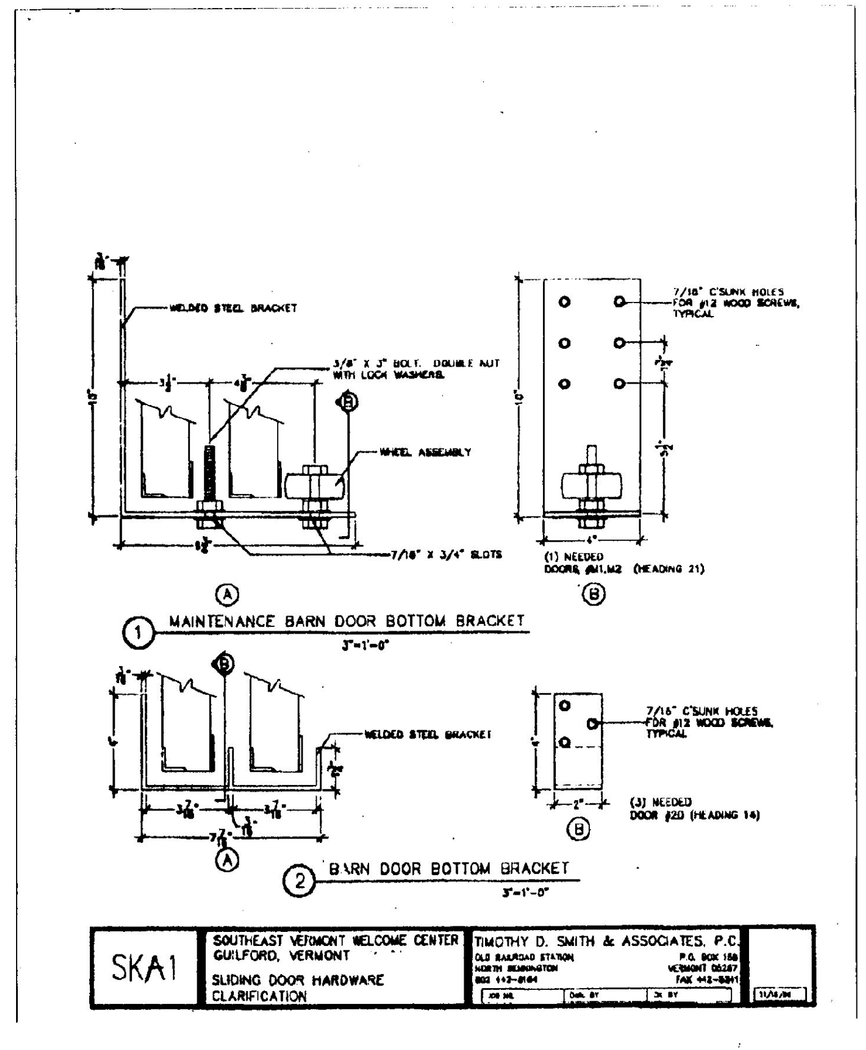

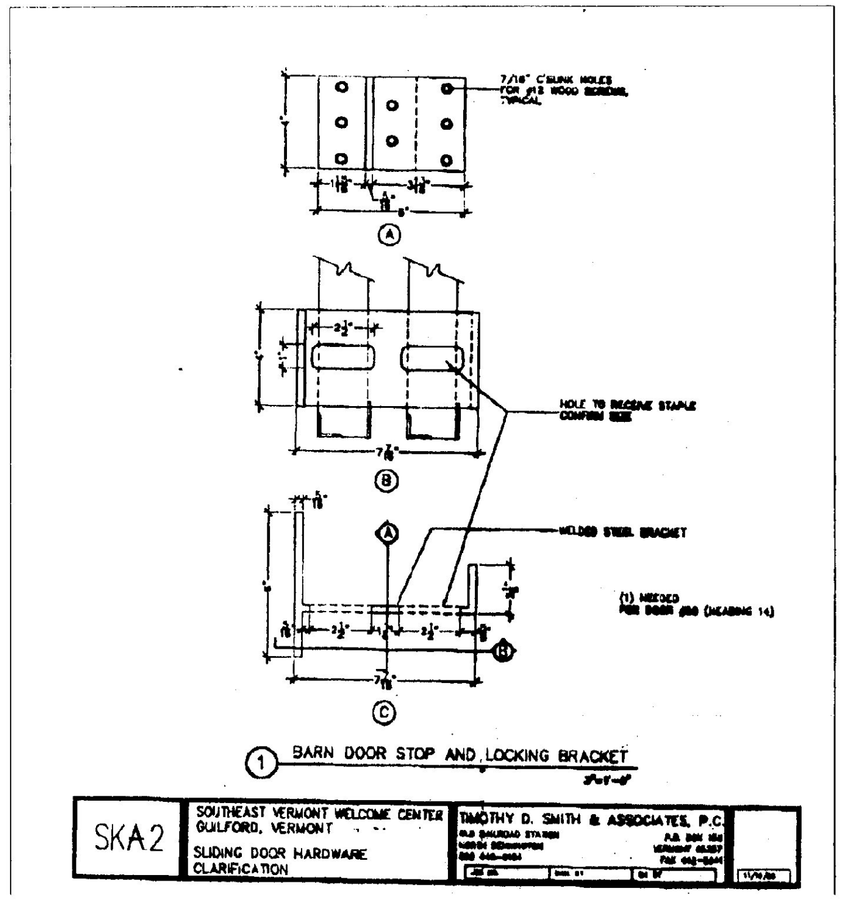

RECORD DRAWING

NO.	DATE	REVISIONS	DRWN	CHKD

TIMOTHY D. SMITH & ASSOCIATES, PC ARCHITECTS
OLD RAILROAD STATION NORTH BENNINGTON, VERMONT 05257
802-442-8184 FAX 802-442-5241

WRIGHT ENGINEERING, LTD. CIVIL ENGINEERS
120 MERCHANTS ROW - P.O. BOX 176 RUTLAND, VERMONT 05702-0176 802-775-2811 FAX 775-8915

ROBT W. HALL CONSULTING ENGINEERS, INC.
540 MEADOW STREET EXTENSION, STE. 2 AGAWAM, MASSACHUSETTS 01001-0002 413-789-0960 FAX 789-3295

T.J. BOYLE AND ASSOCIATES LANDSCAPE ARCHITECTS
301 COLLEGE STREET BURLINGTON, VERMONT 05401 802-658-3550 FAX 863-1562

PROJECT NO.IM 091-1 (30)
SOUTHEAST VERMONT WELCOME CENTER
GUILFORD, VERMONT

SHEET TITLE: DIMENSION CLARIFICATION

DSGN BY:
DRWN BY:
CHKD BY:
CHKD BY:

STATE OF VERMONT
AGENCY OF ADMINISTRATION
DEPARTMENT OF
BUILDINGS & GENERAL SERVICES

DATE: 3-14-2000 SHEET NO._____OF_____SHEETS

AB 13