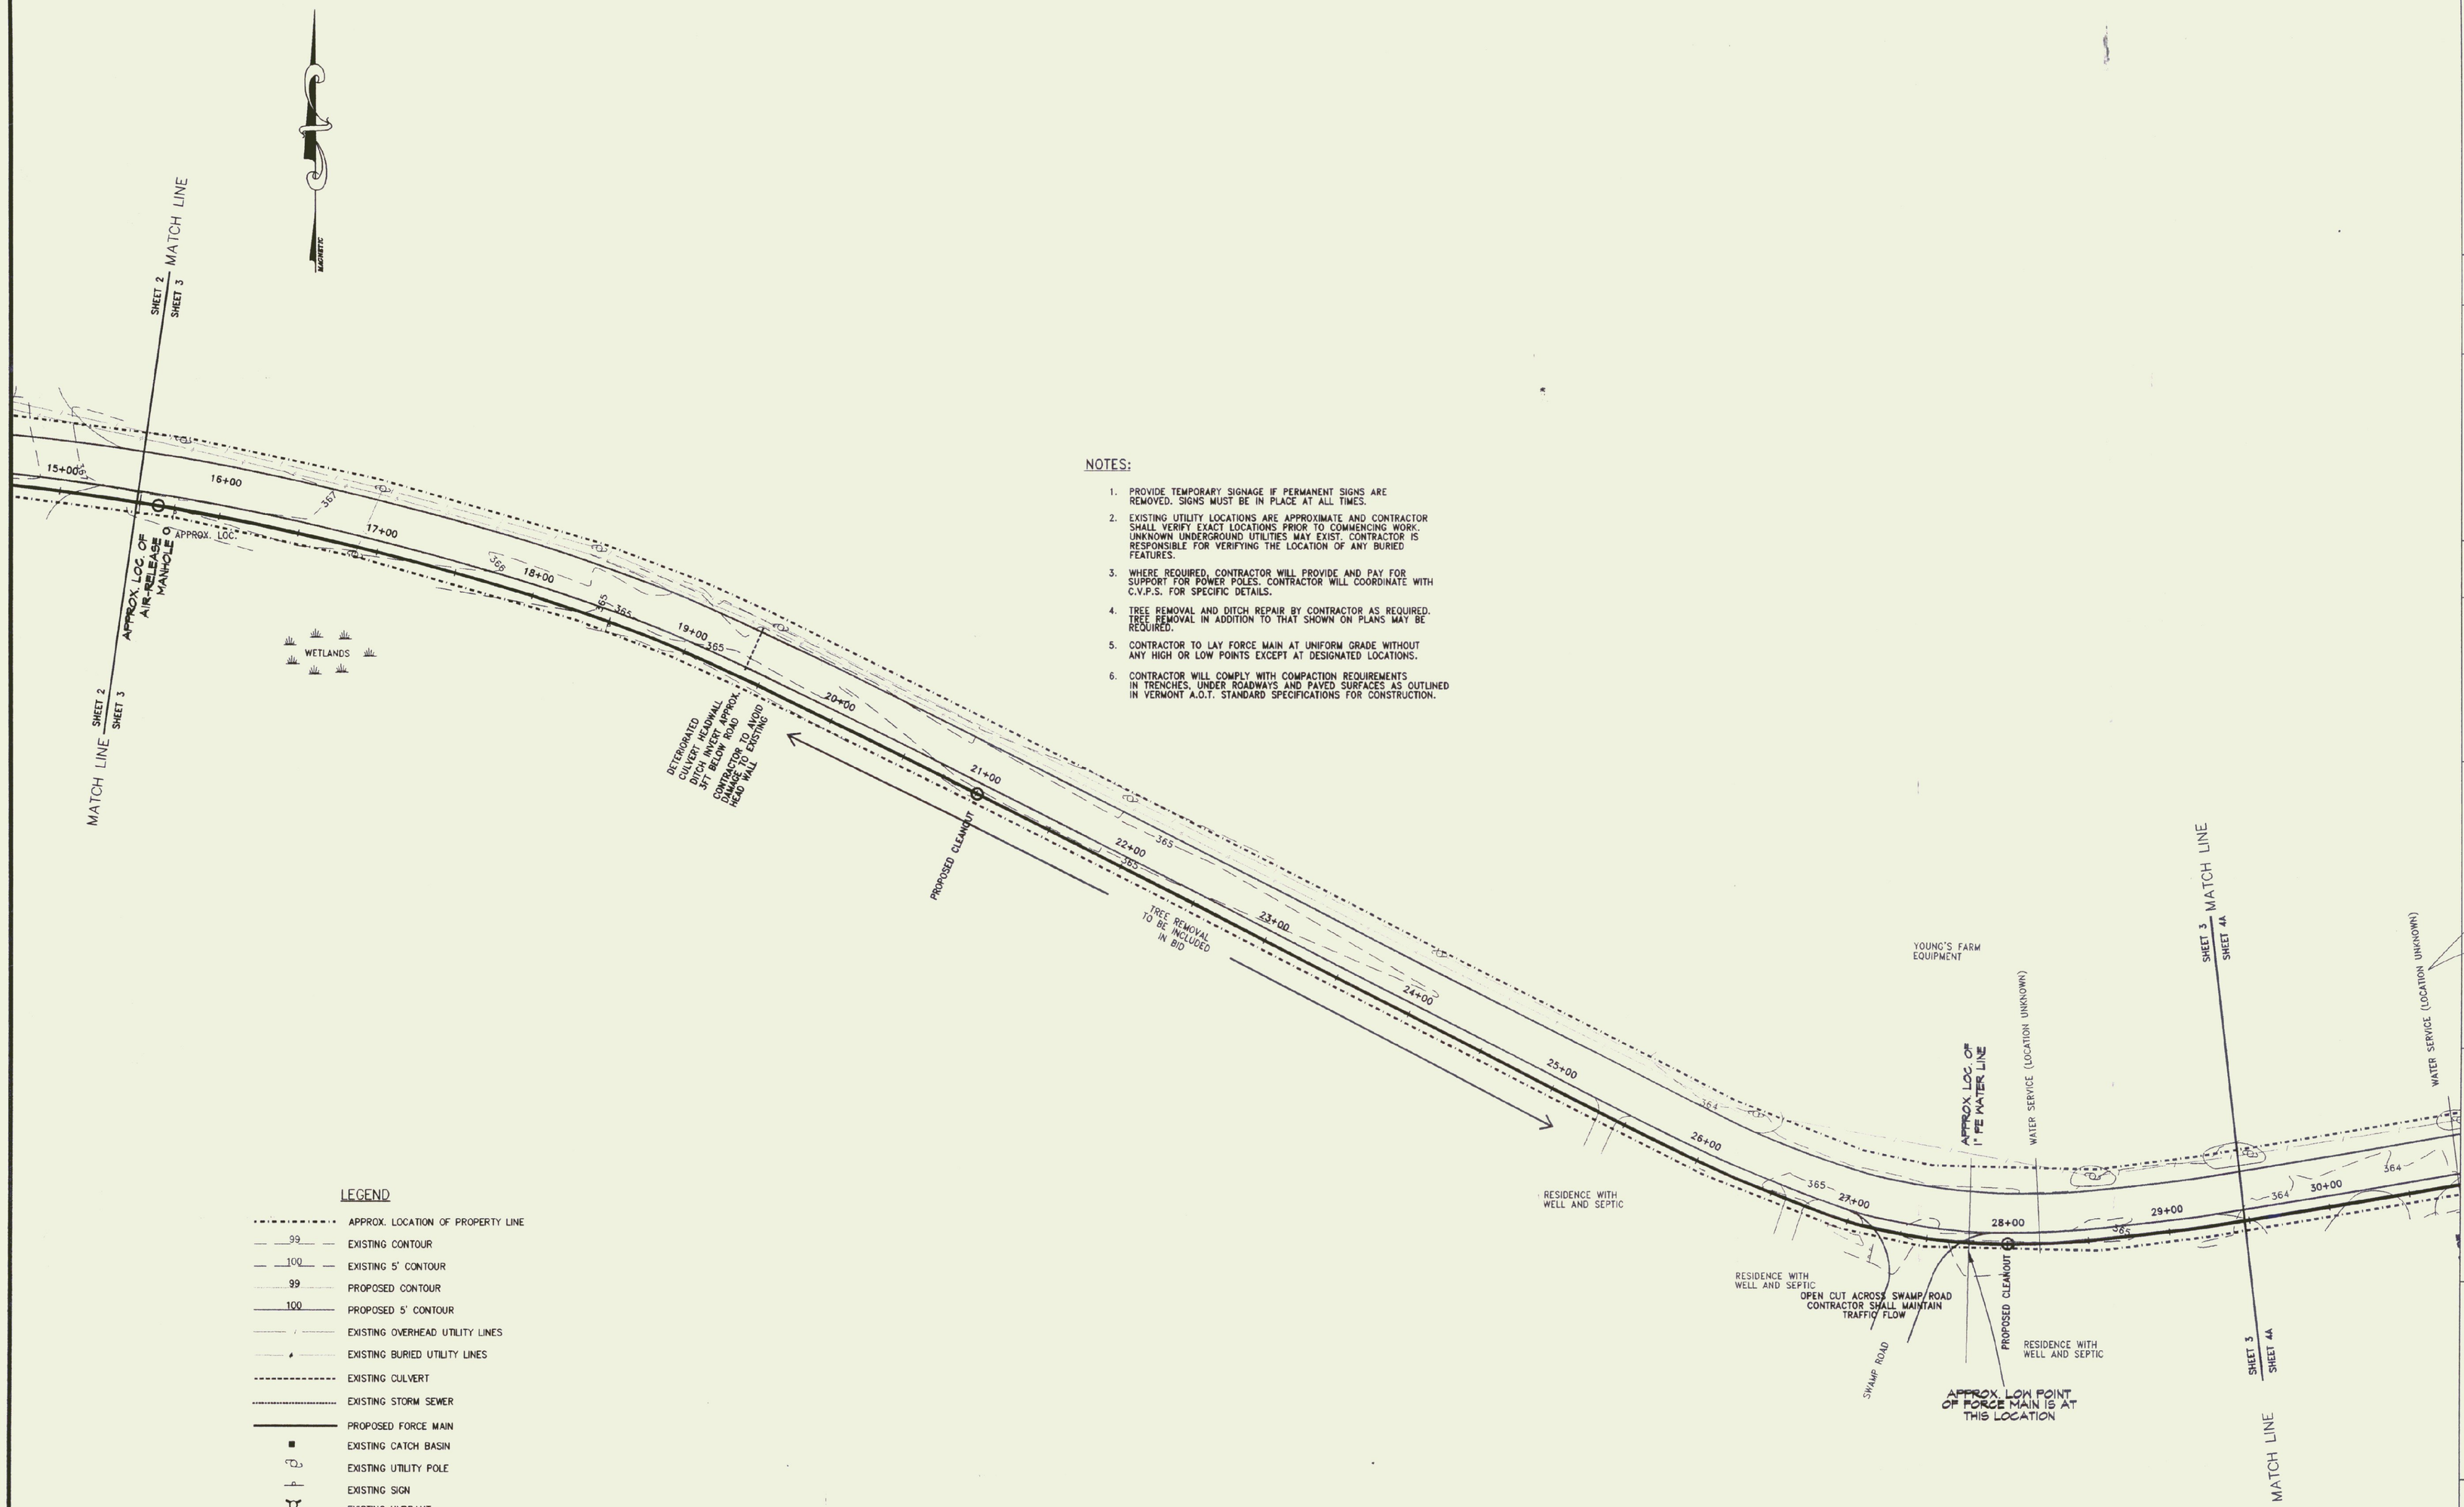

NOTES:

1. PROVIDE TEMPORARY SIGNAGE IF PERMANENT SIGNS ARE REMOVED. SIGNS MUST BE IN PLACE AT ALL TIMES.
2. EXISTING UTILITY LOCATIONS ARE APPROXIMATE AND CONTRACTOR SHALL VERIFY EXACT LOCATIONS PRIOR TO COMMENCING WORK. UNKNOWN UNDERGROUND UTILITIES MAY EXIST. CONTRACTOR IS RESPONSIBLE FOR VERIFYING THE LOCATION OF ANY BURIED FEATURES.
3. WHERE REQUIRED, CONTRACTOR WILL PROVIDE AND PAY FOR SUPPORT FOR POWER POLES. CONTRACTOR WILL COORDINATE WITH C.V.P.S. FOR SPECIFIC DETAILS.
4. TREE REMOVAL AND DITCH REPAIR BY CONTRACTOR AS REQUIRED. TREE REMOVAL IN ADDITION TO THAT SHOWN ON PLANS MAY BE REQUIRED.
5. CONTRACTOR TO LAY FORCE MAIN AT UNIFORM GRADE WITHOUT ANY HIGH OR LOW POINTS EXCEPT AT DESIGNATED LOCATIONS.
6. CONTRACTOR WILL COMPLY WITH COMPACTION REQUIREMENTS IN TRENCHES, UNDER ROADWAYS AND PAVED SURFACES AS OUTLINED IN VERMONT A.O.T. STANDARD SPECIFICATIONS FOR CONSTRUCTION.

LEGEND

- APPROX. LOCATION OF PROPERTY LINE
- 99 EXISTING CONTOUR
- 100 EXISTING 5' CONTOUR
- 99 PROPOSED CONTOUR
- 100 PROPOSED 5' CONTOUR
- EXISTING OVERHEAD UTILITY LINES
- EXISTING BURIED UTILITY LINES
- EXISTING CULVERT
- EXISTING STORM SEWER
- PROPOSED FORCE MAIN
- EXISTING CATCH BASIN
- EXISTING UTILITY POLE
- EXISTING SIGN
- EXISTING HYDRANT
- RR CROSSING SIGNAL LIGHT
- IRON PIN FOUND
- (W) EXISTING WELL
- MANHOLE

GRAPHIC SCALE

50 0 25 50 100

(IN FEET)

1 inch = 50 ft.

THIS RECORD DRAWING IS BASED ON INFORMATION FURNISHED IN PART BY OTHERS WHICH CAN NOT BE VERIFIED BY ENMAN ENGINEERING P.C. PERSONNEL. ENMAN ENGINEERING P.C. PERSONNEL WERE NOT PRESENT DURING ALL ASPECTS OF CONSTRUCTION AND DEVIATIONS FROM THE DRAWINGS THAT WERE MADE WHEN THE ENGINEER WAS NOT PRESENT WOULD BE UNDETECTED. RECORD DATA FOR ABOVE GRADE INSTALLATION IS PICTORIAL AND FIELD MEASUREMENT IS RECOMMENDED.

REVISIONS:

3/11/99
RELEASED TO TOWN OF FAIR HAVEN FOR REVIEW

6/15/99
REROUTE FORCE MAIN MISC. NOTE EDITS

7/02/99
ADD CLEANOUT LOCATIONS
MISC. PLAN EDITS

8/20/99
MISC. NOTE EDITS

2/15/00
ADD RECORD INFORMATION

RELEASED: APRIL 2000

ISSUED FOR: RECORD DRAWING

FAIR HAVEN WELCOME CENTER

FAIRHAVEN, VERMONT

THESE PLANS ARE FOR THIS PROJECT ONLY AND ARE NOT FOR REUSE ON THIS PROJECT OR ANY OTHER PROJECT WITHOUT WRITTEN CONSENT OF ENMAN ENGINEERING, P.C.

Enman Engineering
Environmental ■ Civil ■ Sanitary
230 North Main Street
Rutland, Vermont 05701
(802)775-3437
Copyright © 1998
All rights reserved.

BLAIR ENMAN No. 3552 REGISTERED PROFESSIONAL ENGINEER STATE OF VERMONT

THE CERTIFICATION ON THIS DRAWING ONLY INDICATES THE VT REGISTERED PROFESSIONAL ENGINEER RESPONSIBLE FOR PREPARATION AND IS NOT ISSUED FOR CONSTRUCTION UNLESS NOTED IN THE REVISION BOX.

REGULATORY APPROVAL STAMP

SEWER PLAN

STA 15+50 TO STA 29+50

RECORD DRAWING

SCALE:	AS NOTED
DATE:	02/24/99
DESIGN BY:	BJE/TNT
DRAWN BY:	JBT/JPL
SHEET NO:	3 OF 9
PROJECT NO:	9816

9816.DWG 3_OF_9LAY VIEW= 3_OF_9