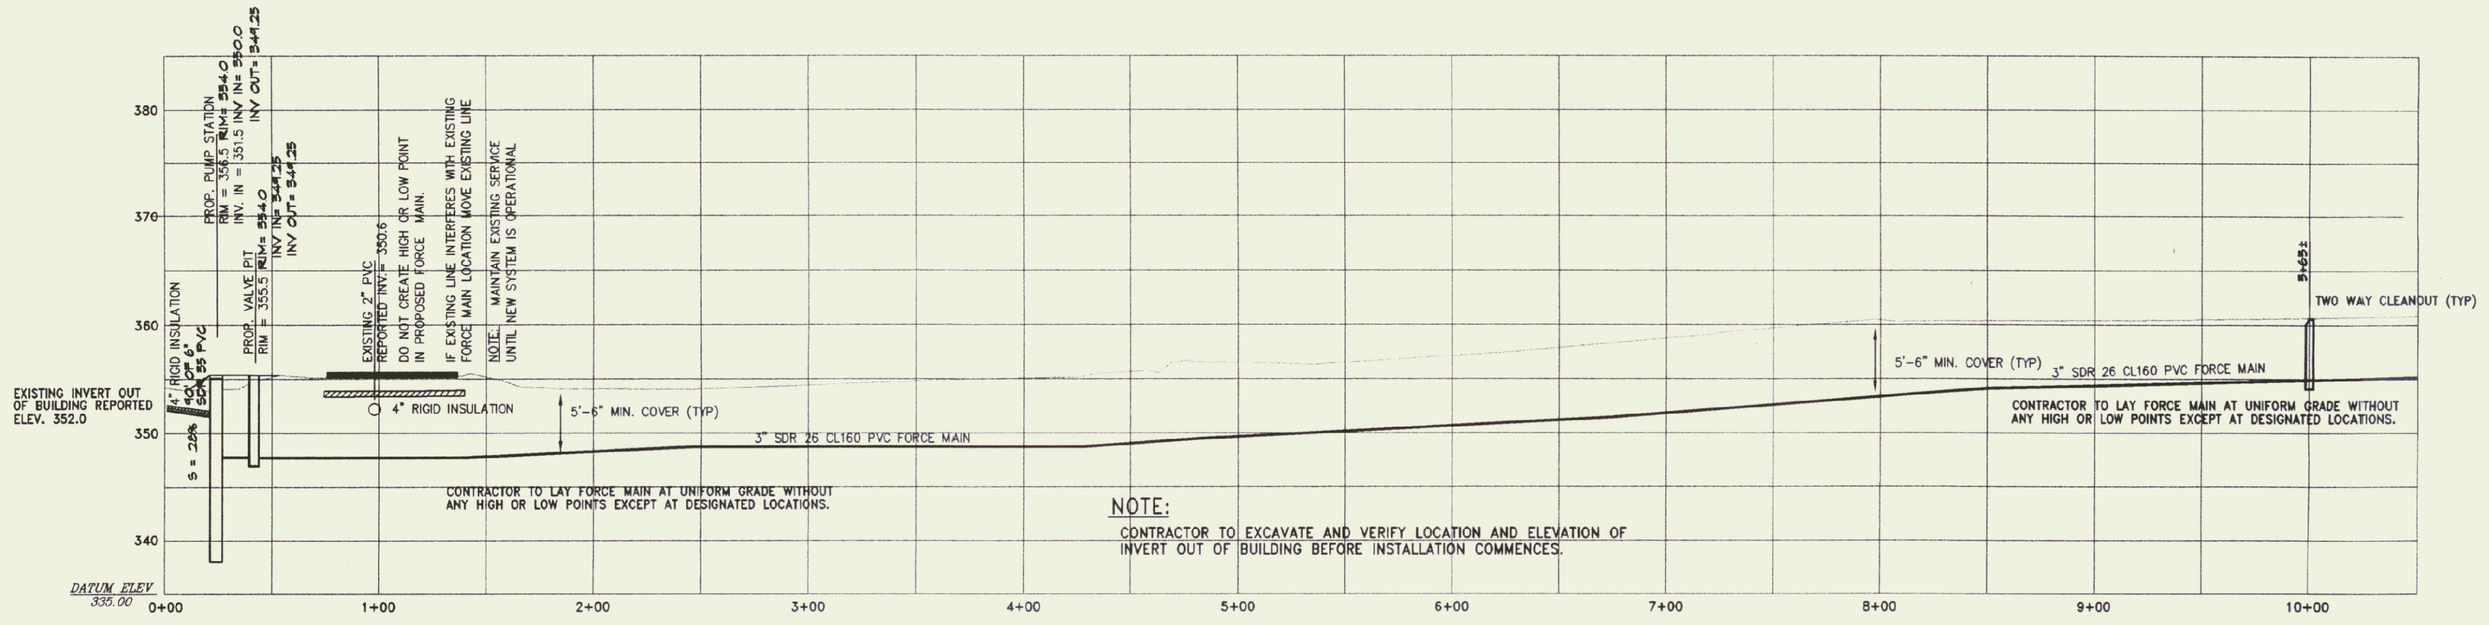


## SEWER PROFILE

SCALE: VERTICAL 1"=10'
HORIZONTAL 1"=50'

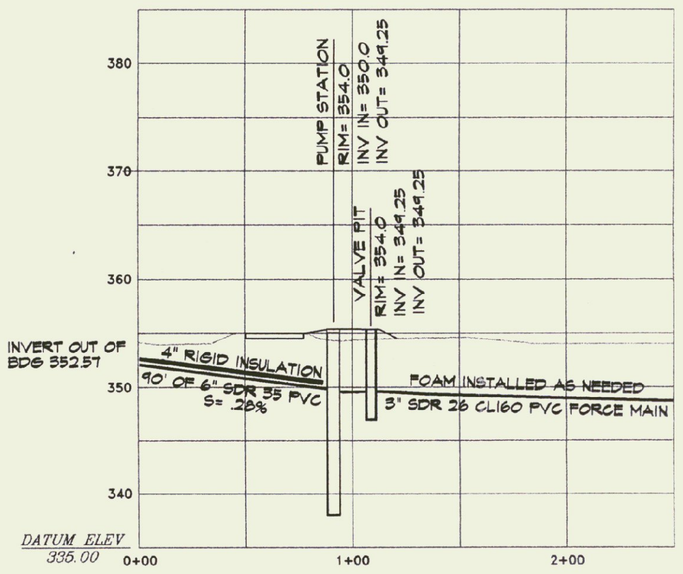


## RECORD SEWER PROFILE

SCALE: VERTICAL 1"=10'
HORIZONTAL 1"=50'

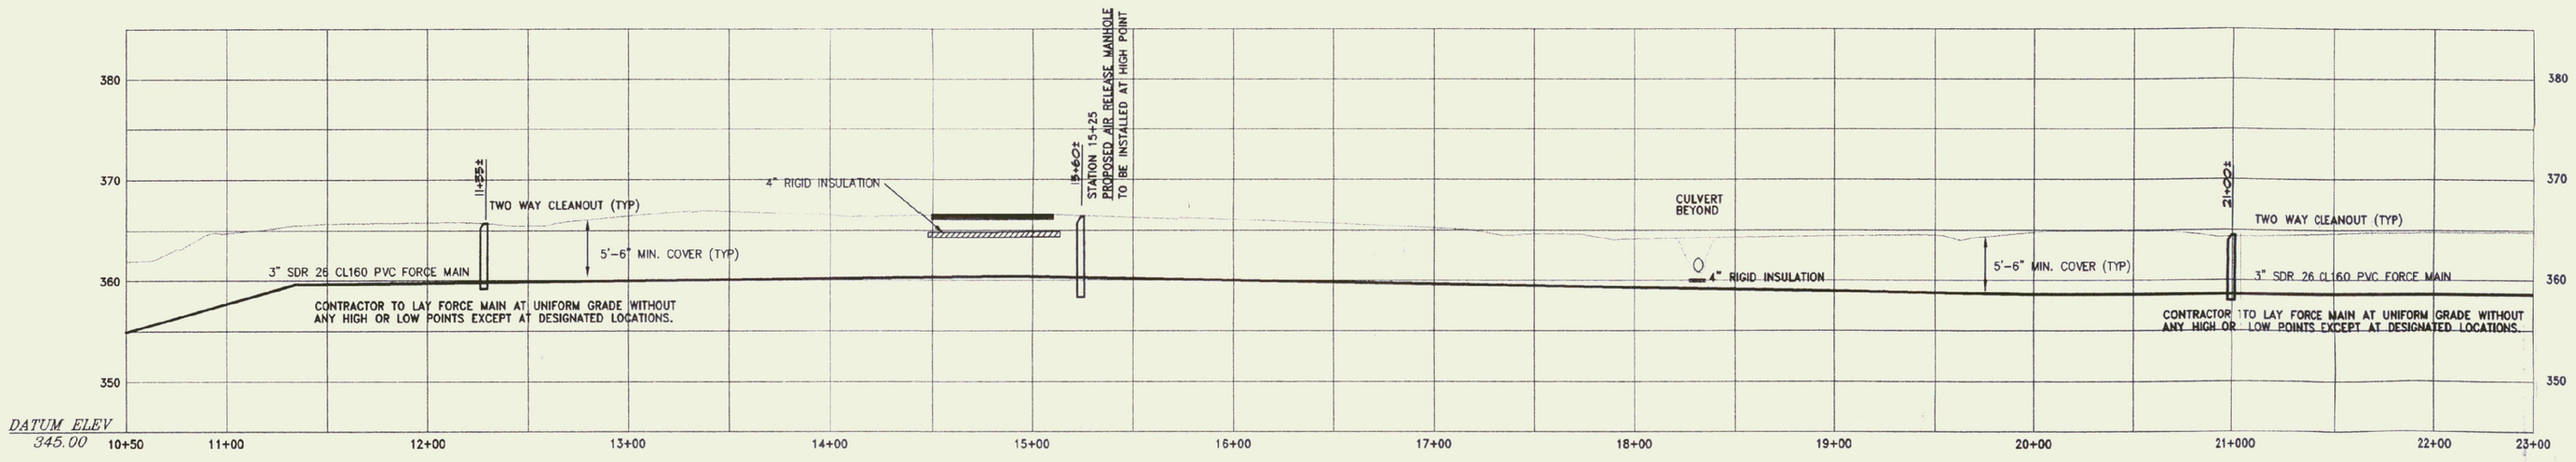


## SEWER PROFILE

SCALE: VERTICAL 1"=10'
HORIZONTAL 1"=50'

THIS RECORD DRAWING IS BASED ON INFORMATION FURNISHED IN PART BY OTHERS WHICH CAN NOT BE VERIFIED BY ENMAN ENGINEERING P.C. PERSONNEL. ENMAN ENGINEERING P.C. PERSONNEL WERE NOT PRESENT DURING ALL ASPECTS OF CONSTRUCTION AND DEVIATIONS FROM THE DRAWINGS THAT WERE MADE WHEN THE ENGINEER WAS NOT PRESENT WOULD BE UNDETECTED. RECORD DATA FOR ABOVE GRADE INSTALLATION IS PICTORIAL AND FIELD MEASUREMENT IS RECOMMENDED.

REVISIONS:

3/11/99
ADD THRUST BLOCK DETAIL
RELEASED TO TOWN OF FAIR HAVEN FOR REVIEW

6/15/99
REROUTE FORCE MAIN MISC. NOTE EDITS

7/02/99
ADD CLEANOUT LOCATIONS
MISC. PLAN EDITS

8/20/99
MISC. NOTE EDITS

2/15/00
ADD RECORD INFORMATION

RELEASED: APRIL 2000

RELEASED FOR: RECORD DRAWING

# FAIR HAVEN WELCOME CENTER

FAIRHAVEN, VERMONT

THESE PLANS ARE FOR THIS PROJECT ONLY AND ARE NOT FOR REUSE ON THIS PROJECT OR ANY OTHER PROJECT WITHOUT WRITTEN CONSENT OF ENMAN ENGINEERING, P.C.

Enman Engineering
Environmental ▪ Civil ▪ Sanitary
230 North Main Street
Rutland, Vermont 05701
(802)775-3437
Copyright © 1998
All rights reserved.

STATE OF VERMONT
BLAIR
ENMAN
No. 3564
REGISTERED
PROFESSIONAL ENGINEER

THE CERTIFICATION ON THIS DRAWING ONLY INDICATES THE VT REGISTERED PROFESSIONAL ENGINEER RESPONSIBLE FOR PREPARATION AND IS NOT ISSUED FOR CONSTRUCTION UNLESS NOTED IN THE REVISION BOX.

REGULATORY APPROVAL STAMP

## SEWER PROFILES

RECORD DRAWING

| | |
|---|---|
| SCALE: | AS NOTED |
| DATE: | 02/24/99 |
| DESIGN BY: | BJE/TNT |
| DRAWN BY: | JBT/JPL |
| SHEET NO: | 5 OF 9 |
| PROJECT NO: | 9816 |

9816.DWG 5_OF_9.LAY VIEW= 5_OF_9