


CONSTRUCT NEW SIDEWALK RAMPS AS PER STANDARD C-3.
 TO BE PAID UNDER:
 SOLID ROCK EXCAVATION, 203.14
 PORTLAND CEMENT CONCRETE SIDEWALK - 5'', 418.10
 REMOVING AND RESETTING CURB, 818.40

NORTHBOUND
 A 48922.44' RT
 R 2864.79
 T 1286.85
 L 2418.95
 E 2757.4
 BANK 11/16' PER FT.
 NB PI 3625+31.64+
 3623+7689

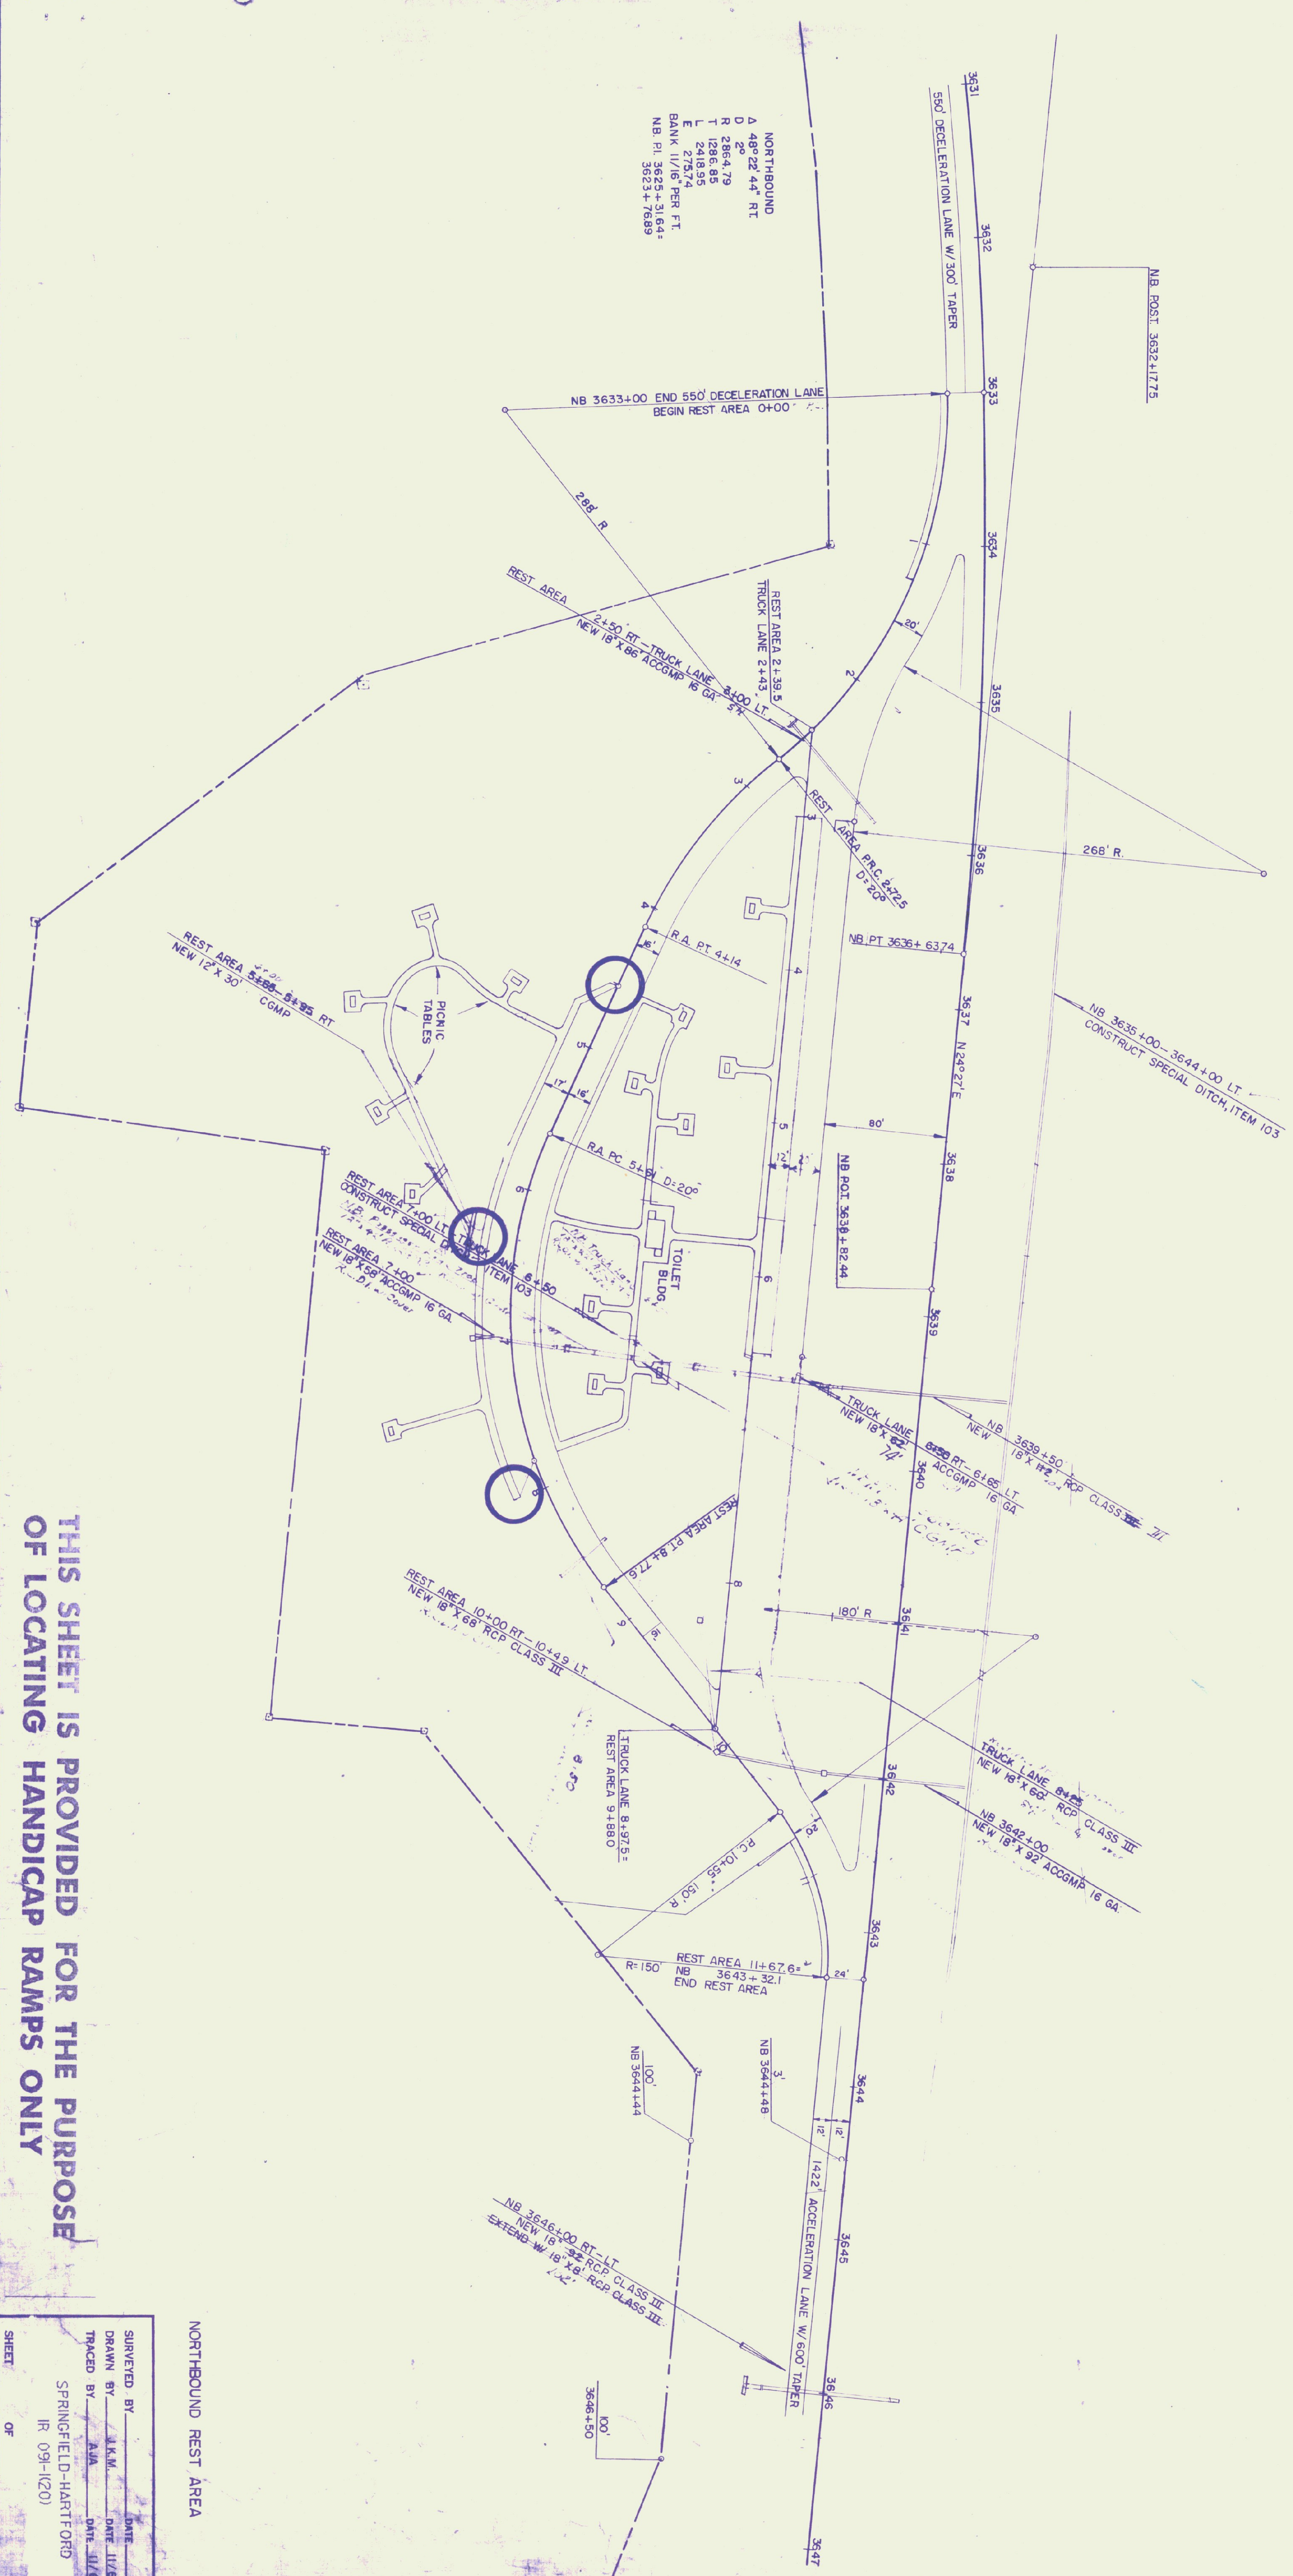

**THIS SHEET IS PROVIDED FOR THE PURPOSE
 OF LOCATING HANDICAP RAMPS ONLY**

NORTHBOUND REST AREA

| | |
|----------------------|------------|
| SURVEYED BY | DATE |
| DRAWN BY | DATE 11/85 |
| TRACED BY | DATE 11/85 |
| SPRINGFIELD-HARTFORD | |
| IR 09-(120) | |
| SHEET | OF |