CONSTRUCT NEW SIDEWALK RAMPS AS PER STANDARD C-3.

TO BE PAID UNDER:
SOLID ROCK EXCAVATION, 203.16
PORTLAND CEMENT CONCRETE SIDEWALK - 5'', 618.10
REMOVING AND RESETTING CURB, 616.40

NOTE: SOUTHBOUND REST AREA IS TO BE REPAVED UNDER A SEPARATE PROJECT AFTER CONSTRUCTION OF SPRINGFIELD - HARTFORD IR 091-1(20). SIDEWALK RAMPS SHOULD THEREFORE BE CONSTRUCTED WITH A 1 1/2'' RISE BETWEEN TOP OF EXISTING PAVEMENT AND TOP OF NEW RAMP SUCH THAT TRANSITION WILL BE FLUSH WHEN REST AREA IS REPAVED. IN THE MEANTIME A SMALL FILLET MADE OF BITUMINOUS CONCRETE PAVEMENT SHALL BE USED TO RENDER THE RAMP ACCESSIBLE TO WHEELCHAIRS, AS SHOWN ON DETAIL 'A' OF THIS SHEET.

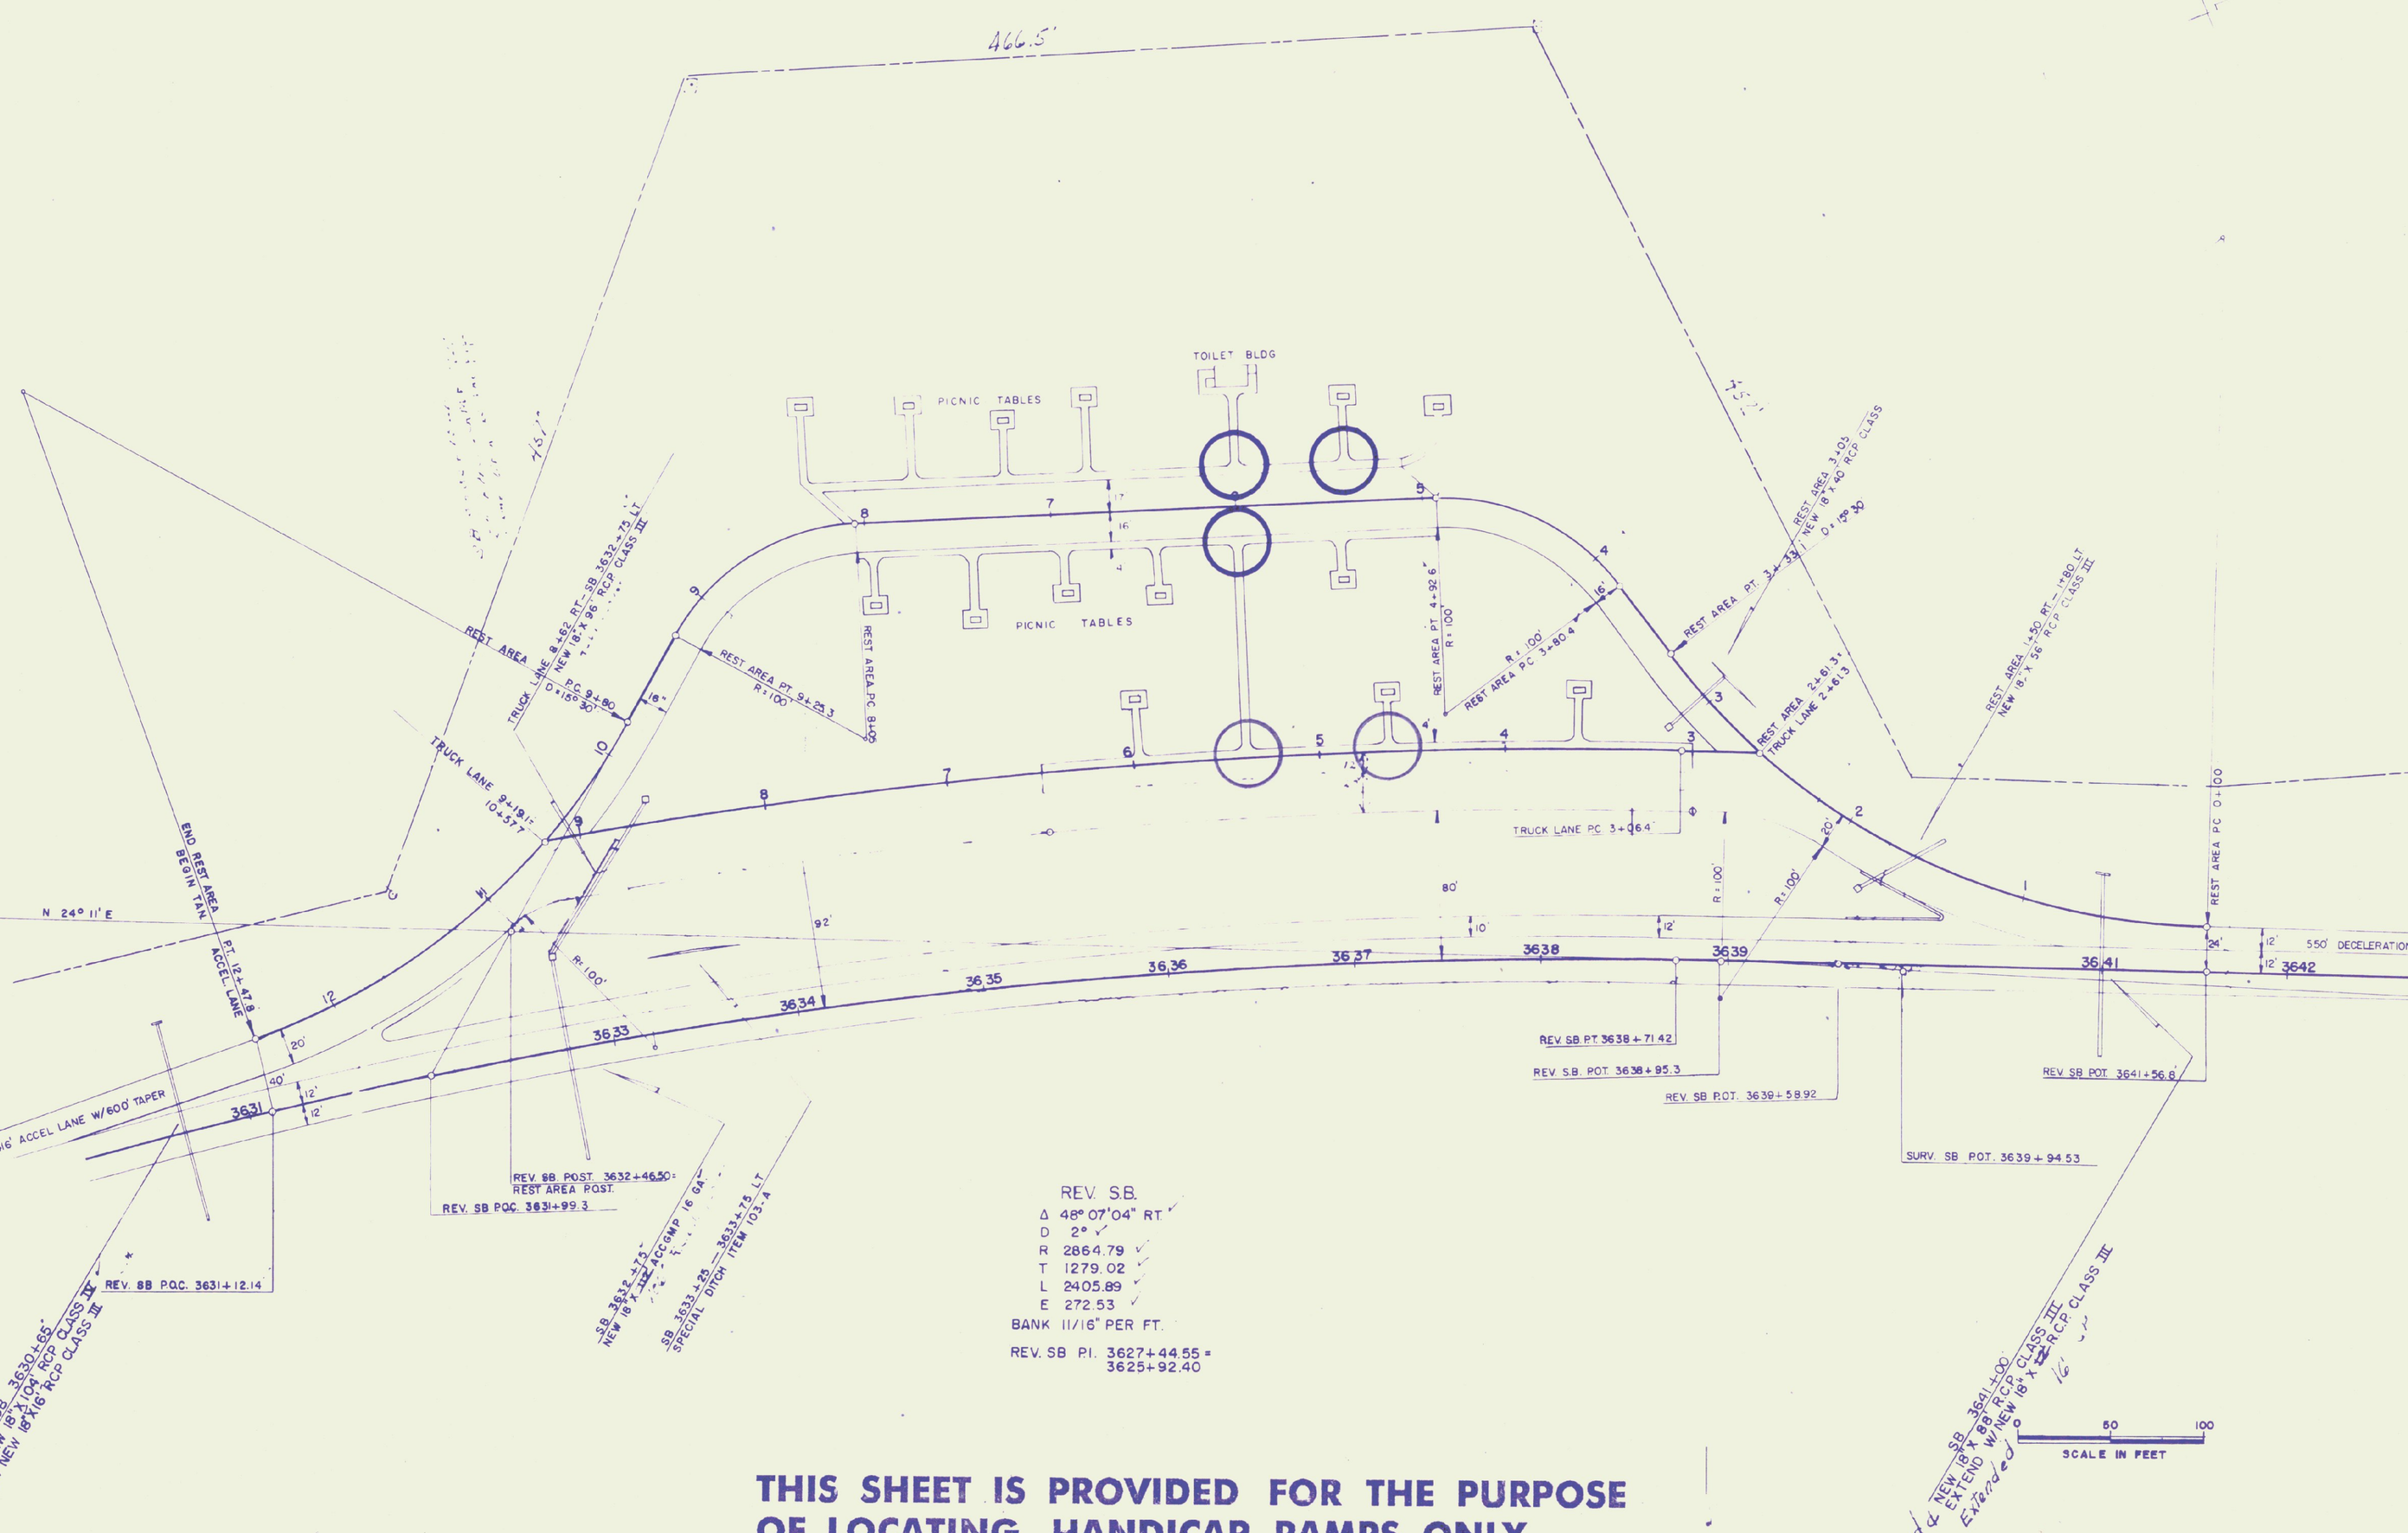

REV. S.B.
Δ 48° 07' 04" RT. ✓
D 2° ✓
R 2864.79 ✓
T 1279.02 ✓
L 2405.89 ✓
E 272.53 ✓
BANK 11/16" PER FT.
REV. SB PI. 3627+44.55 = 3625+92.40

THIS SHEET IS PROVIDED FOR THE PURPOSE OF LOCATING HANDICAP RAMPS ONLY

SOUTHBOUND REST AREA

SURVEYED BY _____ DATE _____
DRAWN BY R. HAY DATE 12/85
TRACED BY AJA DATE 12/85
SPRINGFIELD-HARTFORD
IR 091-1(20)
SHEET OF

S.L.M. 264