


CONSTRUCT NEW SIDEWALK RAMPS AS PER STANDARD C-3.
 TO BE PAID UNDER:
 SOLID ROCK EXCAVATION, 203.14
 PORTLAND CEMENT CONCRETE SIDEWALK - 5'', 418.10
 REMOVING AND RESETTING CURB, 818.40

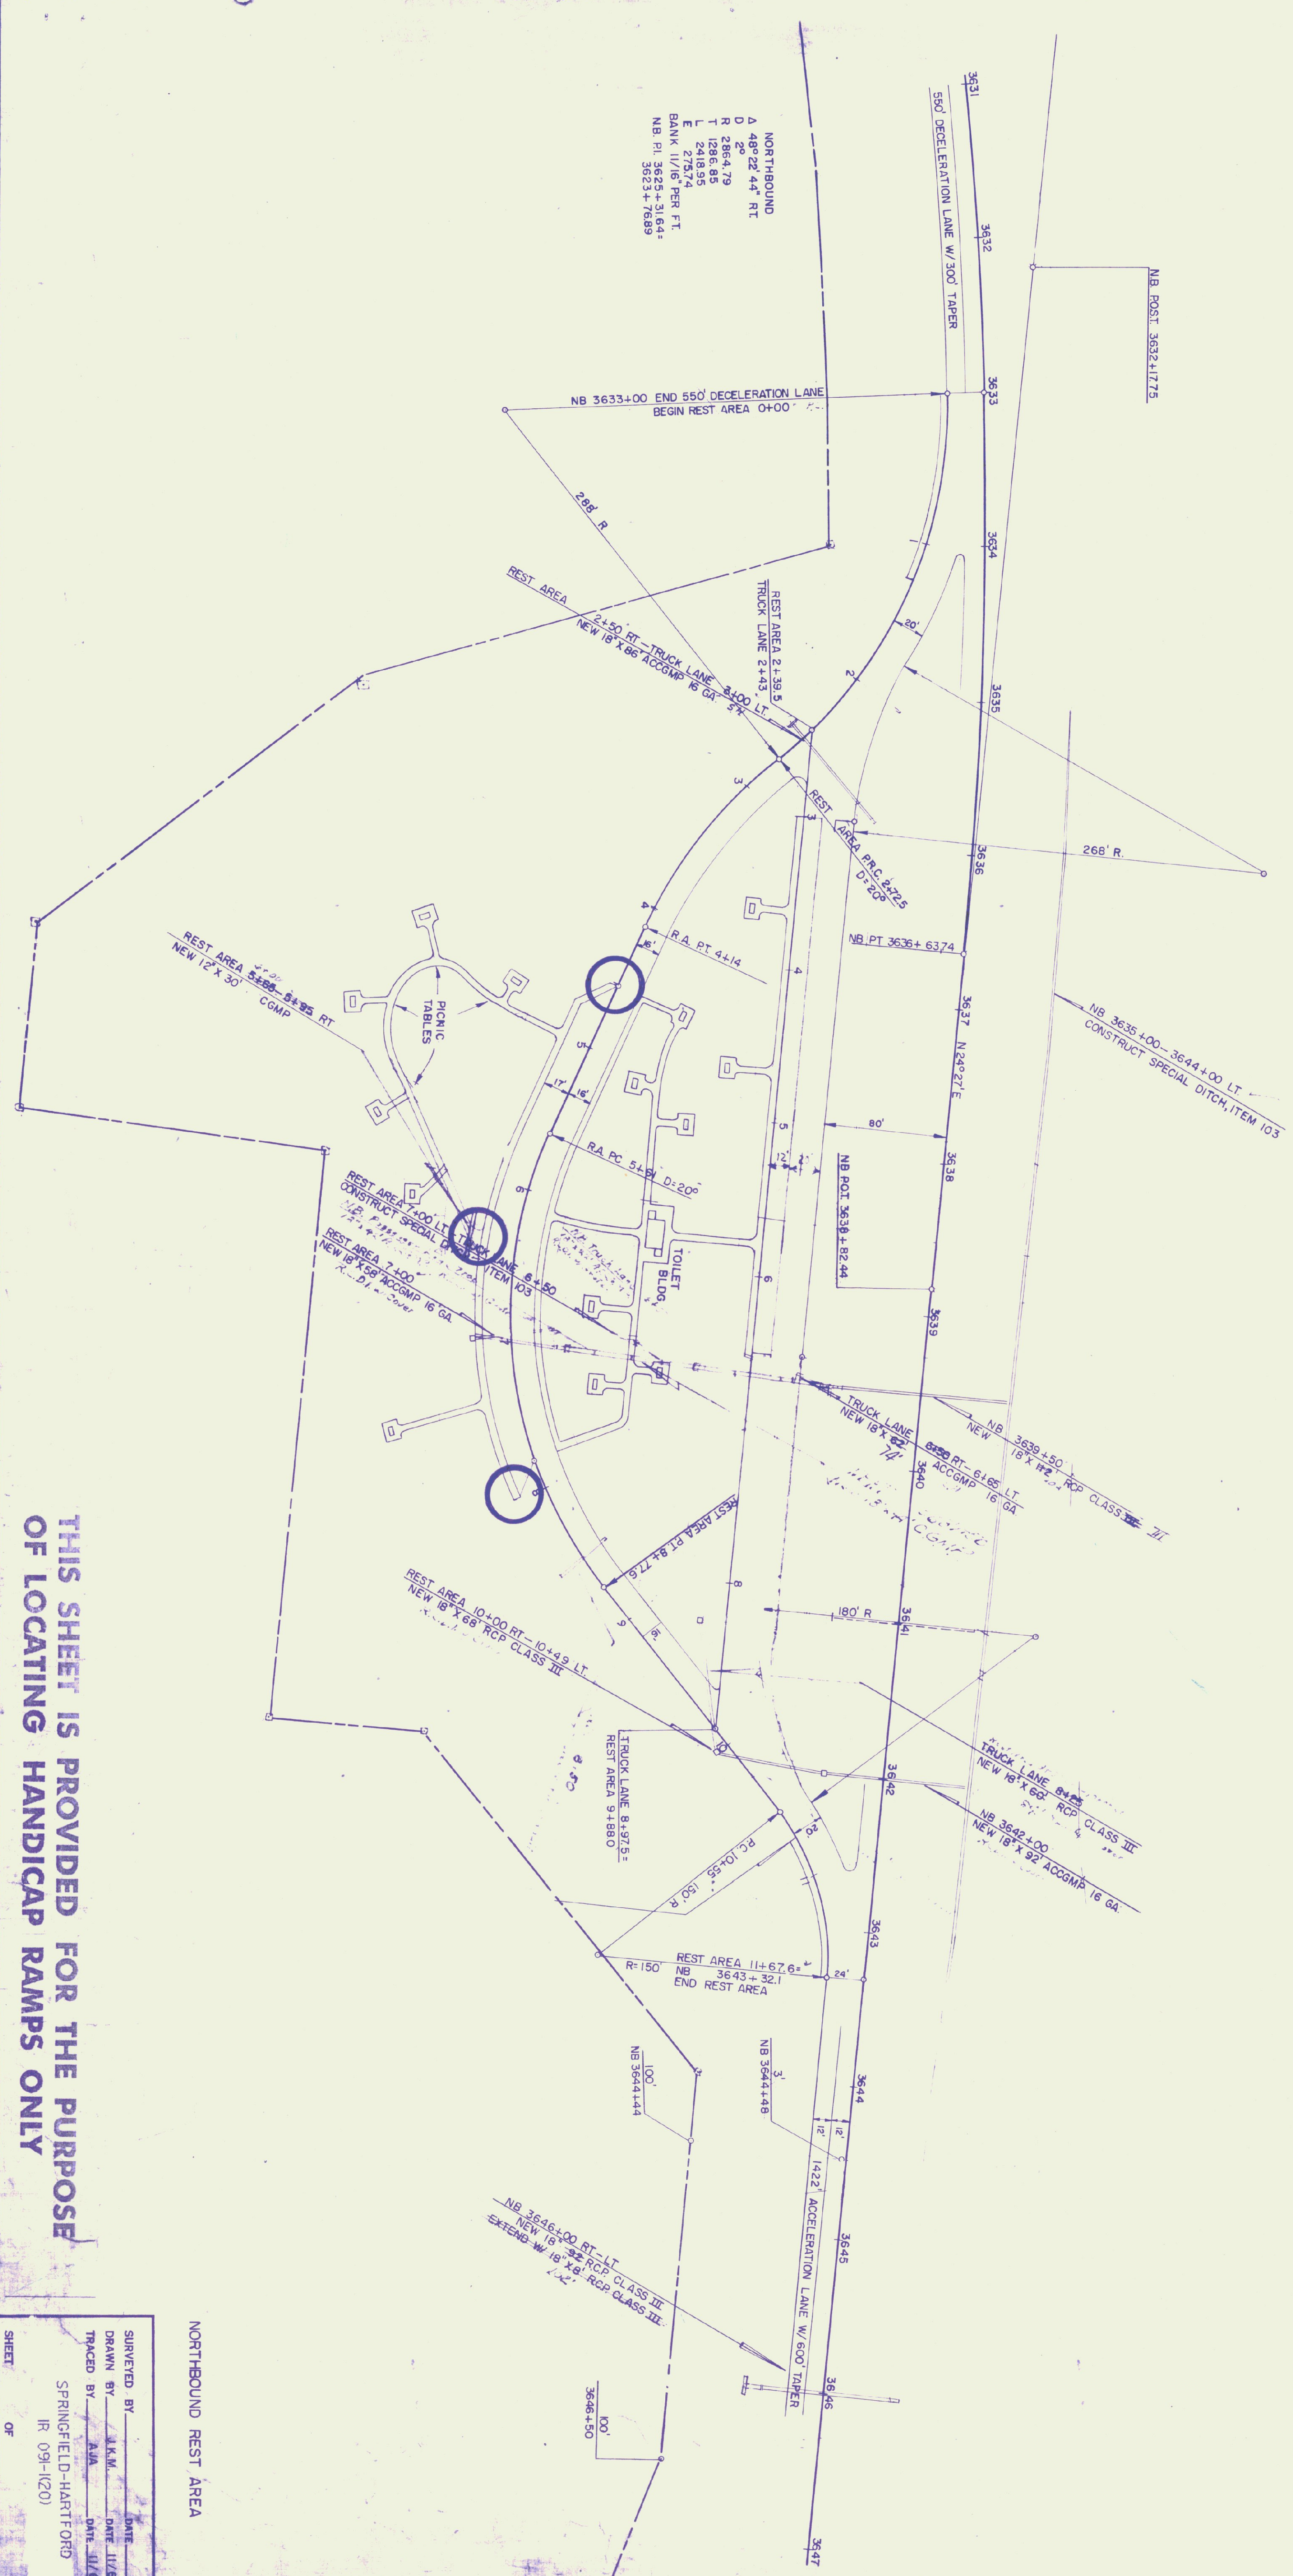

NORTHBOUND
 A 48922.44' RT
 R 2864.79
 T 1286.85
 L 2418.95
 E 275.74
 BANK 11/16 PER FT.
 NB PI 3625+3164+
 3623+7689

**THIS SHEET IS PROVIDED FOR THE PURPOSE
 OF LOCATING HANDICAP RAMPS ONLY**

NORTHBOUND REST AREA

SURVEYED BY	DATE
DRAWN BY	DATE 11/85
TRACED BY	DATE 11/85
SPRINGFIELD-HARTFORD	
IR 09-(120)	
SHEET	OF

