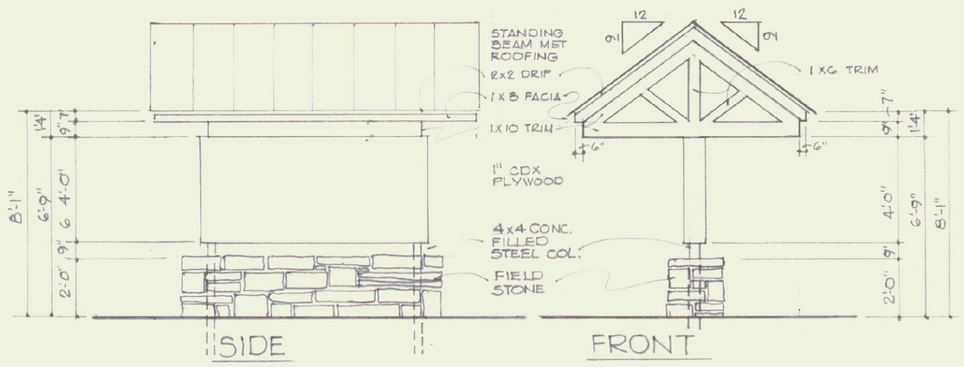

KIOSK SCALE: 1/4" = 1'-0"

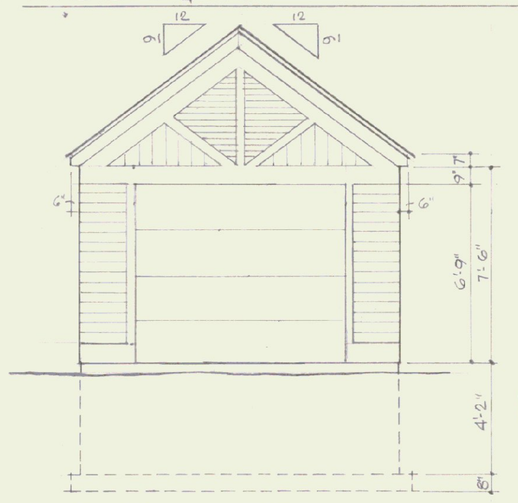

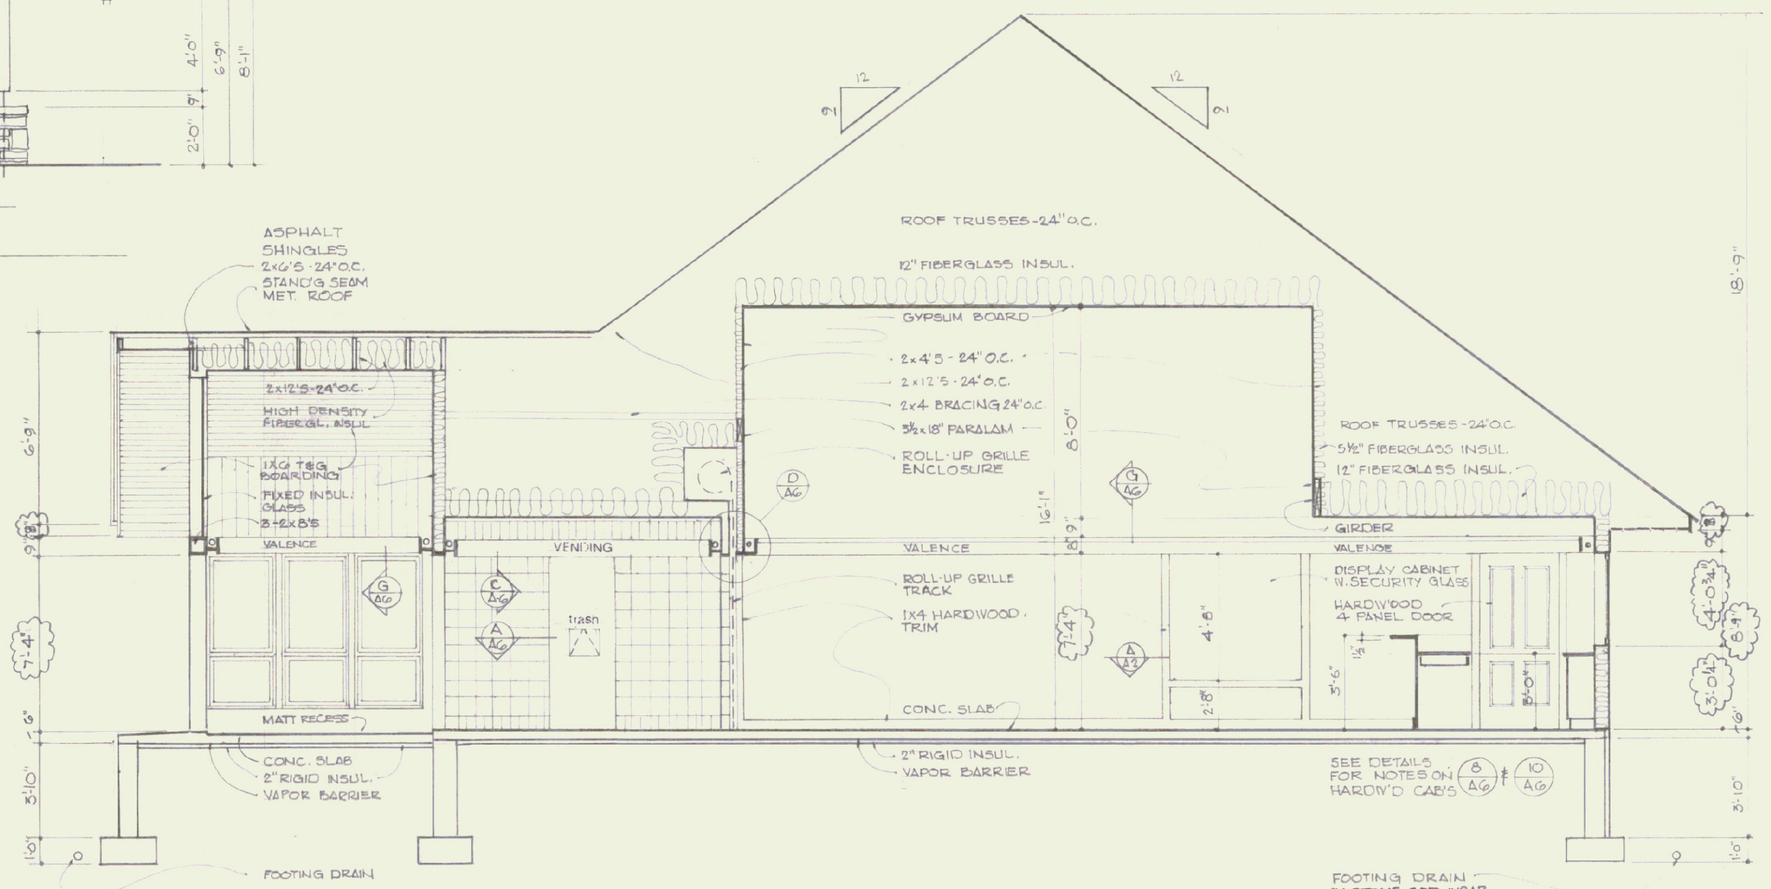

SECTION A

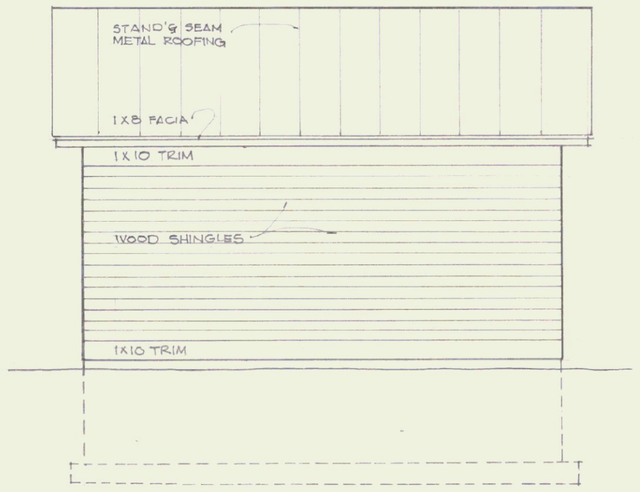

NORTH & SOUTH

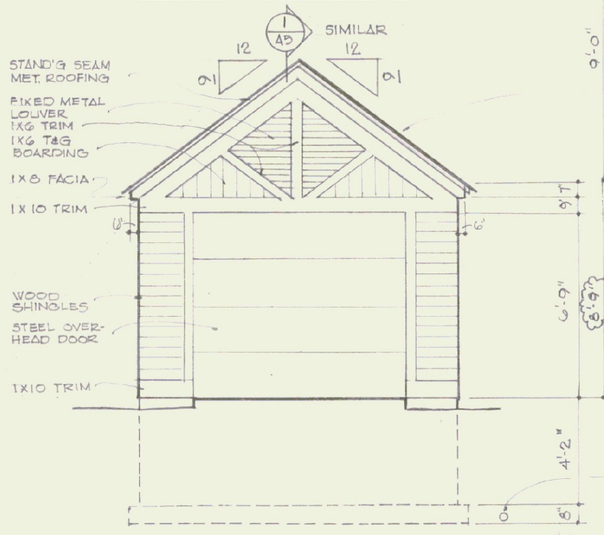

WEST

UTILITY BUILDING SCALE: 1/4" = 1'-0"

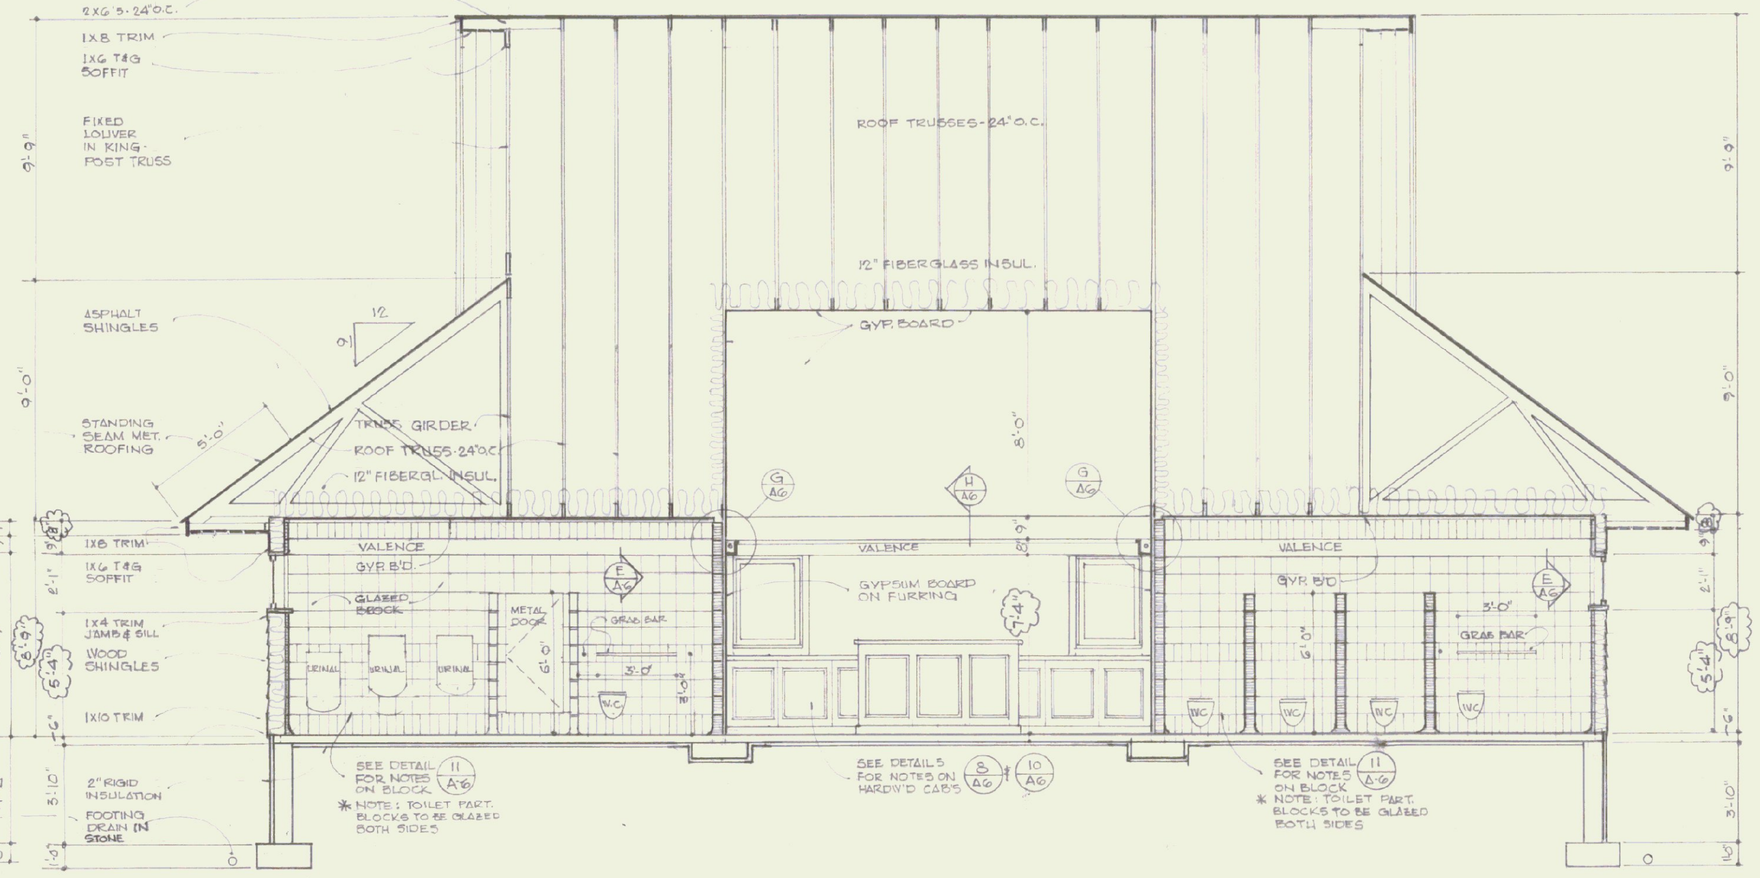

SECTION B

INFORMATION CENTER - SECTIONS SCALE: 1/4" = 1'-0"

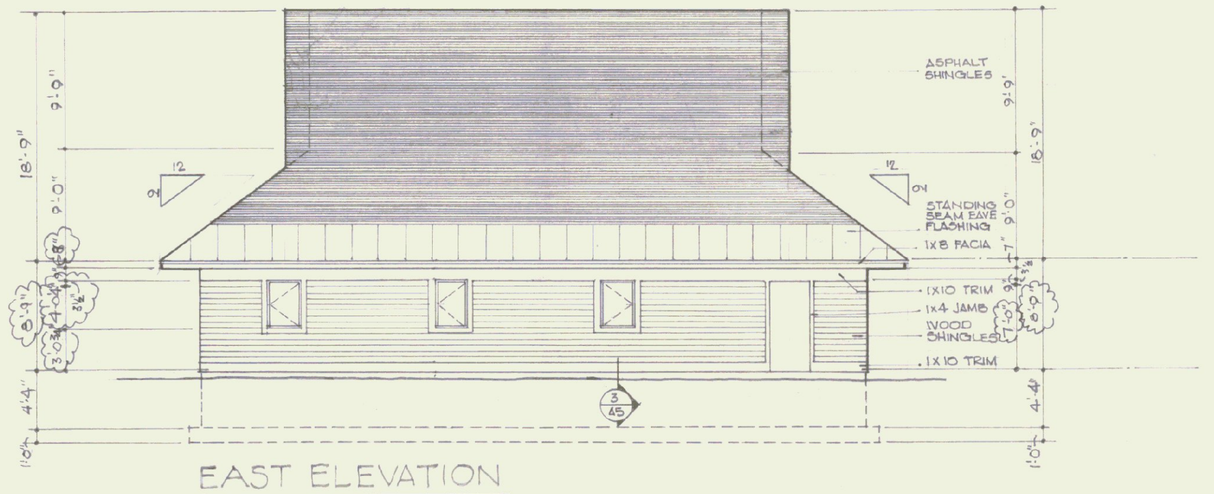

EAST ELEVATION

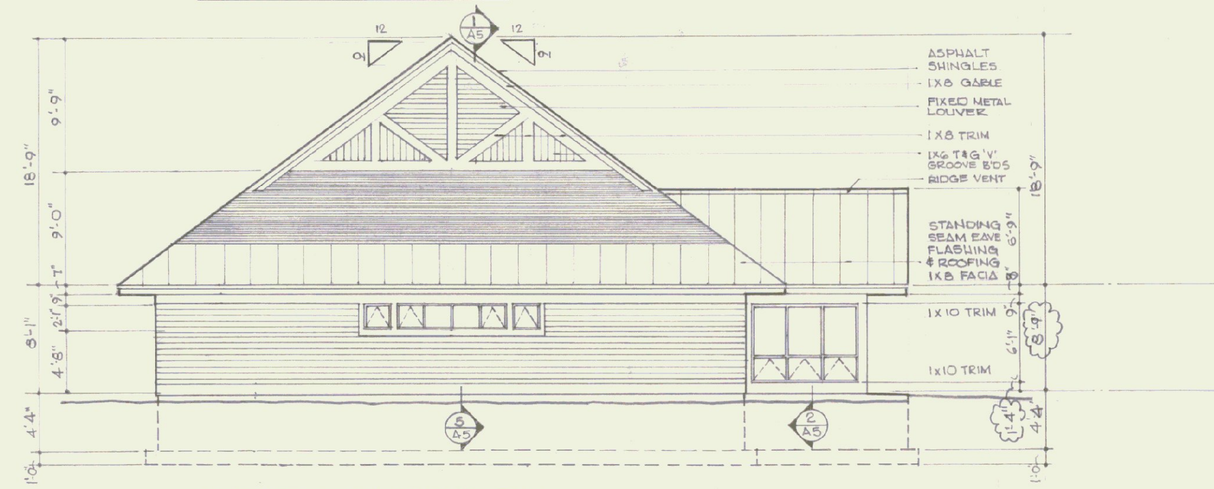

NORTH ELEVATION

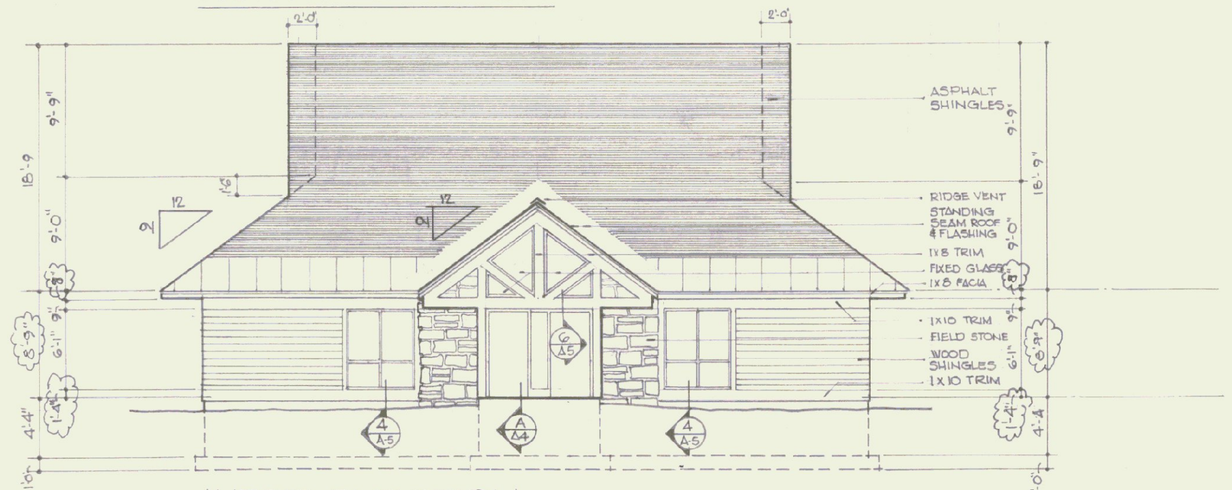

WEST ELEVATION

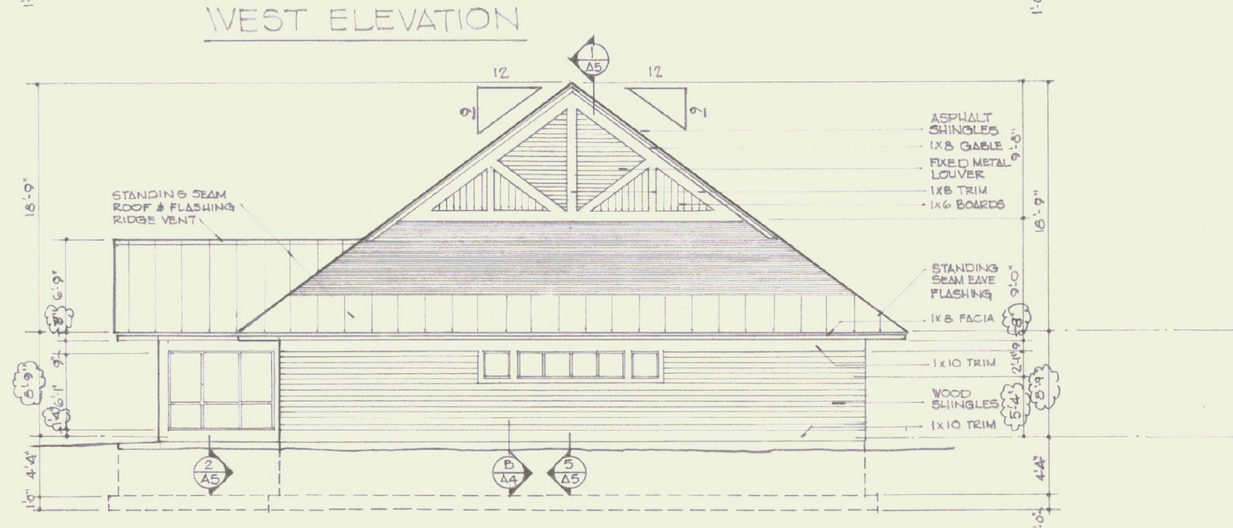

SOUTH ELEVATION

INFORMATION CENTER - ELEVATIONS SCALE: 1/8" = 1'-0"

ARCHITECT: THOMAS B. LEYTHAM
50 STATE STREET MONTPELIER, VERMONT 05602 802 229 0430

MECHANICAL / ELECTRICAL: AVENGCO
83 S. MAIN STREET WATERBURY, VERMONT 05676 802 244 8802

LANDSCAPE: THE CAVENDISH PARTNERSHIP
BOX 466 CAVENDISH, VERMONT 05142 802 226 7220

STRUCTURAL: CHENETTE ENGINEERING
50 STATE STREET MONTPELIER, VERMONT 05602 802 229 1442

GRAPHIC SYSTEMS: HUSTON & CO.
BOX 1034 BURLINGTON, VERMONT 05401 802 864 5928

ELEVATIONS
SECTIONS

STATE OF VERMONT
DEPARTMENT OF STATE BUILDINGS
AGENCY OF ADMINISTRATION
MONTPELIER, VERMONT

BRADFORD I-91 NORTHBOUND
REST AREA REHABILITATION

drawing number: A4

date: 9/24/93
REVISED: 9/7/94

SHEET 8 OF 24