




WEST ELEVATION

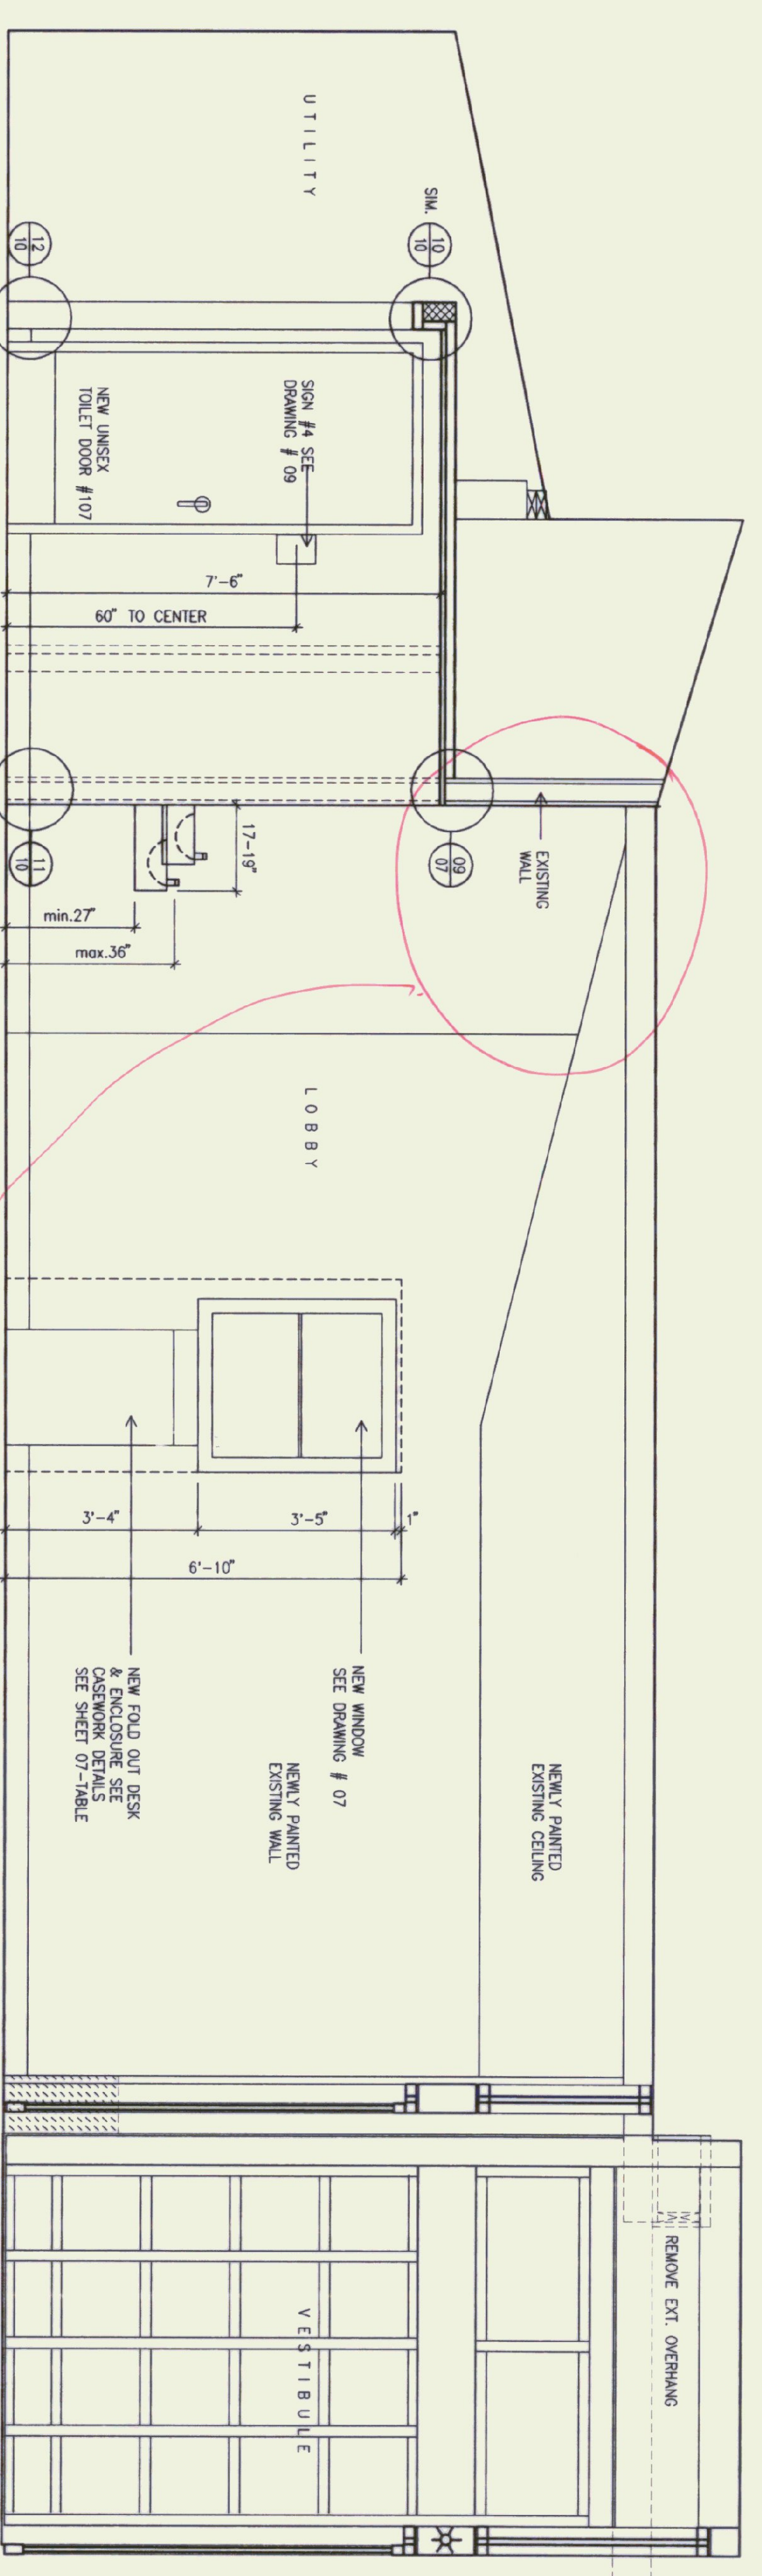


NORTH ELEVATION

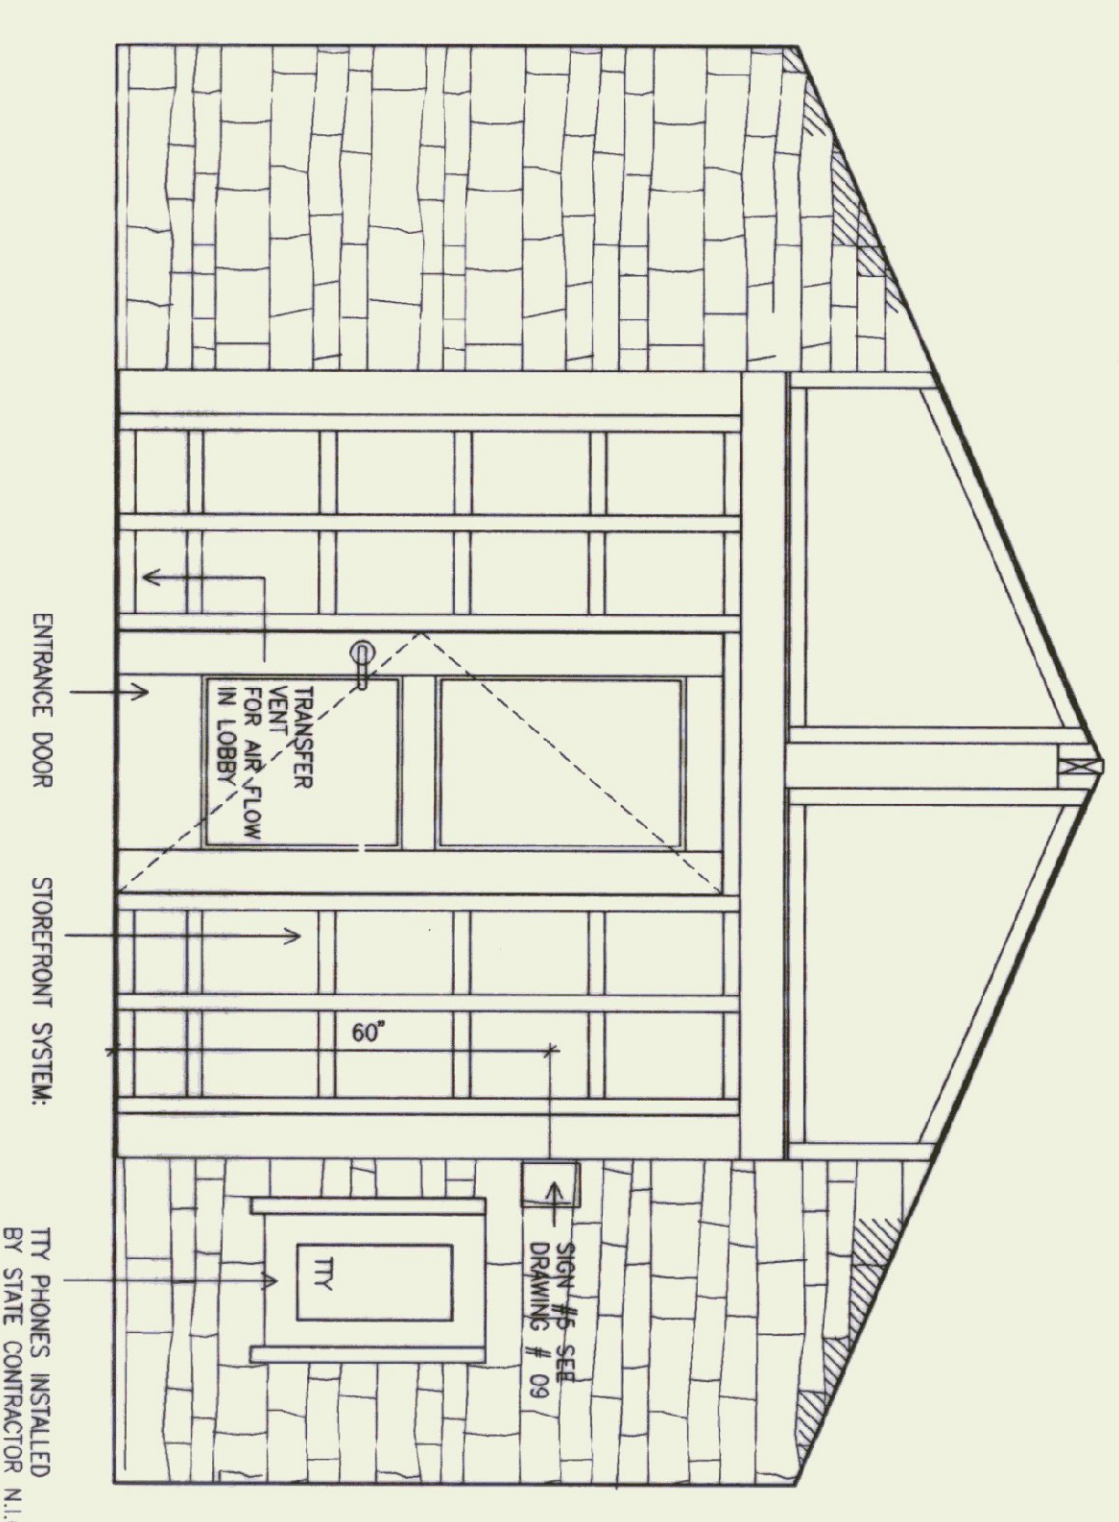


EAST ELEVATION

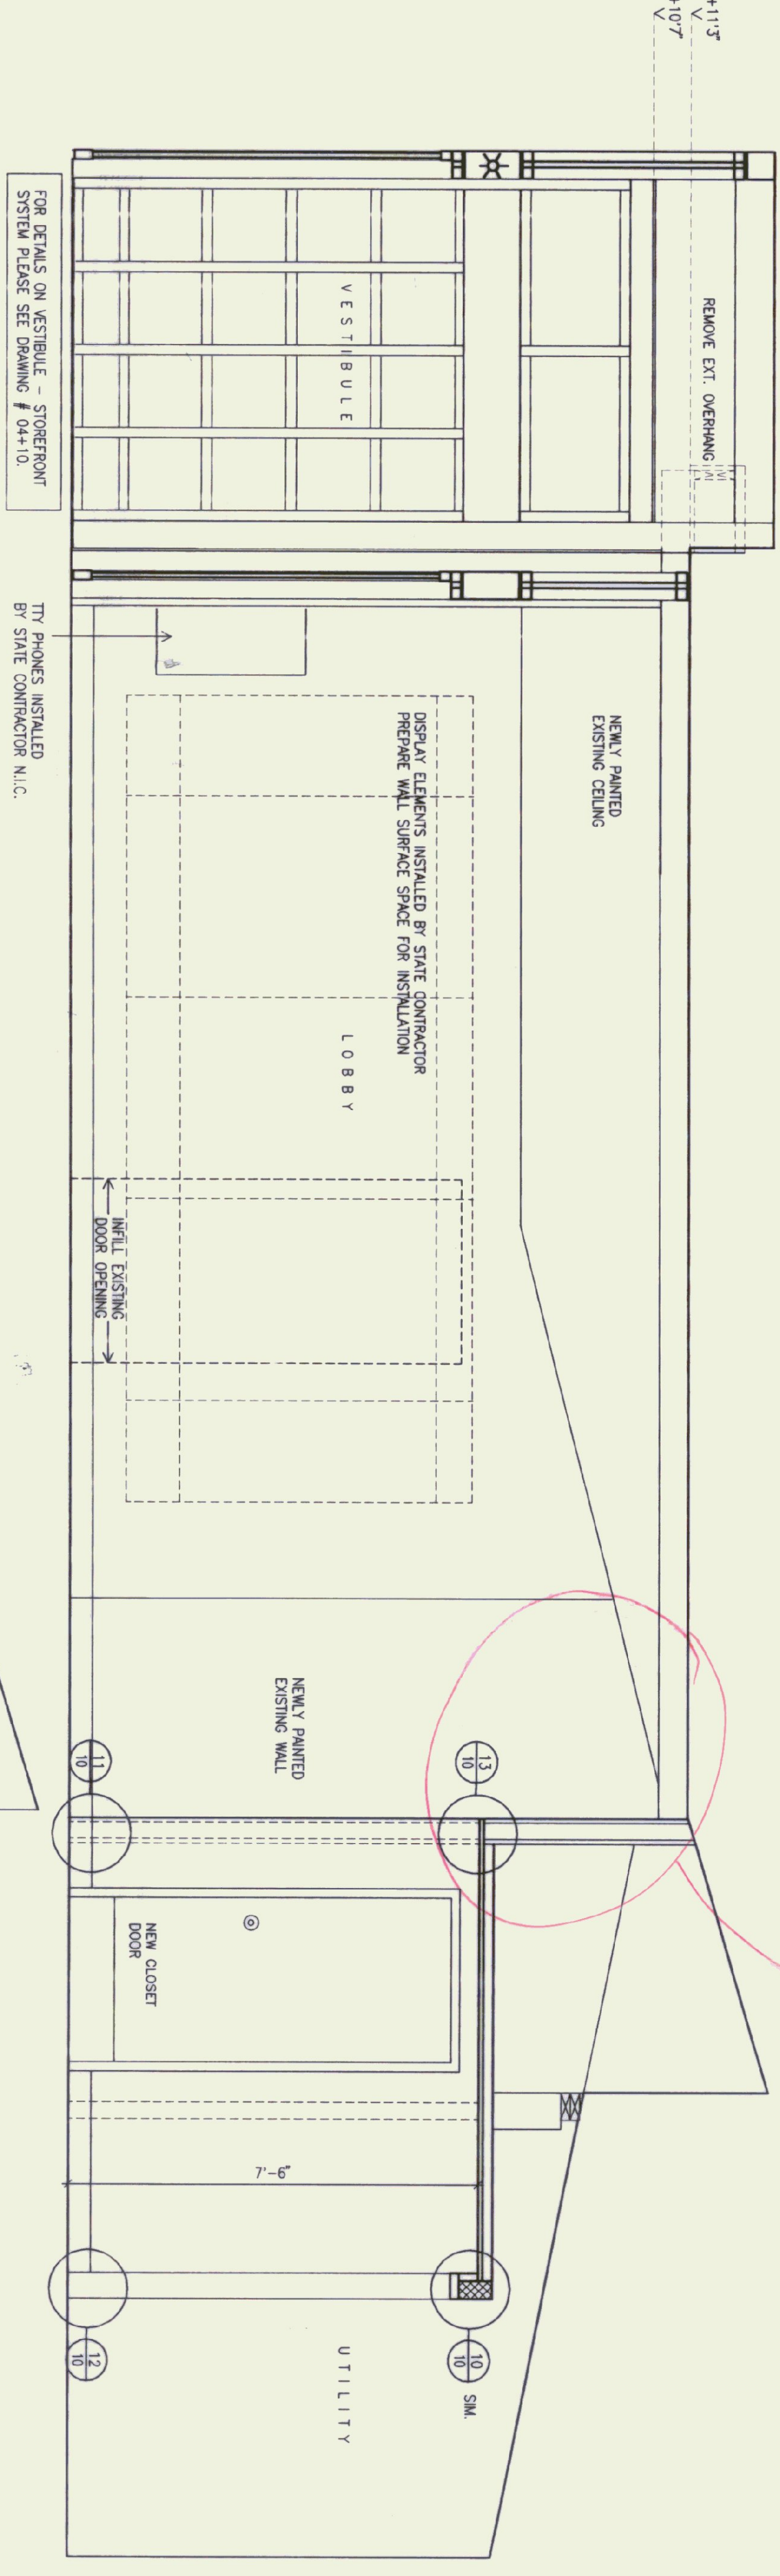


SOUTH ELEVATION

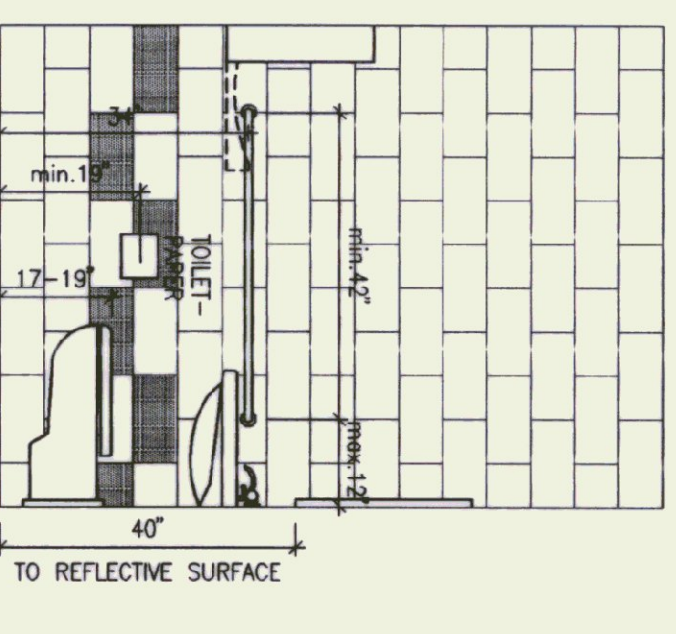


ELEVATION 1

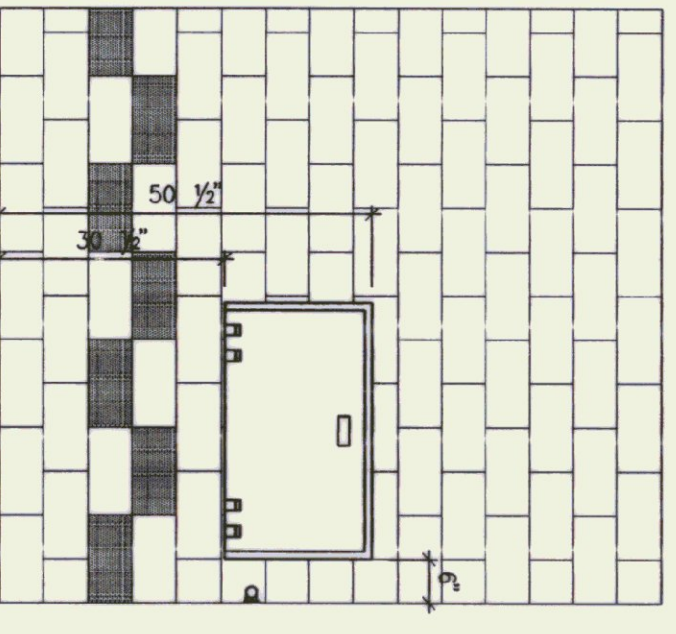


ELEVATION 2

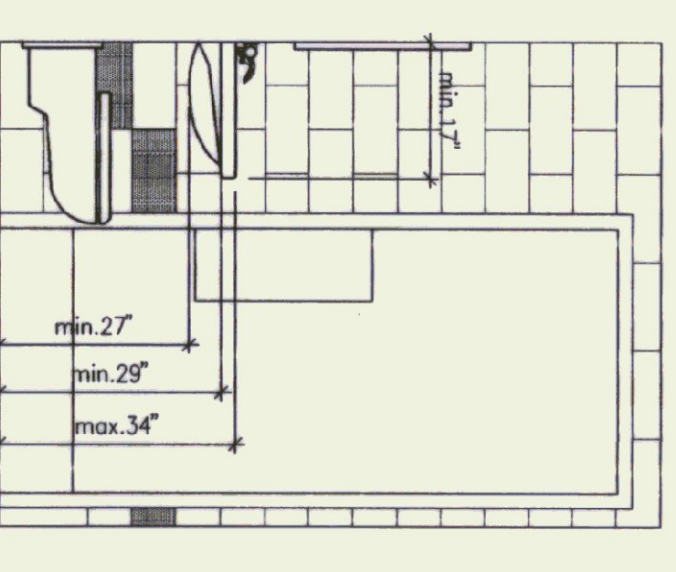


ELEVATION 3

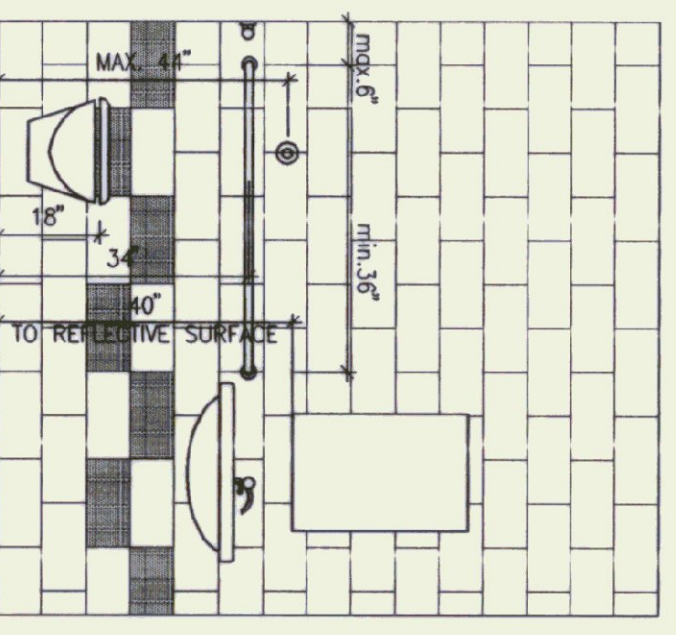


ELEVATION 4

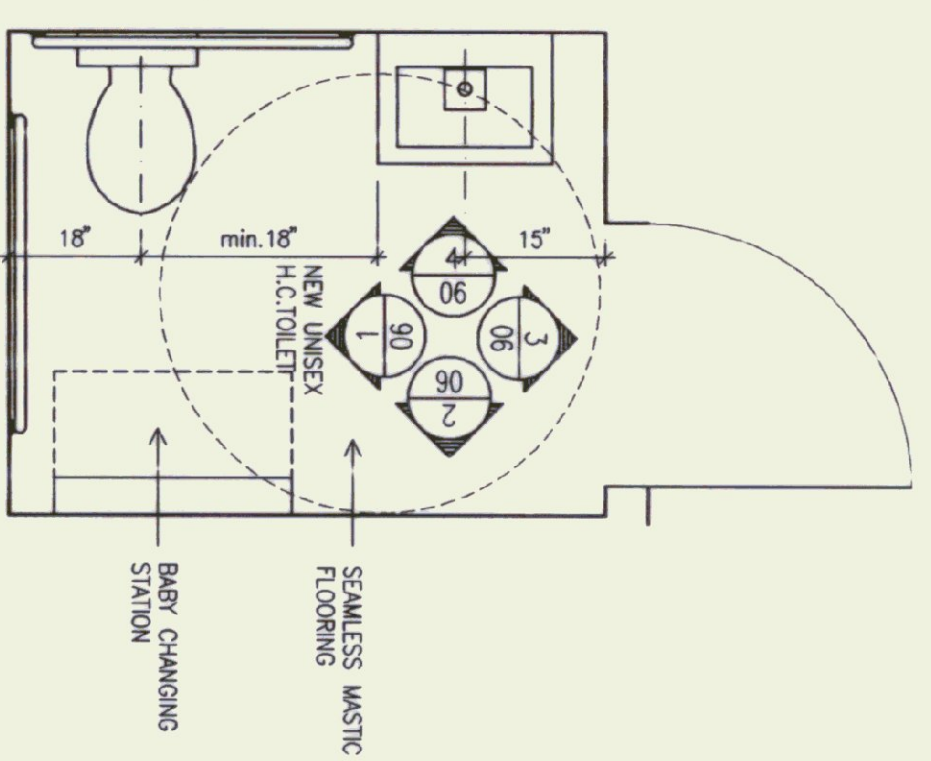

PLAN

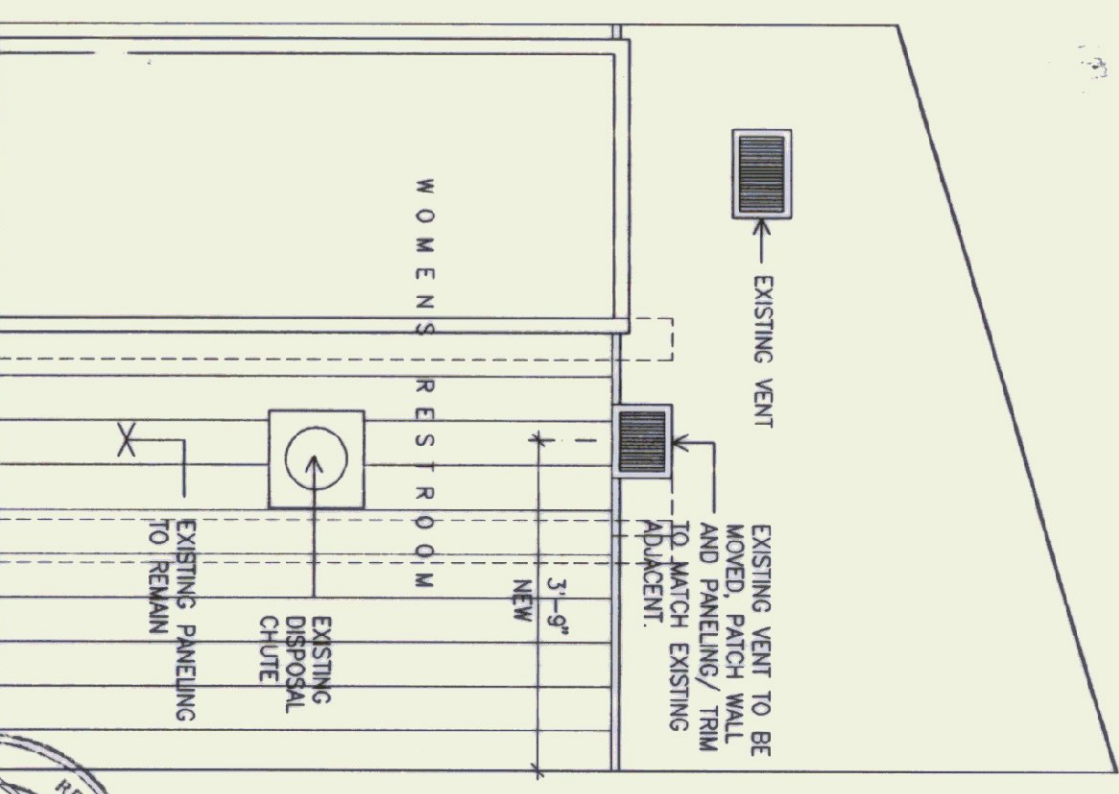

ELEV. WOMEN RESTROOM

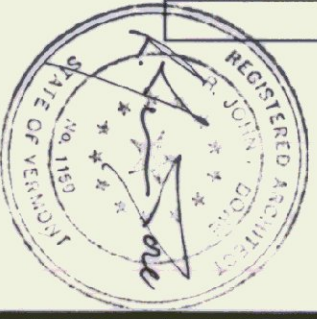

<p>STATE OF VERMONT DEPARTMENT OF STATE BUILDINGS AGENCY OF ADMINISTRATION MONTPELIER, VERMONT</p>			
<p>REST AREA REHABILITATION LYNDON I-91 SOUTHBOUND INTERIOR ELEVATIONS</p>			
DATE:	JUNE 8, 2005	SCALE:	1/2"=4'-0"
DRAWN BY:	JBA	PROJECT NO.:	IM-BLDG(2)
APPROVED BY:	JBA	DRAWING NO.:	06
SHEET			9 OF 29