


*1. See make-ups
2. Note re: forward's work "by show"*

YOUR Northeastern Log Home BLUEPRINTS

<input type="checkbox"/> Reviewed (No Comment)
<input checked="" type="checkbox"/> Reviewed (See Comment)
<input type="checkbox"/> Reviewed (Resubmit)

Checked only for conformance with the design concept of the project and with the information given in the contract documents; review of shop drawings shall not release the contractor from responsibility for deviations from drawings and specifications. Shop drawings, including schedules, quantities, dimensions, fabrication, installation and coordination requirements, shall be submitted to the Contractor. The Contractor shall check and verify all field measurements.

Date 10-7-96
JOE AND WHITTIER, INC.
 Architects, Project Managers

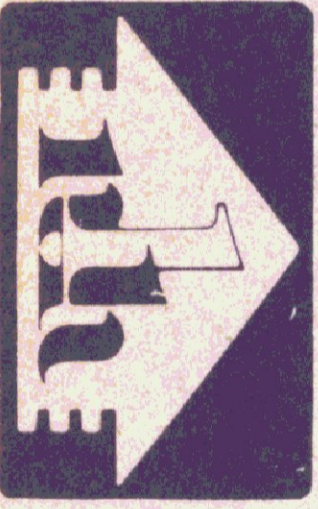

© 1996 BY N.L.H. INC.

D-96

JAN. 1, 1996