AS BUILTS
DATE: 7/21/99

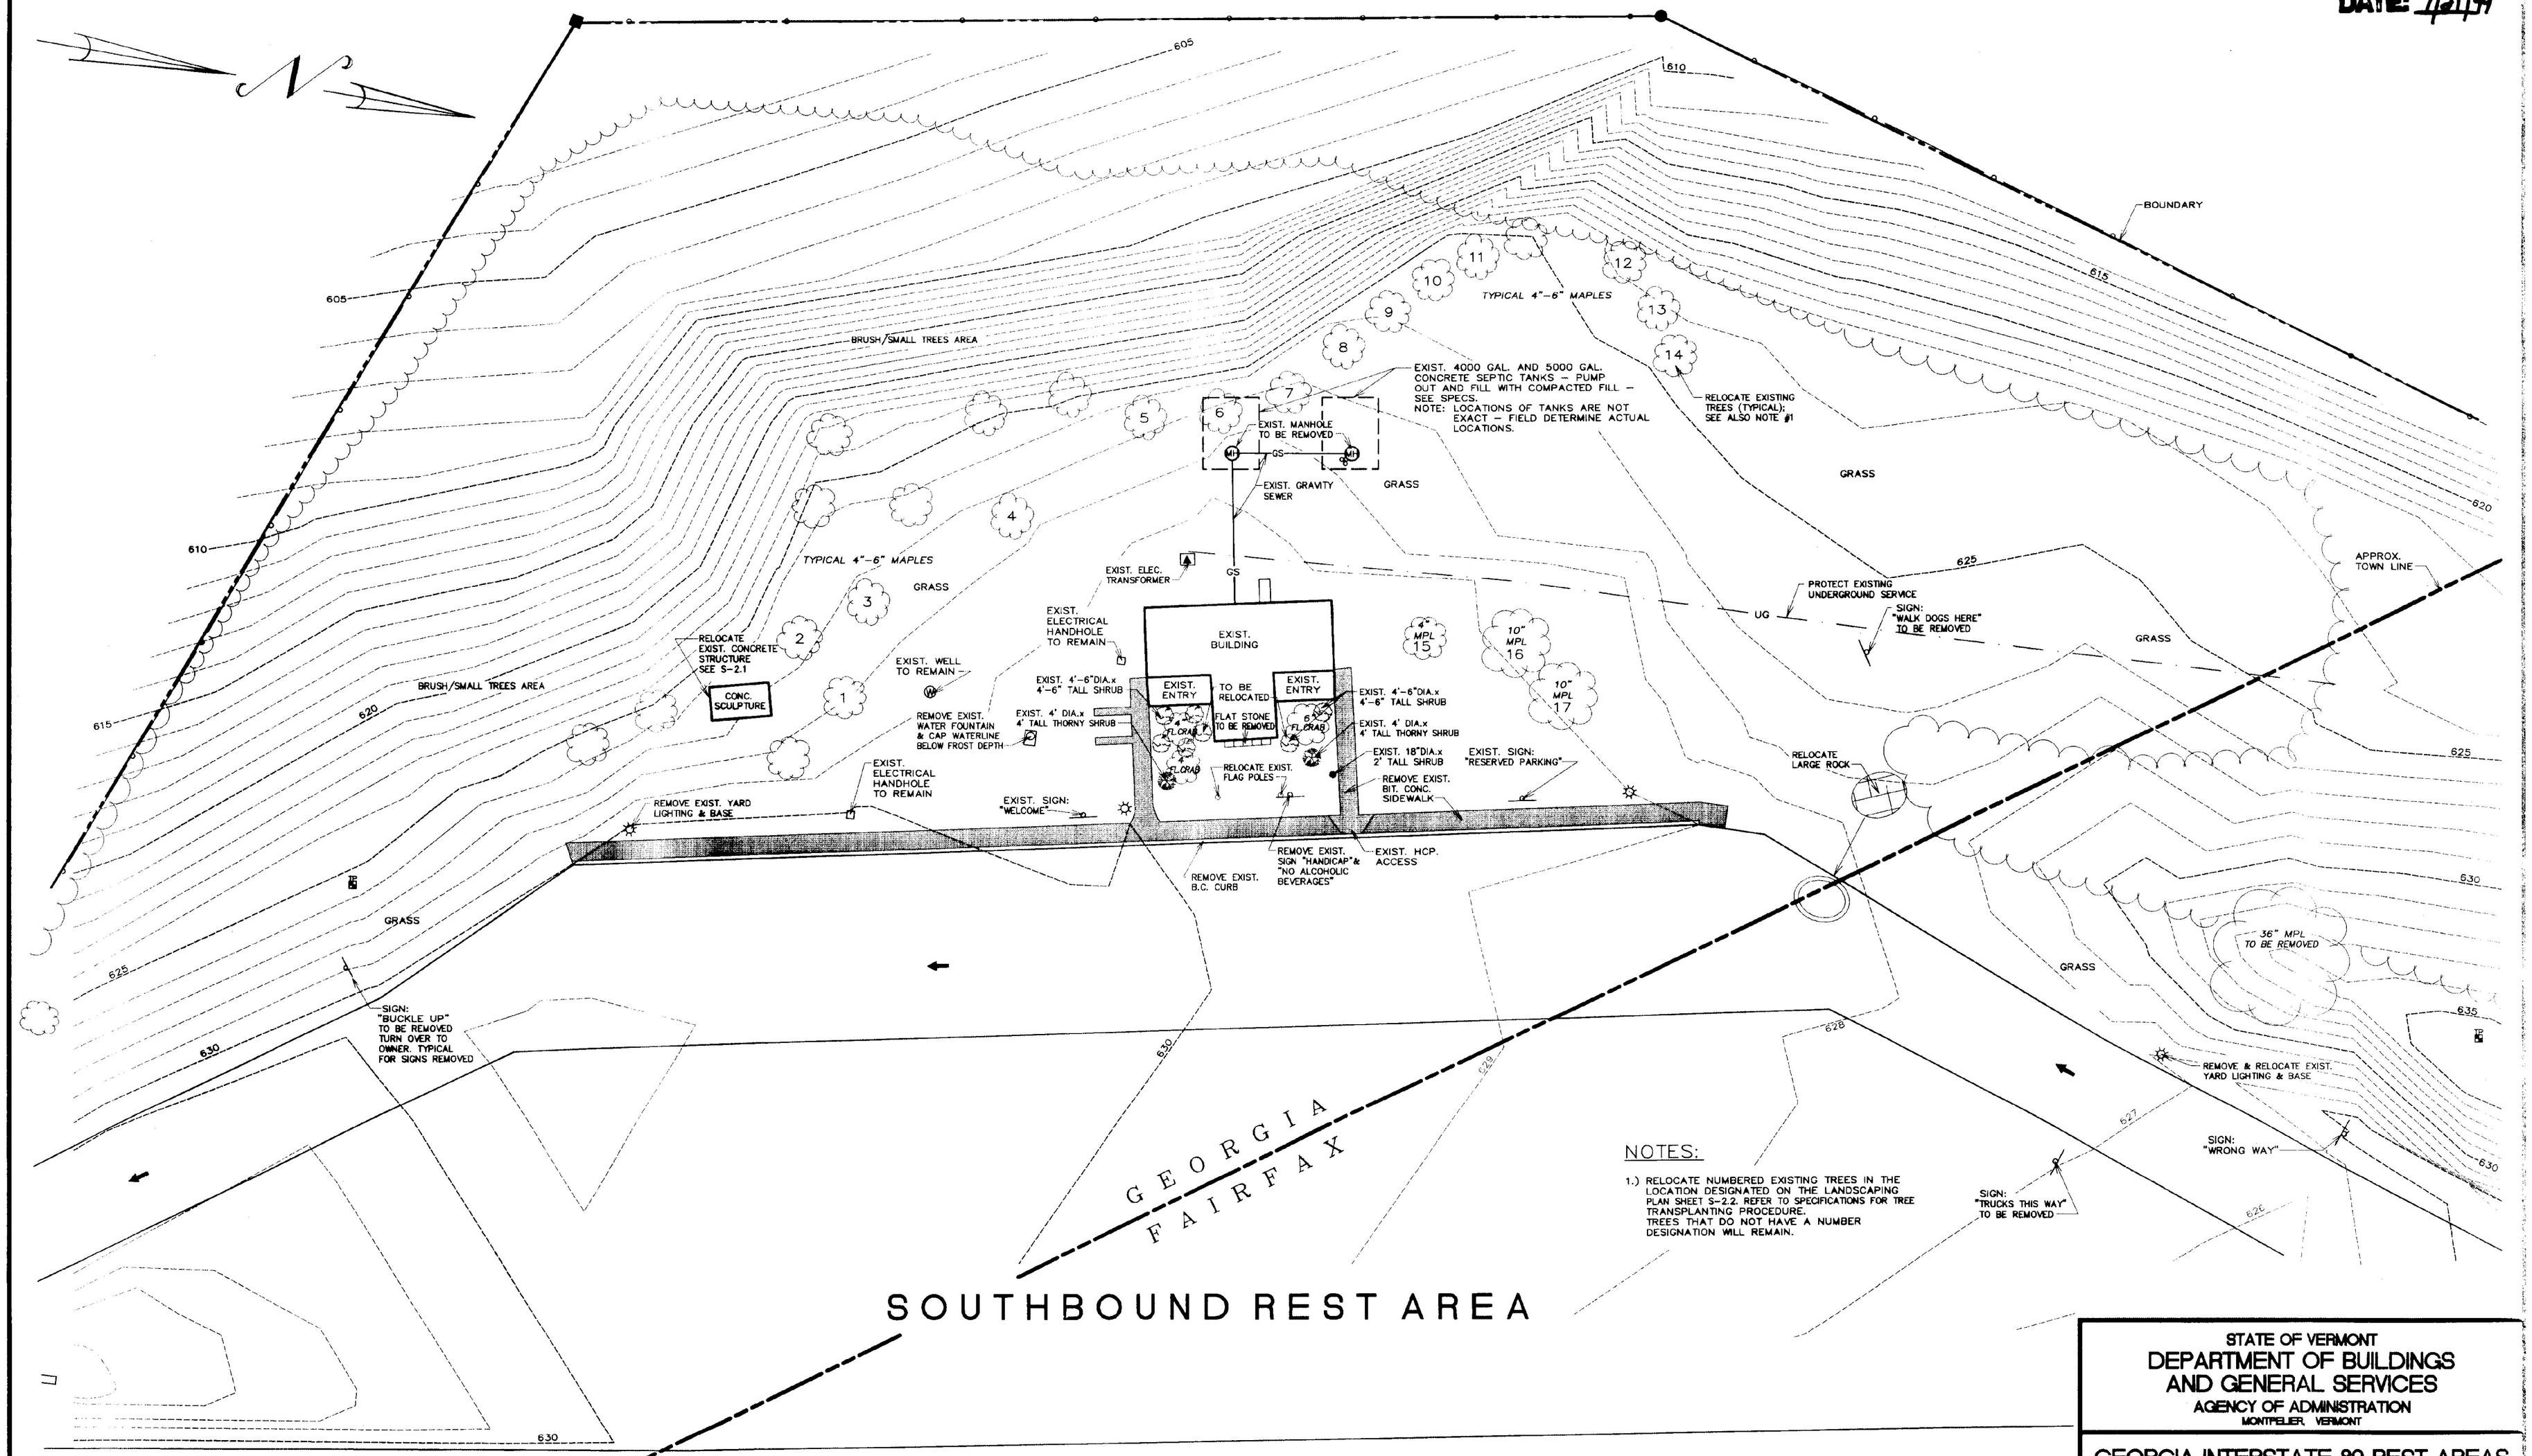

NOTES:

1.) RELOCATE NUMBERED EXISTING TREES IN THE LOCATION DESIGNATED ON THE LANDSCAPING PLAN SHEET S-2.2. REFER TO SPECIFICATIONS FOR TREE TRANSPLANTING PROCEDURE. TREES THAT DO NOT HAVE A NUMBER DESIGNATION WILL REMAIN.

STATE OF VERMONT
DEPARTMENT OF BUILDINGS AND GENERAL SERVICES
AGENCY OF ADMINISTRATION
MONTPELIER, VERMONT

GEORGIA INTERSTATE 89 REST AREAS
NORTHBOUND AND SOUTHBOUND

DATE: AUG 21, 1998	SCALE: AS NOTED	REVISIONS: 8/12/99 Miscellaneous	DRAWING NAME: SOUTHBOUND DEMOLITION PLAN
DRAWN BY: WHP/ksc	PROJECT NO. 97041		DRAWING NO: S-2.0
CHECKED BY: SHR/PHC			

SHEET ____ OF ____
DATE PLOTTED: 8/21/98