AS BUILTS
DATE: 7/21/99

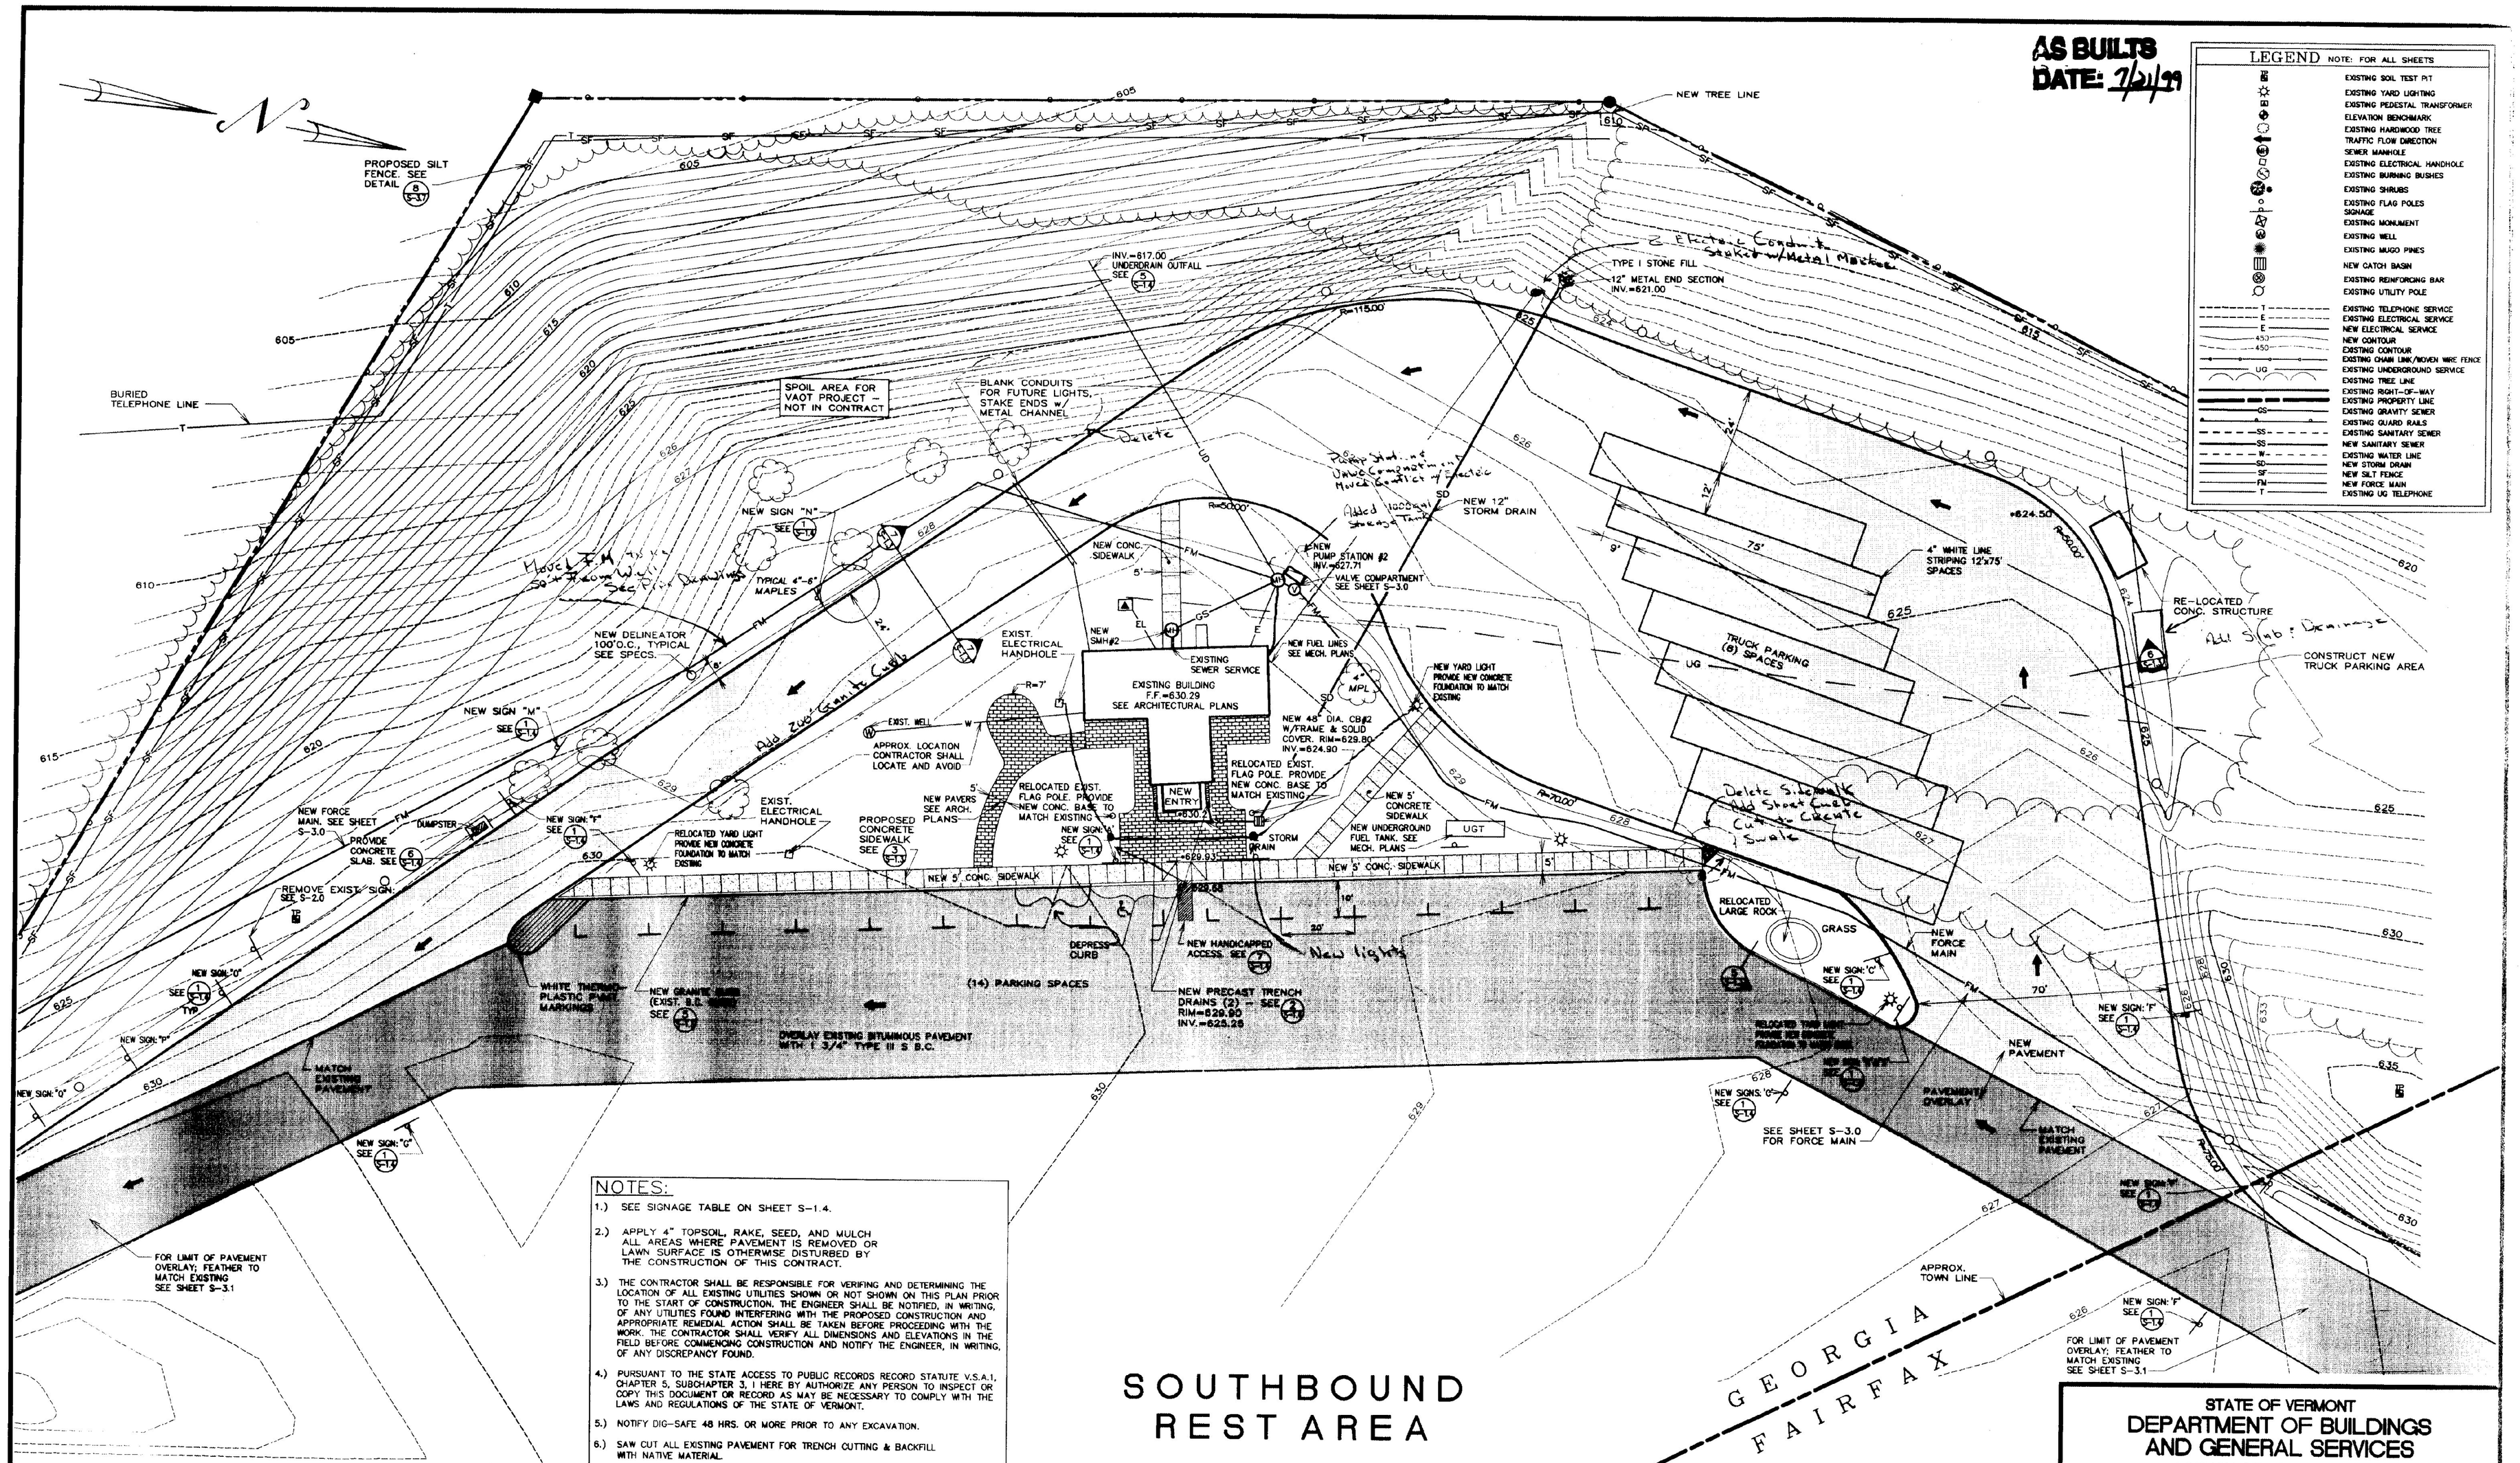

NOTES:

1.) SEE SIGNAGE TABLE ON SHEET S-1.4.

2.) APPLY 4" TOPSOIL, RAKE, SEED, AND MULCH ALL AREAS WHERE PAVEMENT IS REMOVED OR LAWN SURFACE IS OTHERWISE DISTURBED BY THE CONSTRUCTION OF THIS CONTRACT.

3.) THE CONTRACTOR SHALL BE RESPONSIBLE FOR VERIFING AND DETERMINING THE LOCATION OF ALL EXISTING UTILITIES SHOWN OR NOT SHOWN ON THIS PLAN PRIOR TO THE START OF CONSTRUCTION. THE ENGINEER SHALL BE NOTIFIED, IN WRITING, OF ANY UTILITIES FOUND INTERFERING WITH THE PROPOSED CONSTRUCTION AND APPROPRIATE REMEDIAL ACTION SHALL BE TAKEN BEFORE PROCEEDING WITH THE WORK. THE CONTRACTOR SHALL VERIFY ALL DIMENSIONS AND ELEVATIONS IN THE FIELD BEFORE COMMENCING CONSTRUCTION AND NOTIFY THE ENGINEER, IN WRITING, OF ANY DISCREPANCY FOUND.

4.) PURSUANT TO THE STATE ACCESS TO PUBLIC RECORDS RECORD STATUTE V.S.A.1, CHAPTER 5, SUBCHAPTER 3, I HERE BY AUTHORIZE ANY PERSON TO INSPECT OR COPY THIS DOCUMENT OR RECORD AS MAY BE NECESSARY TO COMPLY WITH THE LAWS AND REGULATIONS OF THE STATE OF VERMONT.

5.) NOTIFY DIG-SAFE 48 HRS. OR MORE PRIOR TO ANY EXCAVATION.

6.) SAW CUT ALL EXISTING PAVEMENT FOR TRENCH CUTTING & BACKFILL WITH NATIVE MATERIAL.

STATE OF VERMONT
DEPARTMENT OF BUILDINGS AND GENERAL SERVICES
AGENCY OF ADMINISTRATION
MONTPELIER, VERMONT

GEORGIA INTERSTATE 89 REST AREAS
NORTHBOUND AND SOUTHBOUND

DATE: AUG 21, 1998	SCALE: 1"=20'	REVISIONS: 8/12/99 Miscellaneous	DRAWING NAME: SOUTHBOUND SITE PLAN
DRAWN BY: WHP/kac	PROJECT NO. 97041		DRAWING NO: S-2.1
CHECKED BY: SHR/PHC			

SHEET ____ OF ____