




VALVE SCHEDULE

VALVE NO.	STATION	TYPE
11	153+00	SEWAGE COMBO AIR VALVE
12	166+50	SEWAGE COMBO AIR VALVE


PLAN VIEW
SCALE: 1" = 100'

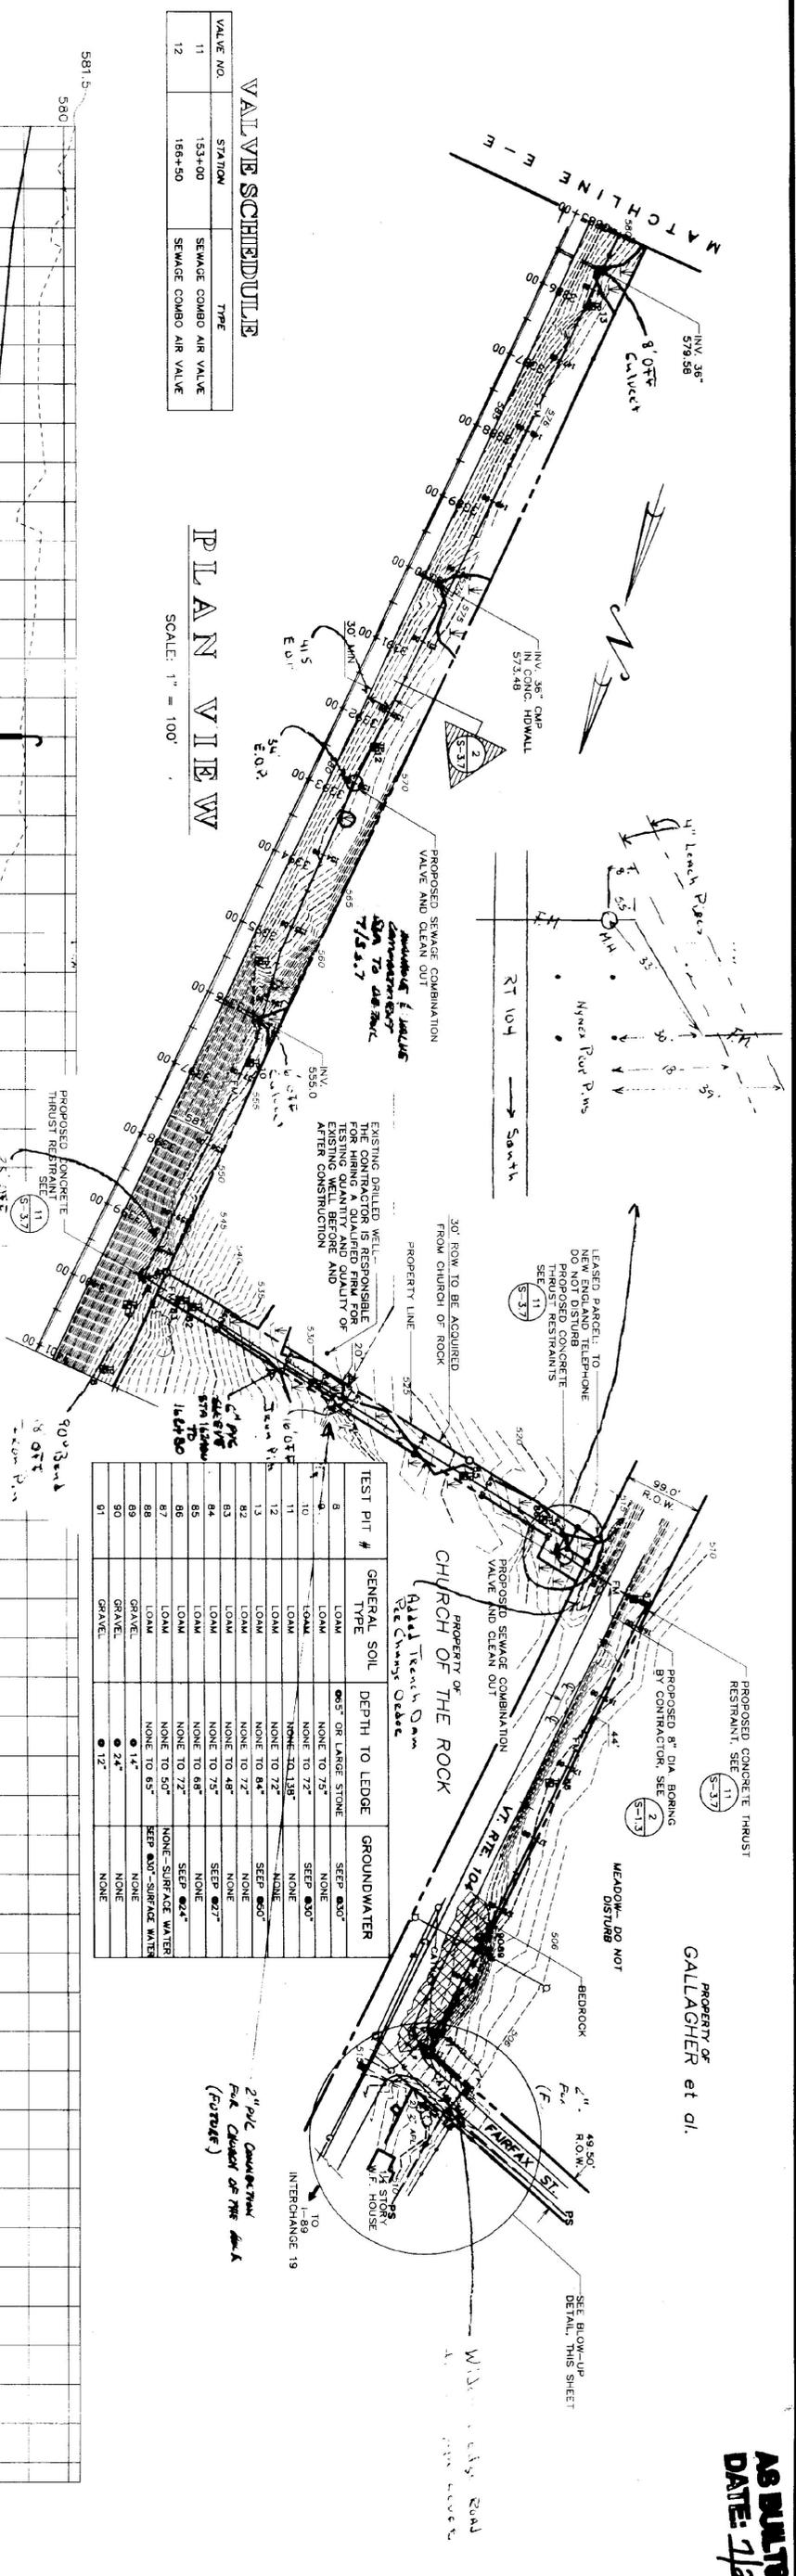

TEST PIT #	GENERAL SOIL TYPE	DEPTH TO LEDGE	GROUNDWATER

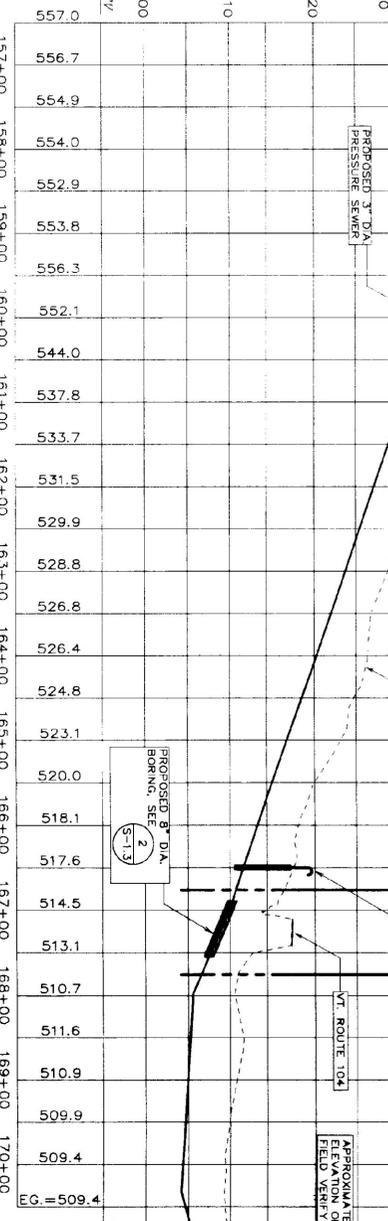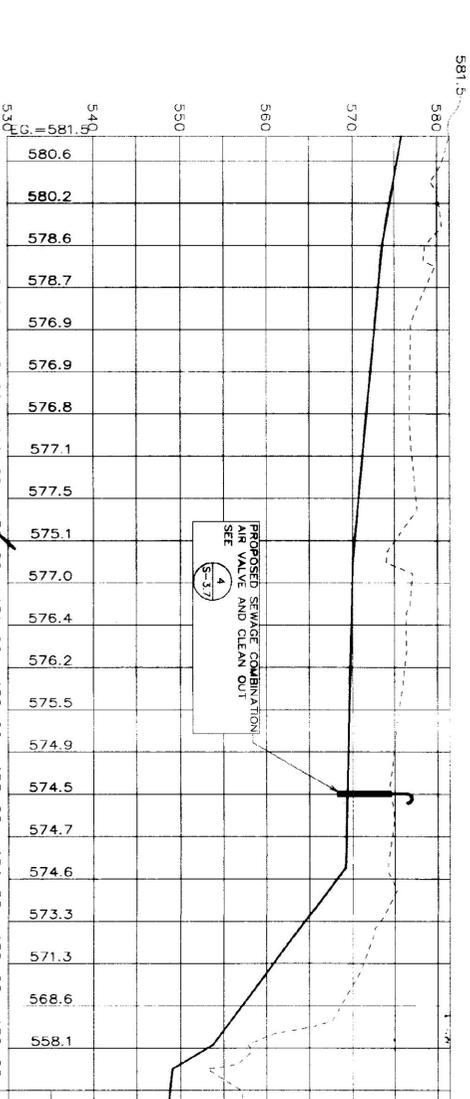

PROFILE
SCALE: 1" = 100' HORIZ.
1" = 10' VERT.

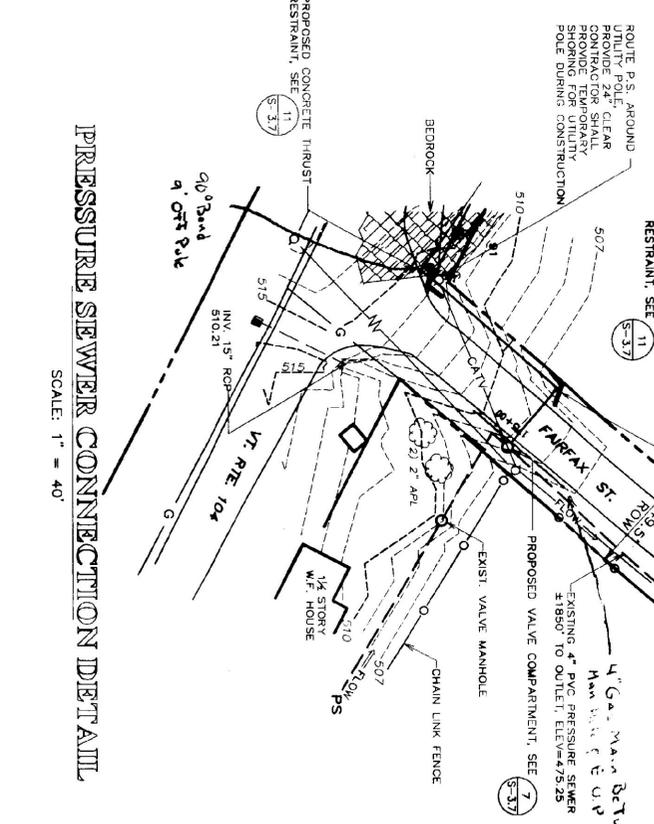

- NOTES:**
- 1) TEST PIT DATA GATHERED IN THE SPRING OF 1998. GROUNDWATER CONDITIONS WILL VARY. A MINIMUM OF 48" OF COVER WHEN CROSSING SWALES AND 60" MINIMUM IN A TYPICAL RUN.
 - 2) WHERE STONE LINED DITCHES ARE DISTURBED, SALVAGE AND REPLACE EXISTING STONE.
 - 3) AND RE-LINE DITCH TO MATCH EXISTING.
 - 4) USE 4" INSULATION OVER FORCE MAIN AT ALL WATERWAY CROSSINGS.
- SEE DETAIL 12, SHEET 3.7

**STATE OF VERMONT
DEPARTMENT OF BUILDINGS
AND GENERAL SERVICES
AGENCY OF ADMINISTRATION
MONTPELIER, VERMONT**

**GEORGIA INTERSTATE 89 REST AREAS
NORTHBOUND AND SOUTHBOUND**

DATE:	21 AUGUST 1998	SCALE:	1"=40'	REVISIONS:	
DRAWN BY:	WHT/BD	PROJECT NO.:	9704	DRAWING NAME:	PLAN AND PROFILE
CHECKED BY:	RHC			DRAWING NO.:	S-3.5