
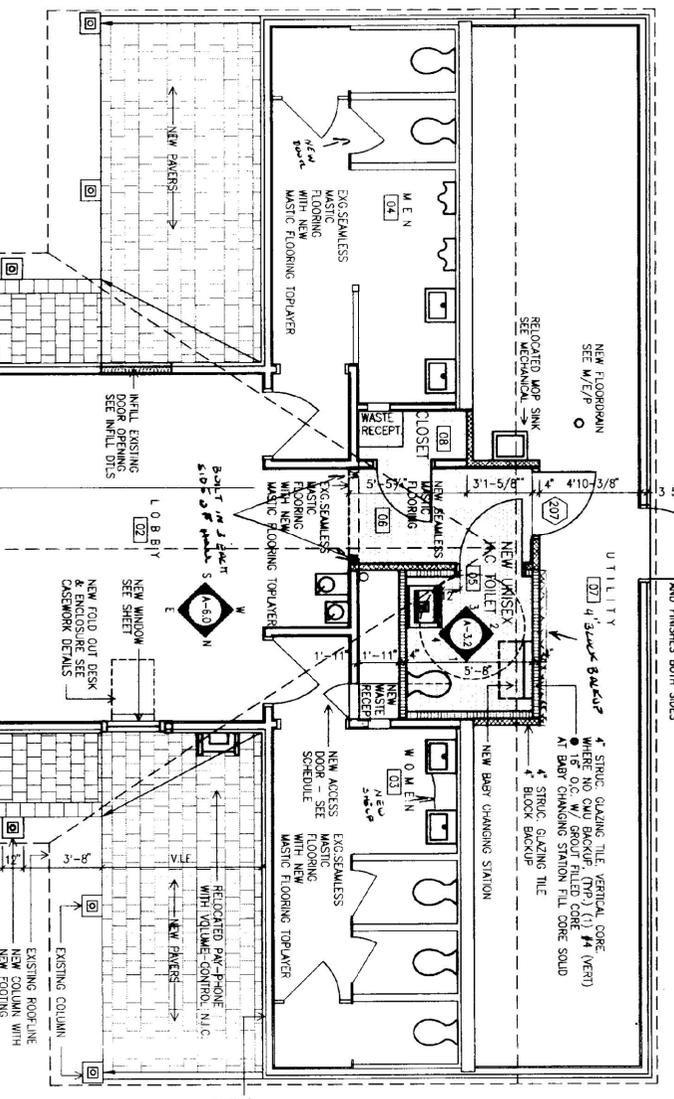


**1 EXISTING FLOOR PLAN**  
SCALE: 1/4" = 1'


- NOTES**
- REMOVE ANY EXISTING HANDICAPPED SIGNAGE AT RESTROOMS AND SIGNAGE THAT DOES NOT COMPLY - SEE MECH / ELEC FOR ADDITIONAL REMOVALS
  - SEE ELEVATIONS FOR ADDITIONAL REMOVALS

**LEGEND**

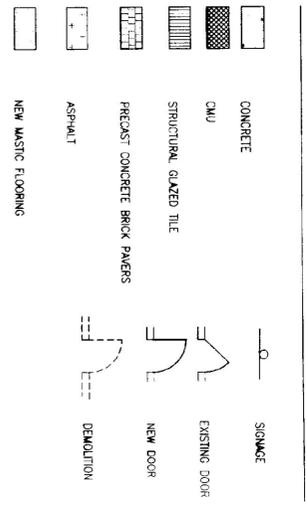

**2 NEW FLOOR PLAN**  
SCALE: 1/4" = 1'

- NOTES**
- INSTALL NEW HANDICAPPED SIGNAGE WHERE REQUIRED
  - INSTALL NEW SIGNAGE FOR BABY CHANGING STATION
  - SEE SITE DRAWINGS FOR CONTINUATION

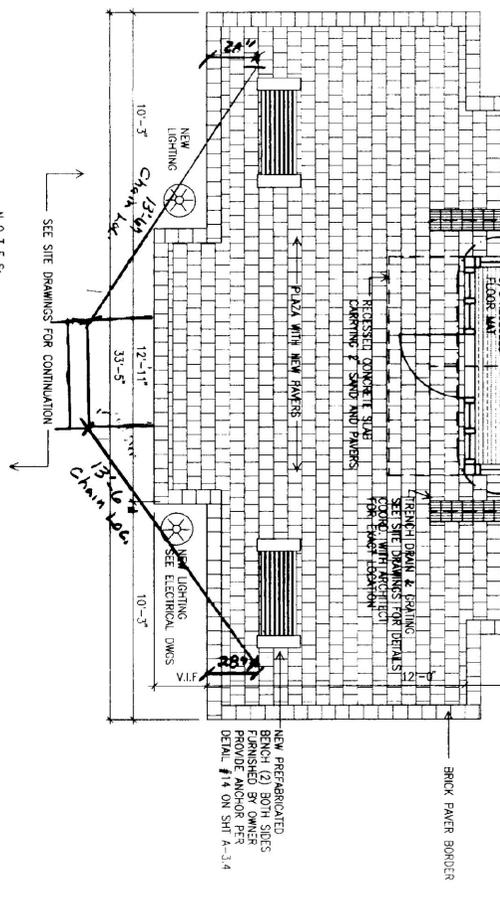

**STATE OF VERMONT  
DEPARTMENT OF BUILDINGS  
AND GENERAL SERVICES  
AGENCY OF ADMINISTRATION  
MONTPELIER, VERMONT**

**GEORGIA INTERSTATE 89 REST AREAS  
NORTHBOUND**

DATE: AUGUST 21, 1998	SCALE: 1/4" = 1'	REVISIONS:	DRAWING TITLE: BUILDING PLAN
DRAWN BY: MAB	PROJECT NO. M 098 3 (00)		DRAWING NO. A-10
CHECKED BY: JBA			

