AS BUILTS
DATE: 7/21/99

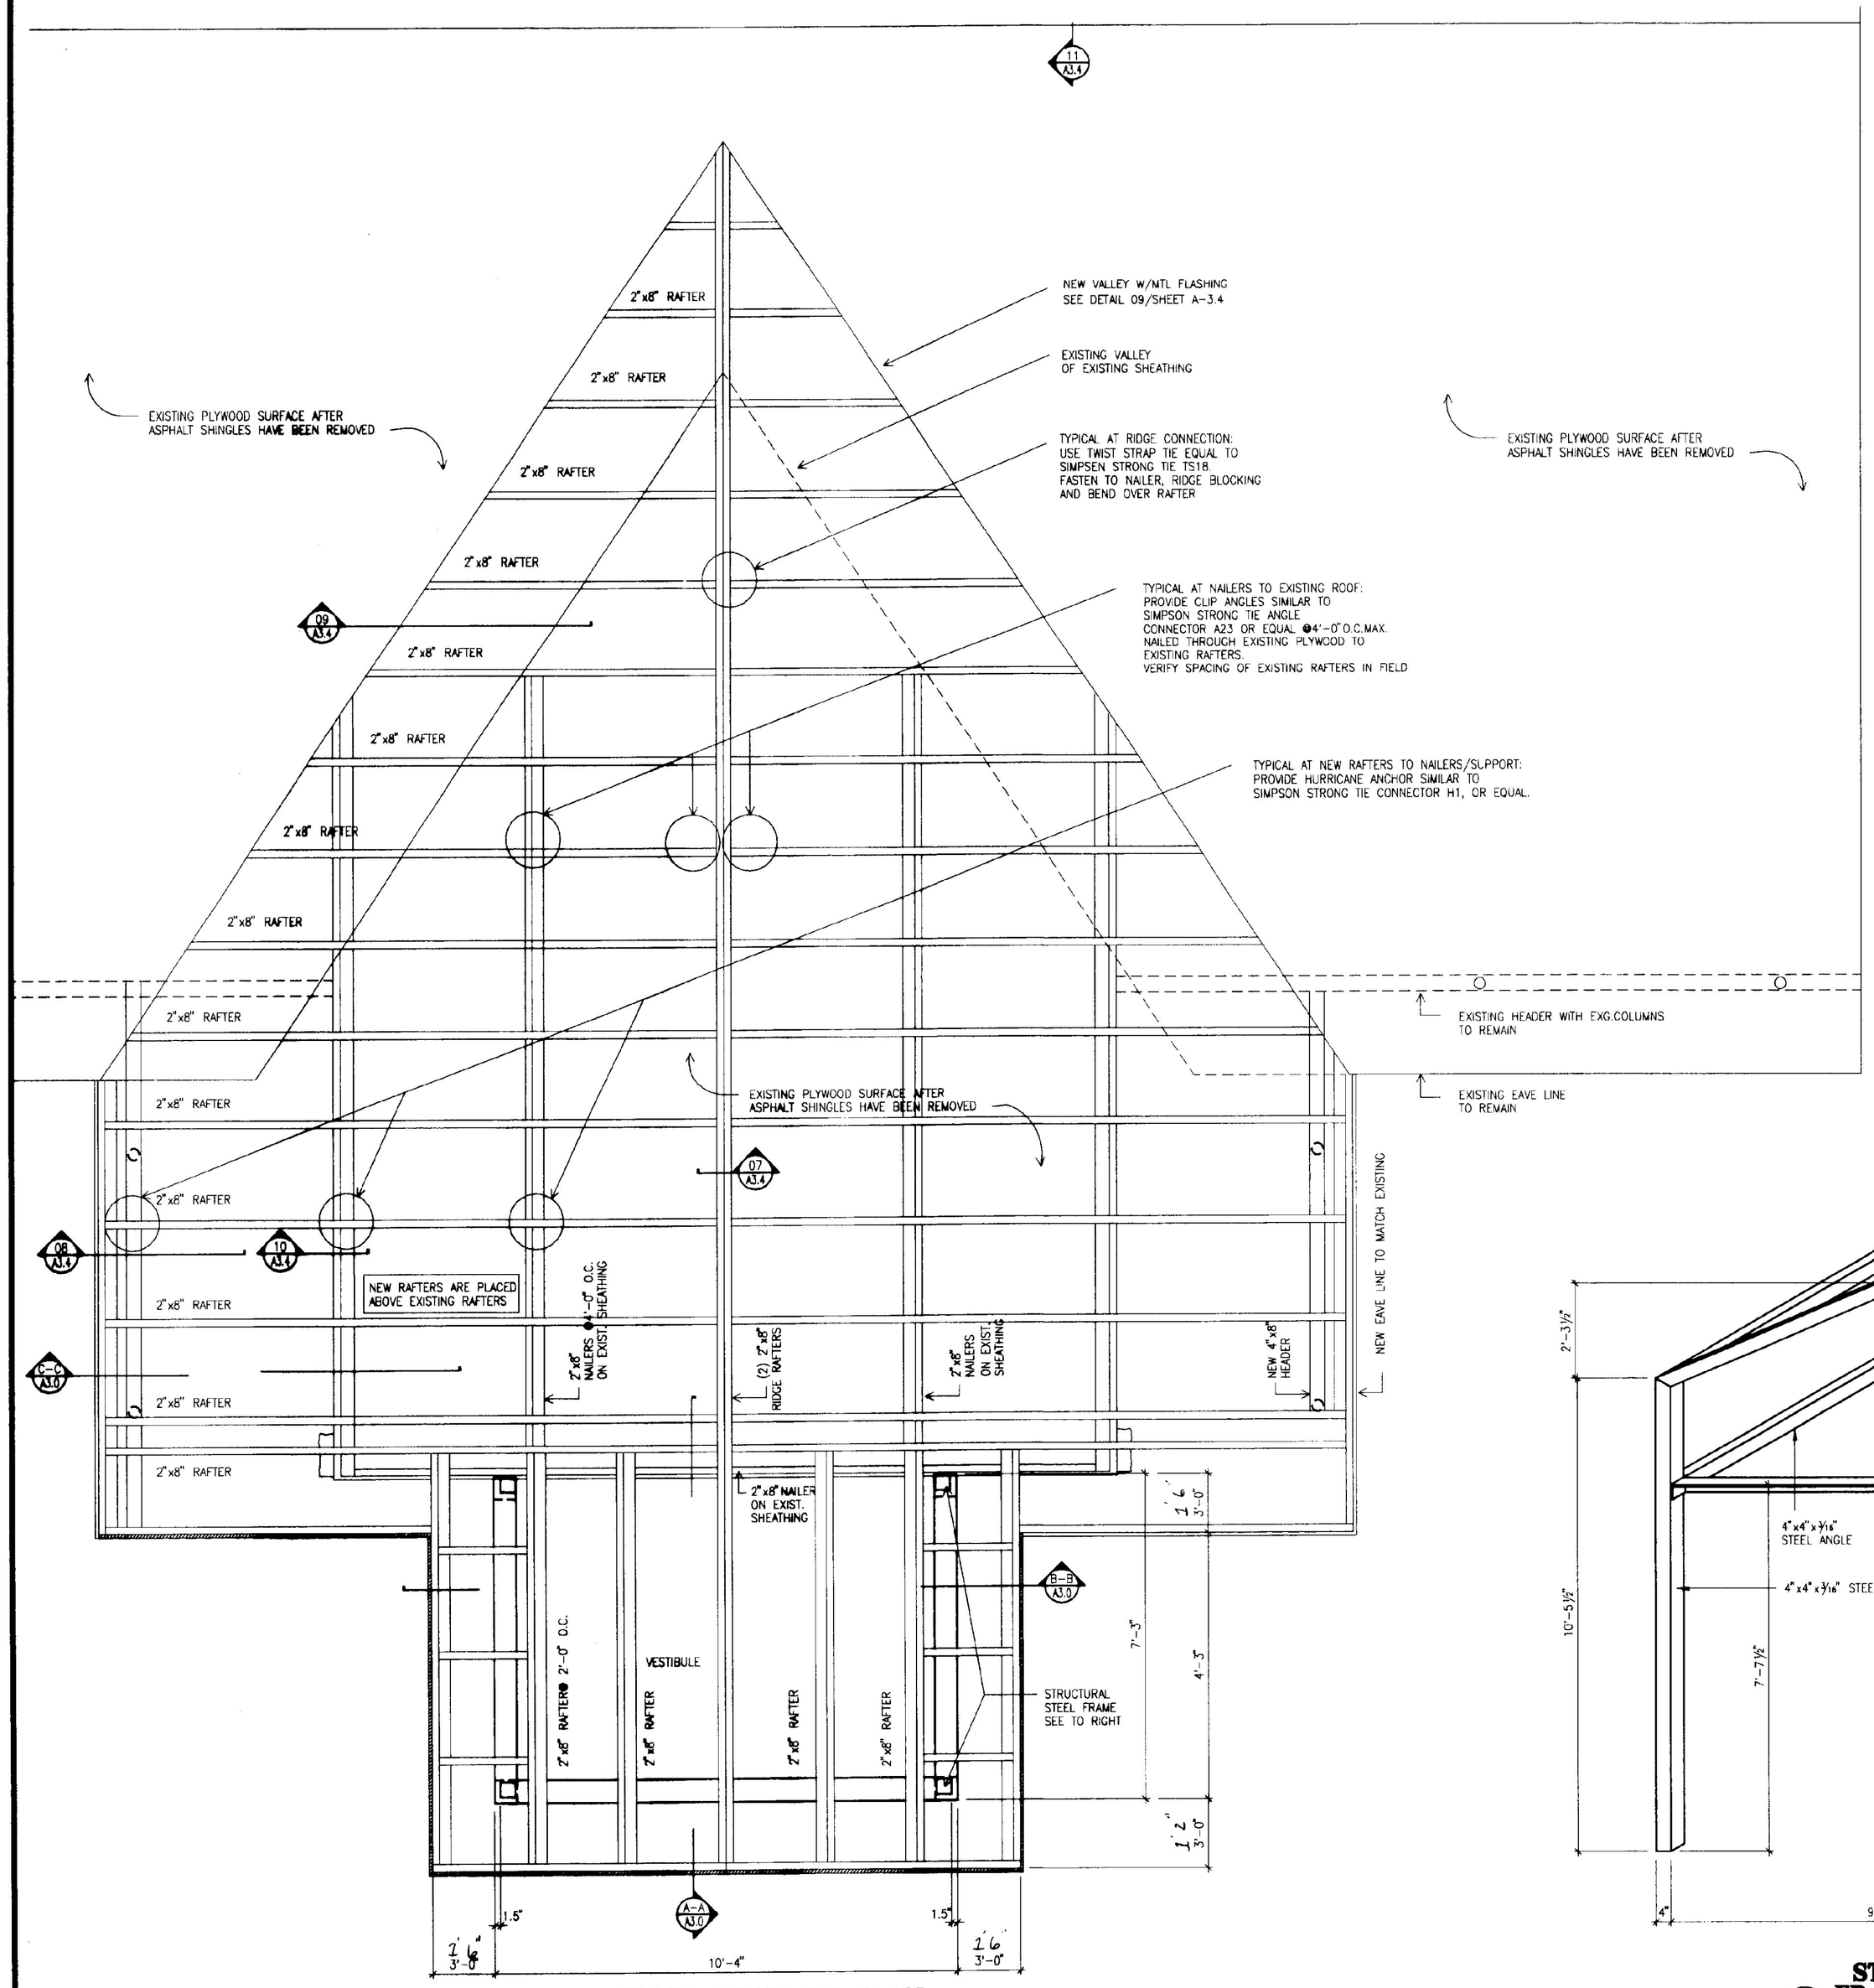

1 **WOOD FRAMING PLAN**
SCALE: 1/2" = 1'

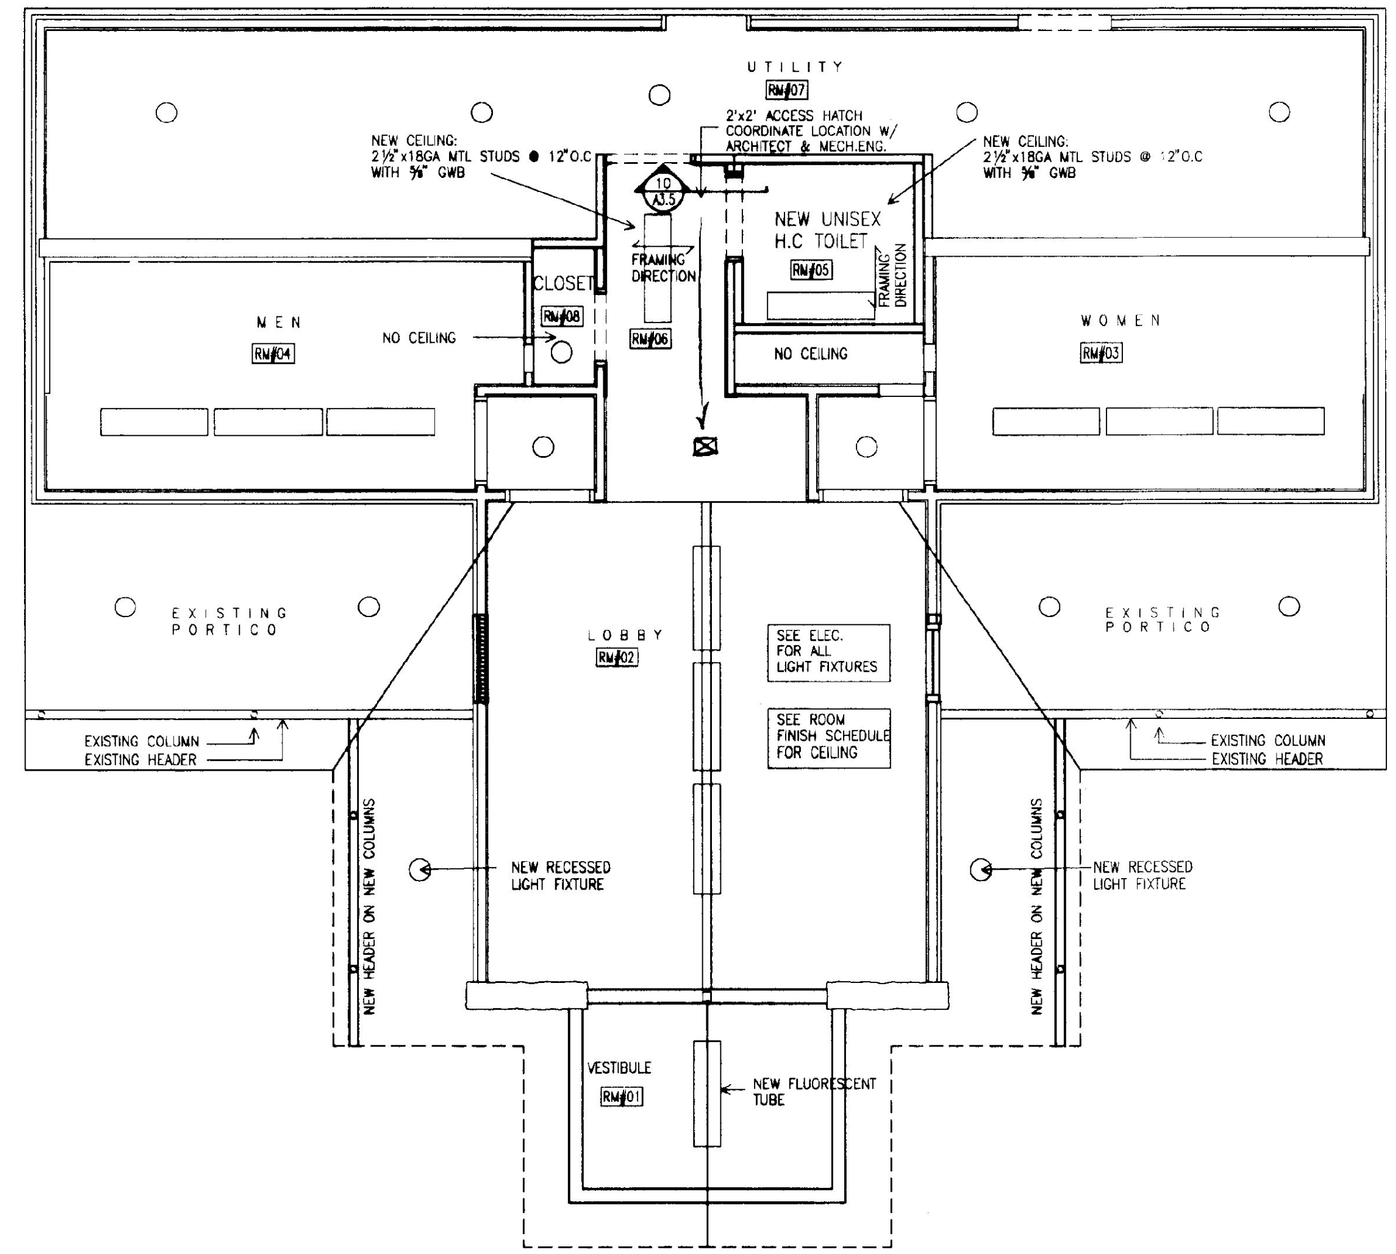

3 **REFLECTED CEILING PLAN**
SCALE: 1/4" = 1'

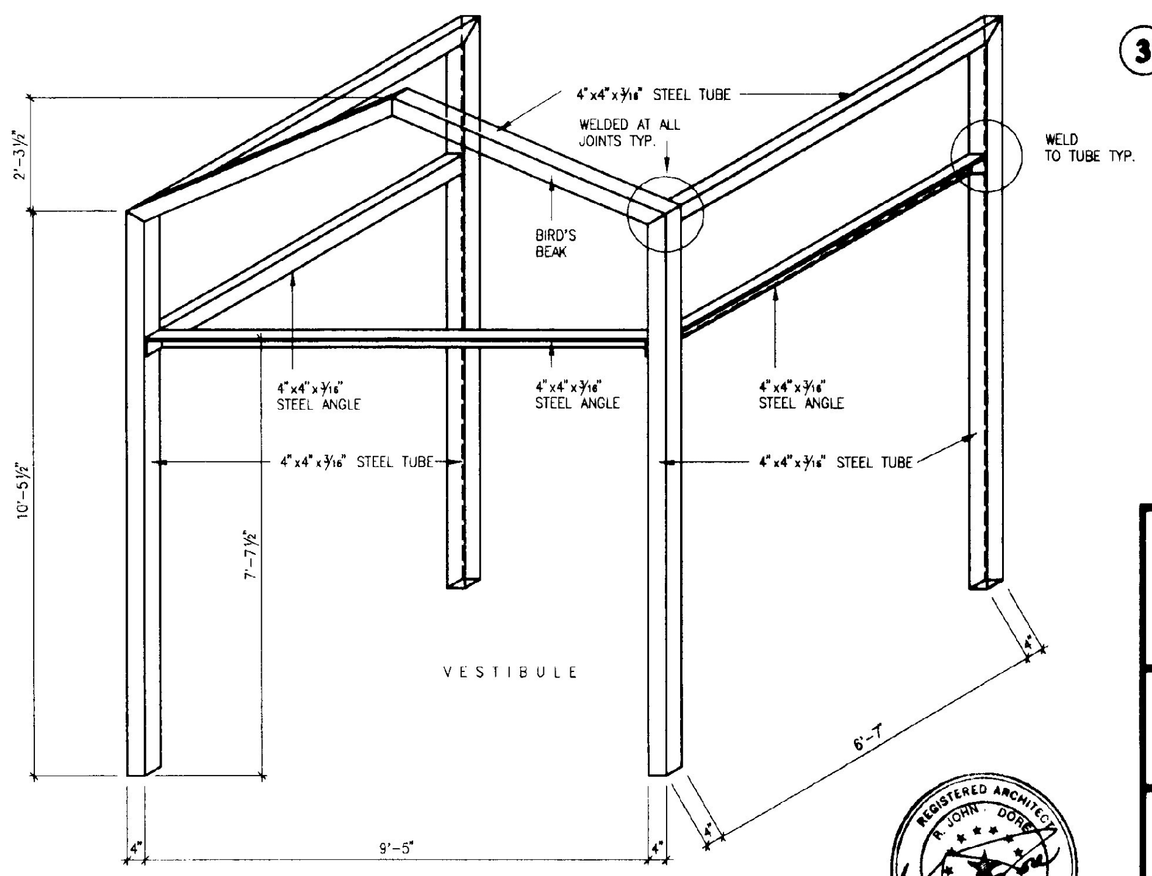

2 **STRUCTURAL STEEL FRAME AXONOMETRIC**
SCALE: 1/4" = 1'

REGISTERED ARCHITECT JOHN DORR No. 1159 STATE OF VERMONT

STATE OF VERMONT
DEPARTMENT OF BUILDINGS AND GENERAL SERVICES
AGENCY OF ADMINISTRATION
MONTPELIER, VERMONT

GEORGIA INTERSTATE 89 REST AREAS
NORTHBOUND AND SOUTHBOUND

DATE: AUGUST 21, 1998	SCALE:	REVISIONS:	DRAWING NAME: WOOD FRAME REFLECT. CLG PLAN
DRAWN BY: MBB	PROJECT NO. IM 089-3 (30)		DRAWING NO: A-3.1
CHECKED BY: JBA			