




1 WEST ELEVATION
SCALE: 1/2" = 1'

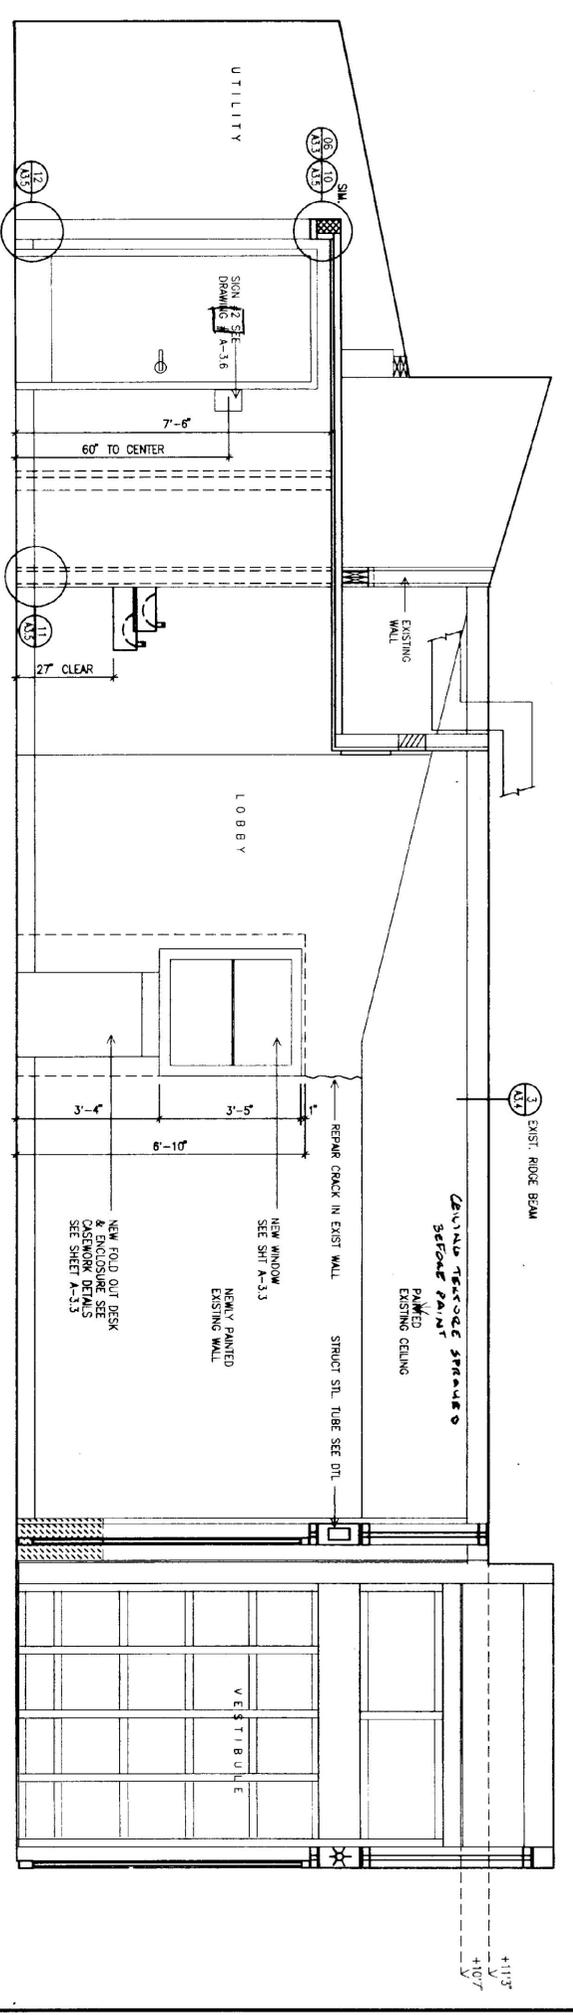


2 NORTH ELEVATION
SCALE: 1/2" = 1'

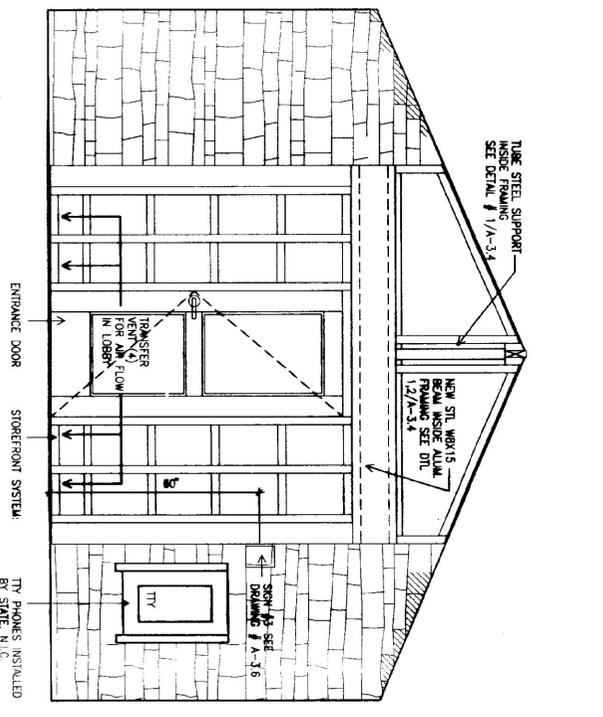


3 EAST ELEVATION
SCALE: 1/2" = 1'

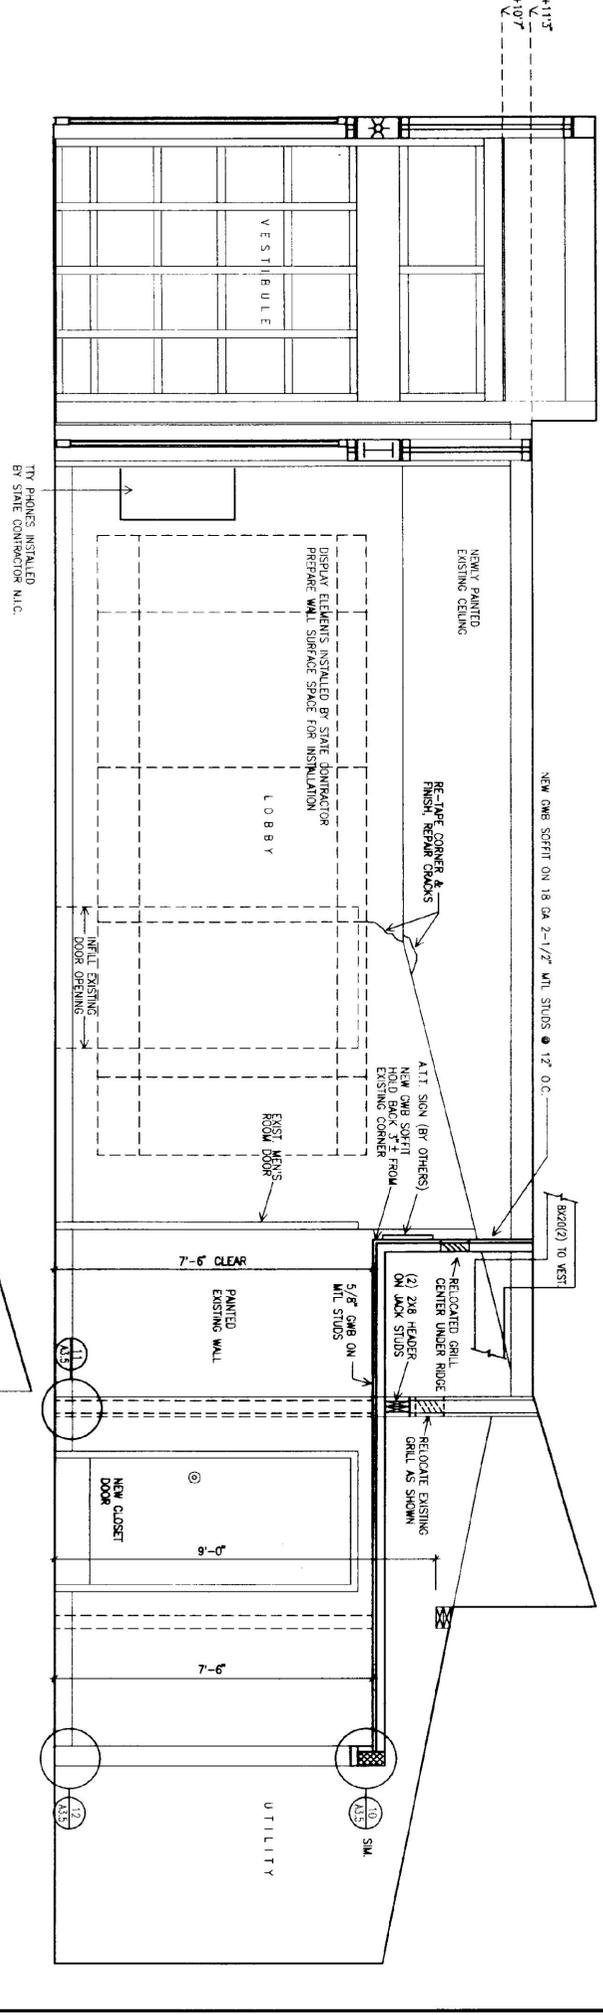


4 SOUTH ELEVATION
SCALE: 1/2" = 1'

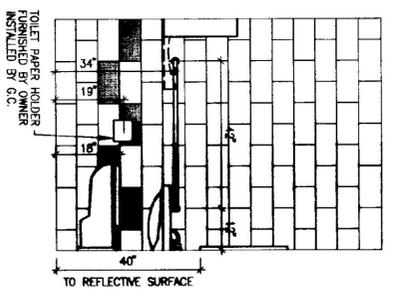


5 INTERIOR ELEVATION
SCALE: 1/2" = 1'

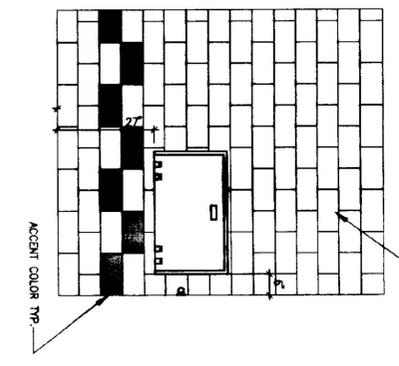


6 INTERIOR ELEVATION
SCALE: 1/2" = 1'

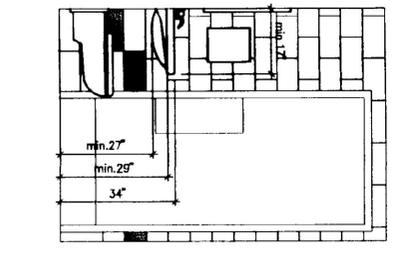


7 INTERIOR ELEVATION
SCALE: 1/2" = 1'

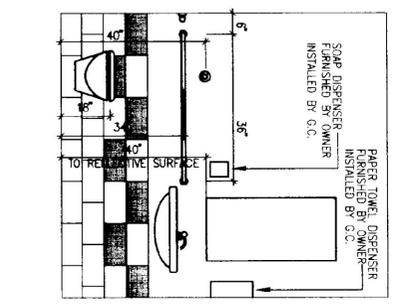

8 INTERIOR ELEVATION
SCALE: 1/2" = 1'

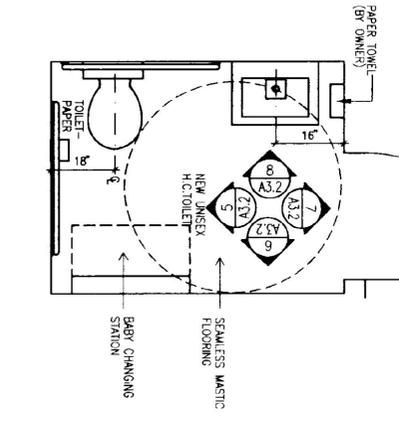

9 PLAN
SCALE: 1/2" = 1'

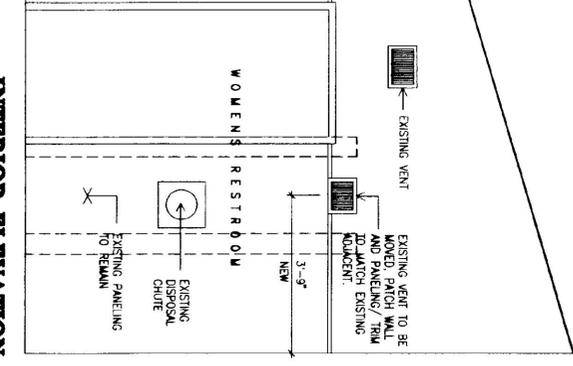

10 INTERIOR ELEVATION WOMEN'S RESTROOM
SCALE: 1/2" = 1'



<p>STATE OF VERMONT DEPARTMENT OF BUILDINGS AND GENERAL SERVICES AGENCY OF ADMINISTRATION CONTROLLER, VERMONT</p>			
<p>GEORGIA INTERSTATE 89 REST AREAS NORTHBOUND AND SOUTHBOUND</p>			
DATE:	SCALE:	REVISIONS:	DRAWING NAME:
AUGUST 21, 1988	1/2" = 1'		INTERIOR ELEVATIONS
DRAWN BY: LMB	PROJECT NO. M-088-3 (20)		DRAWING NO.:
CHECKED BY: JBA			A-3-2