AS BUILTS
DATE: 7/21/99

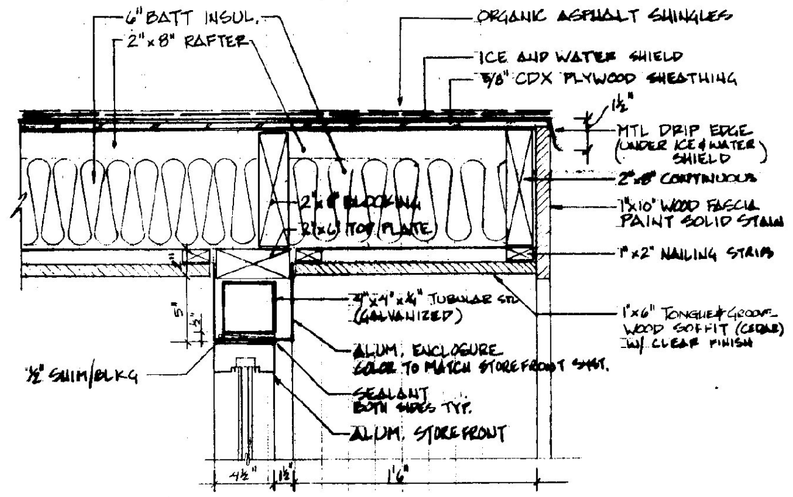

01 / 3.5 CONNECTION - STOREFRONT/ROOF
VESTIBULE 1 1/2"=1'-0"

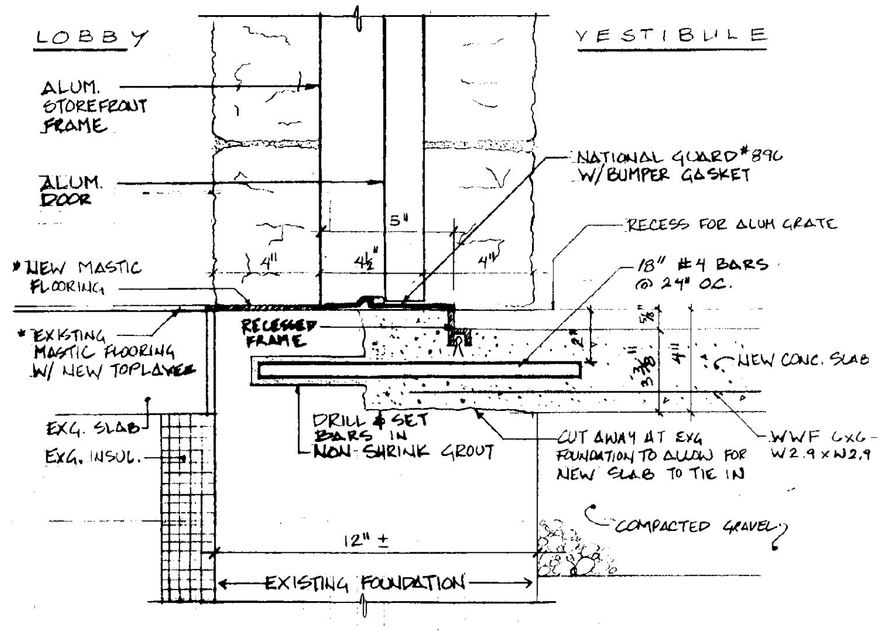

* NEW AND EXISTING MASTIC FLOORING SHALL BE AT THE SAME LEVEL AND SHALL APPEAR AS ONE CONTINUOUS FLOORING MATERIAL

05 / 3.5 2ND ENTRY THRESHOLD
VESTIBULE DOOR #202 3"=1'-0"

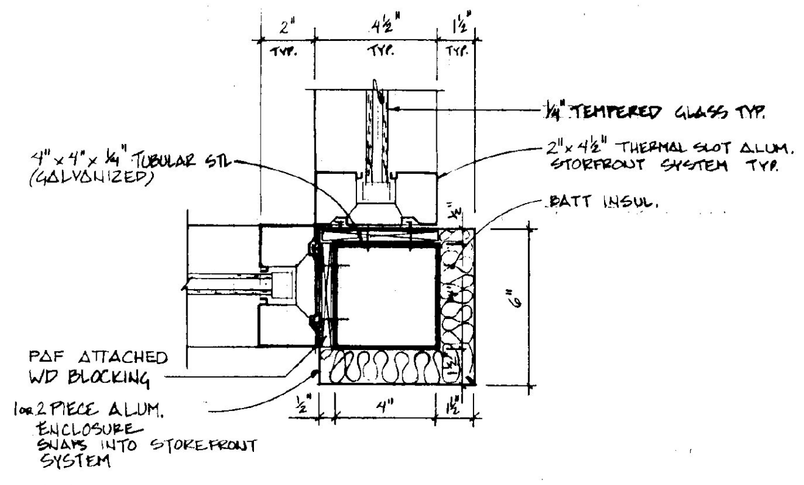

06 / 3.5 CORNER ENCLOSURE
VESTIBULE 3"=1'-0"

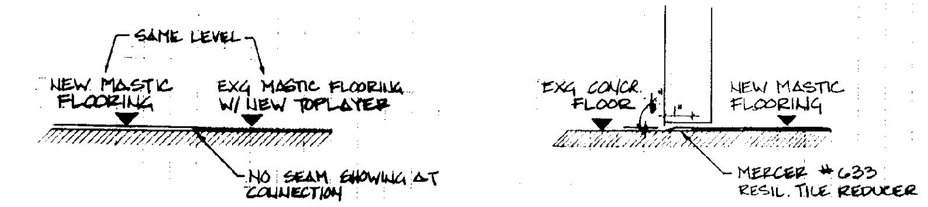

11 / 3.5 CONNECTION - NEW / EXG FLOORING
NO SCALE

12 / 3.5 TRANSITION - THRESHOLD
UTILITY DOOR #207 NO SCALE

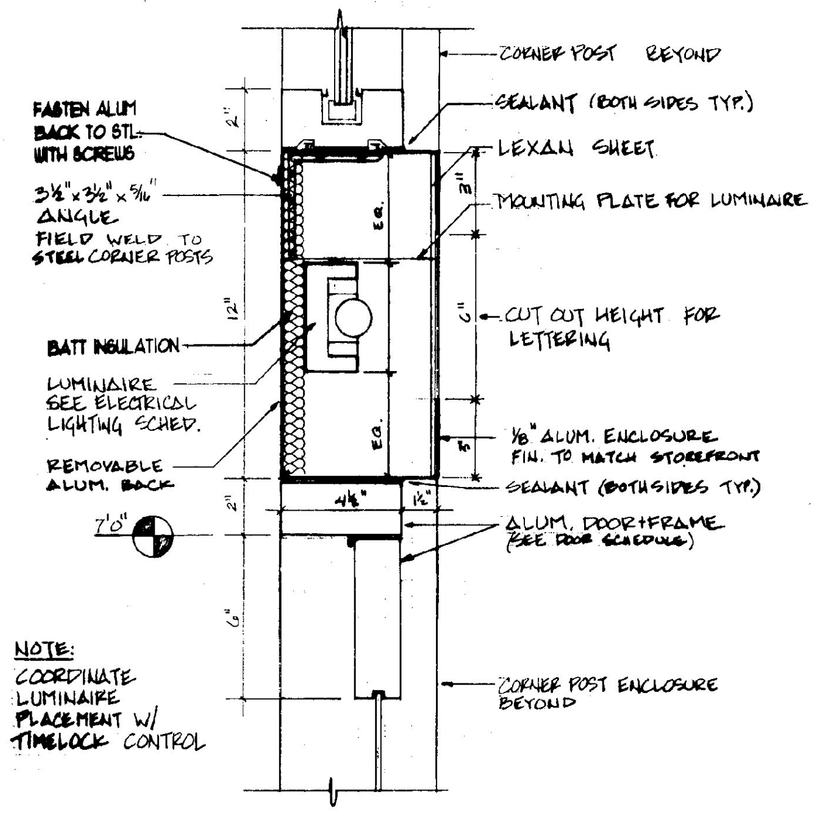

02 / 3.5 ENTRY - BACKLIT SIGN & DOOR HEAD
VESTIBULE 3"=1'-0"

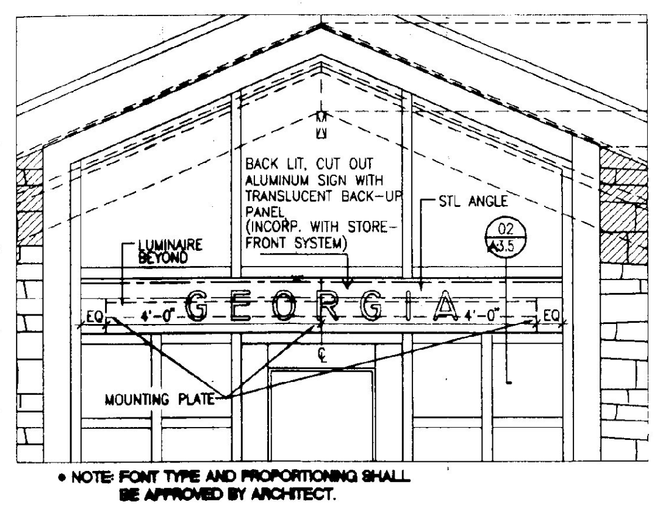

02A / 3.5 SIGN ELEVATION
1-1/2" = 1'

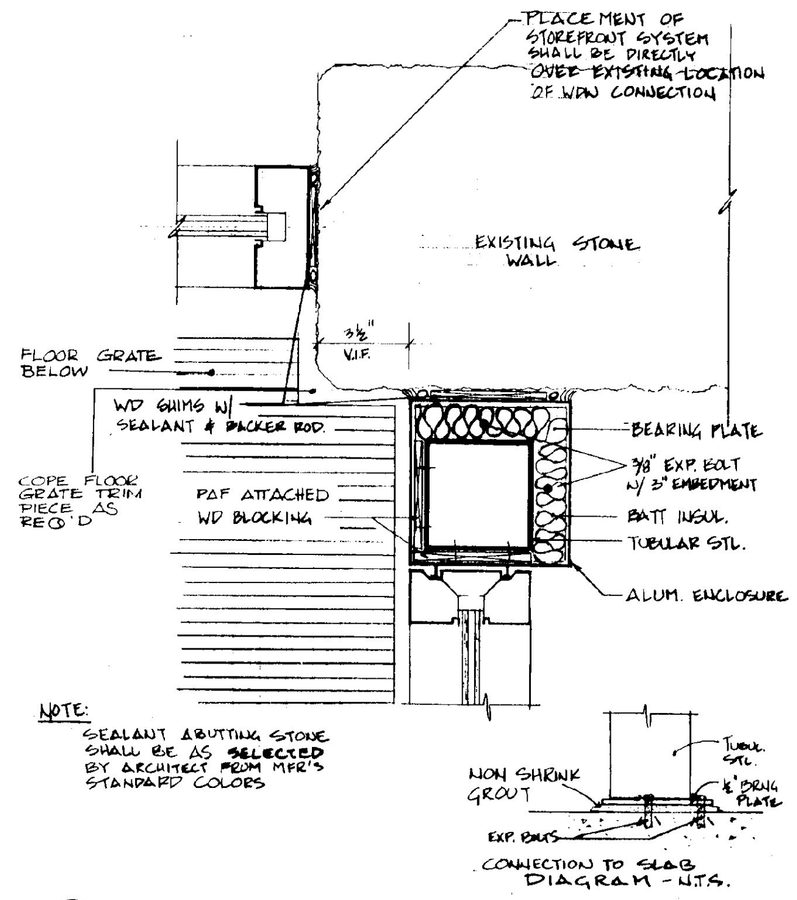

07 / 3.5 CONNECTION - STOREFRONT & EXISTING STONE WALL
VESTIBULE 3"=1'-0"

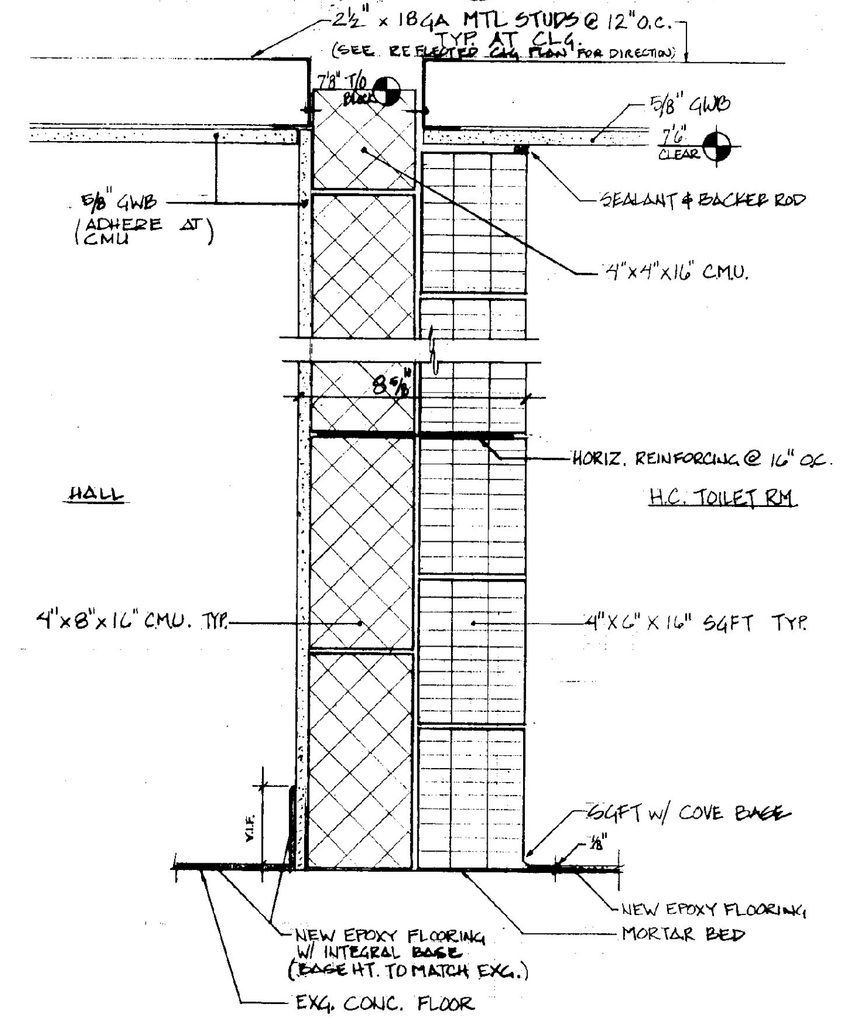

10 / 3.5 SECTION THROUGH WALL
UNISEX TLT 3"=1'-0"

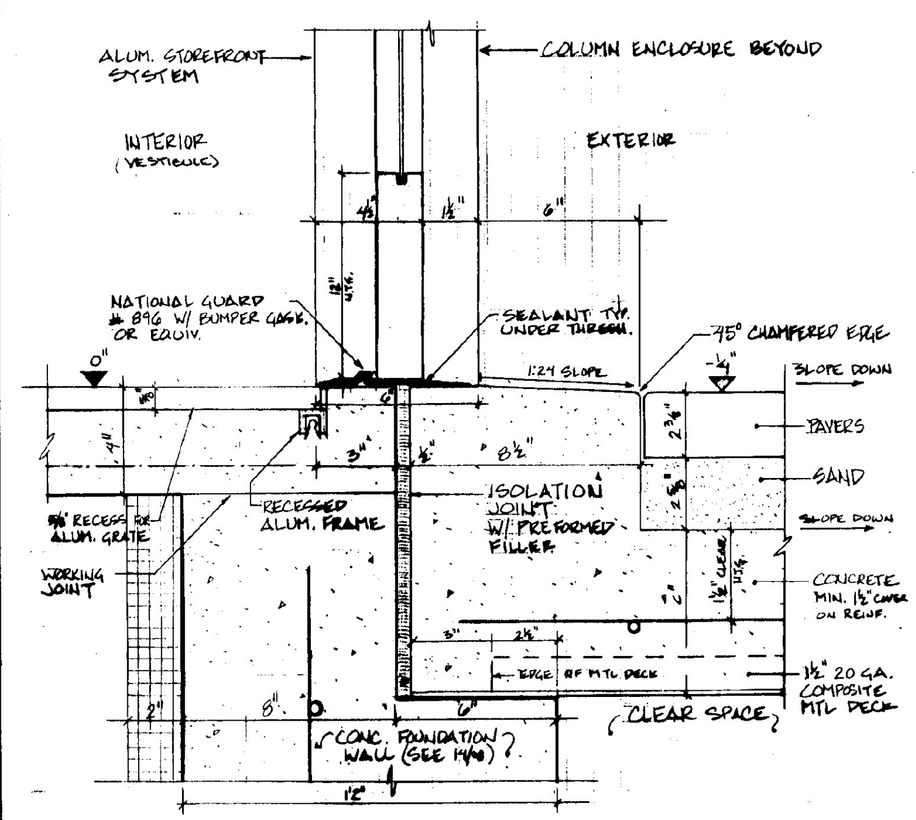

03 / 3.5 ENTRY - THRESHOLD SECTION
VESTIBULE DOOR #201 3"=1'-0"

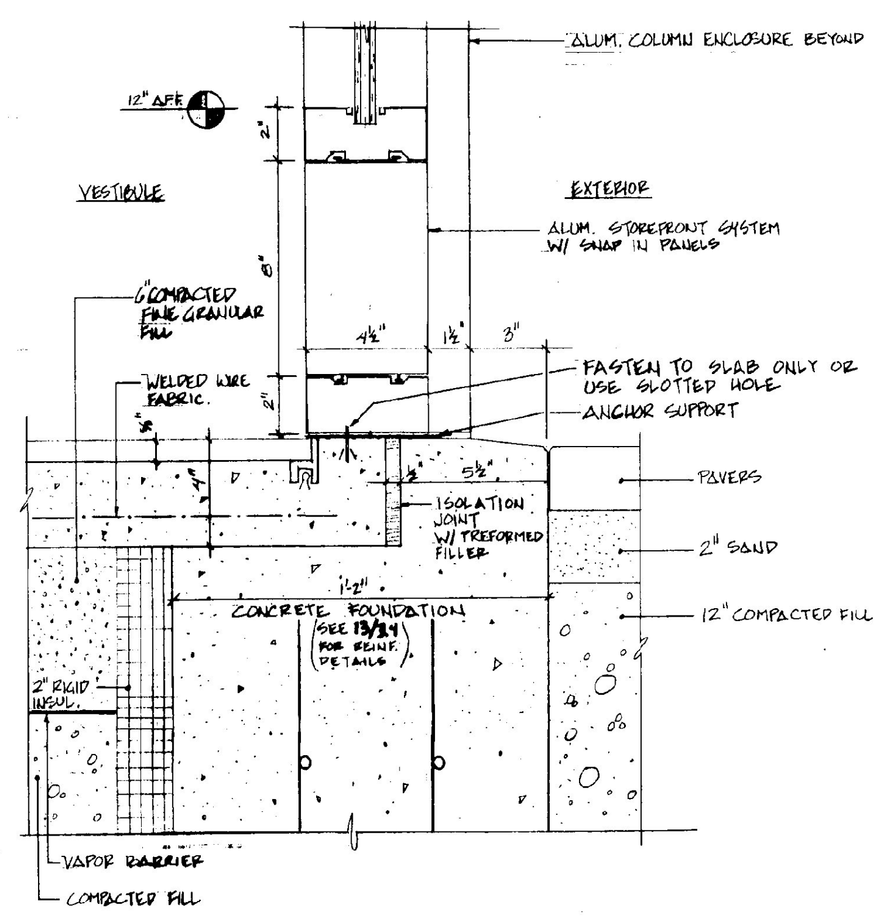

04 / 3.5 EXTERIOR STOREFRONT SILL
VESTIBULE 3"=1'-0"

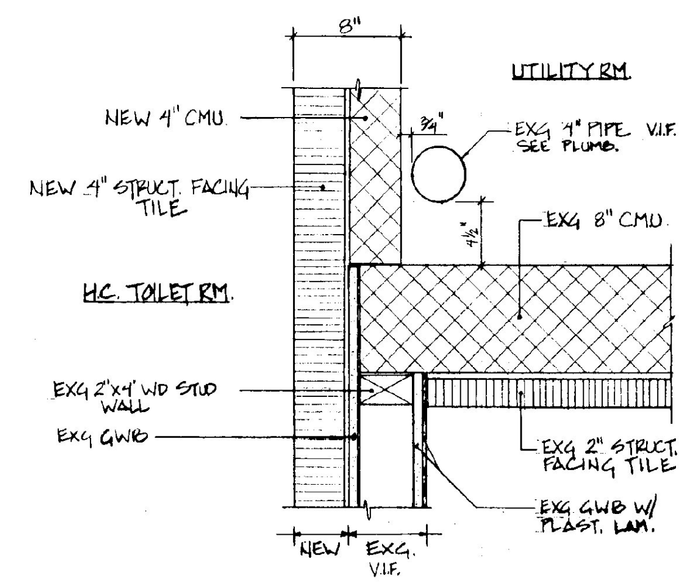

08 / 3.5 CONNECTION - WOMENS RESTRM / UTIL. RM / UNISEX RESTRM
1 1/2"=1'-0"

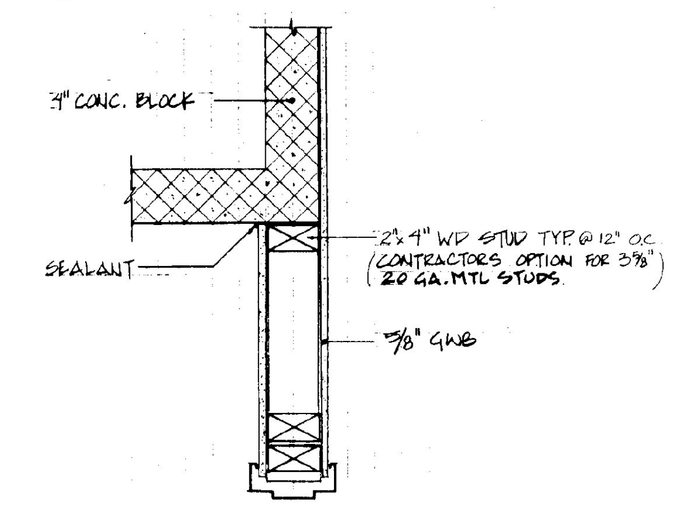

09 / 3.5 CONNECTION - CMU/WD STUD WALL
CLOSET RM #08 1 1/2"=1'-0"

STATE OF VERMONT
DEPARTMENT OF BUILDINGS AND GENERAL SERVICES
AGENCY OF ADMINISTRATION
MONTPELIER, VERMONT

GEORGIA INTERSTATE 89 REST AREAS
NORTHBOUND AND SOUTHBOUND


DATE: AUGUST 21, 1998	SCALE: AS NOTED	REVISIONS:	DRAWING NAME: MISCELLANEOUS DETAILS
DRAWN BY: MBB	PROJECT NO. IM 089-3 (30)		DRAWING NO.: A-3.5
CHECKED BY: JBA			

PROJECTS\ADA\GEORGIA-NS .5 Wed Jul 22 15:10:54 1998 Plotter By: Michael S. Siemaszko