AS BUILTS
DATE: 7/21/99

INTERIOR

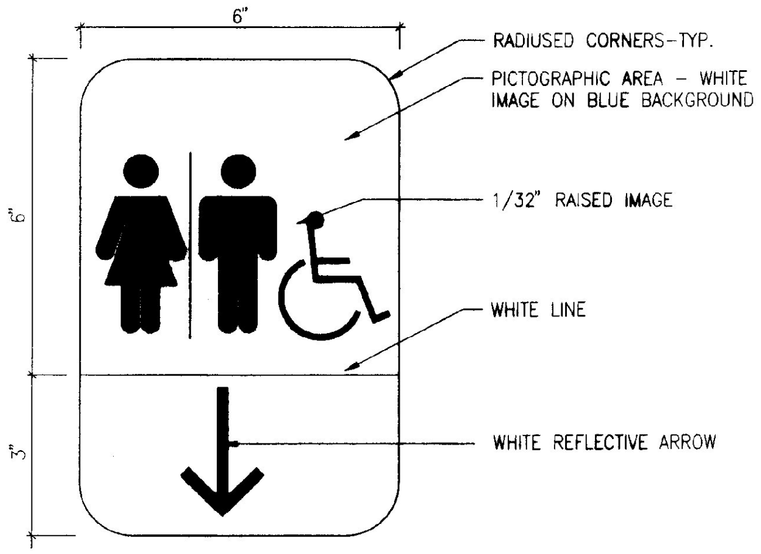

1 **SIGN TYPE #1**
SCALE: N.T.S.

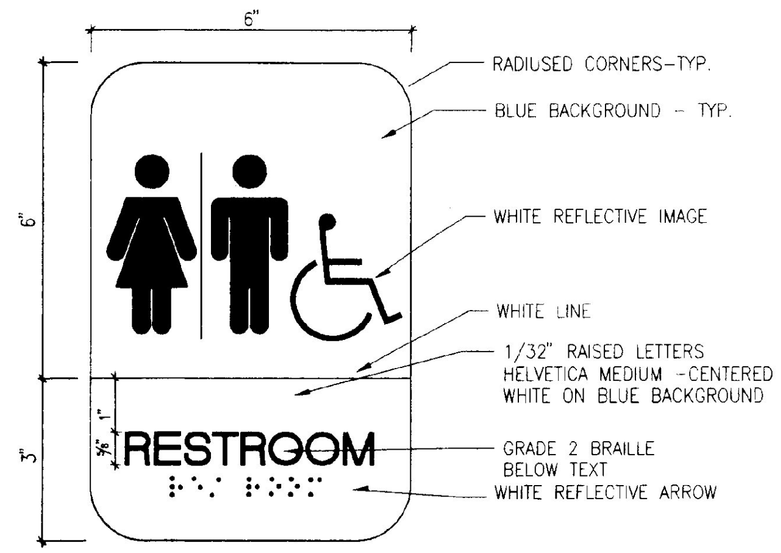

2 **SIGN TYPE #2**
SCALE: N.T.S.

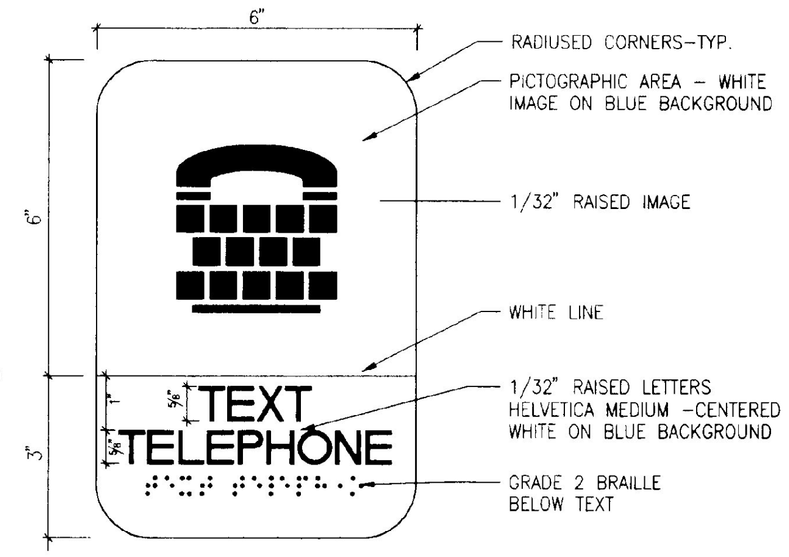

3 **SIGN TYPE #3**
SCALE: N.T.S.

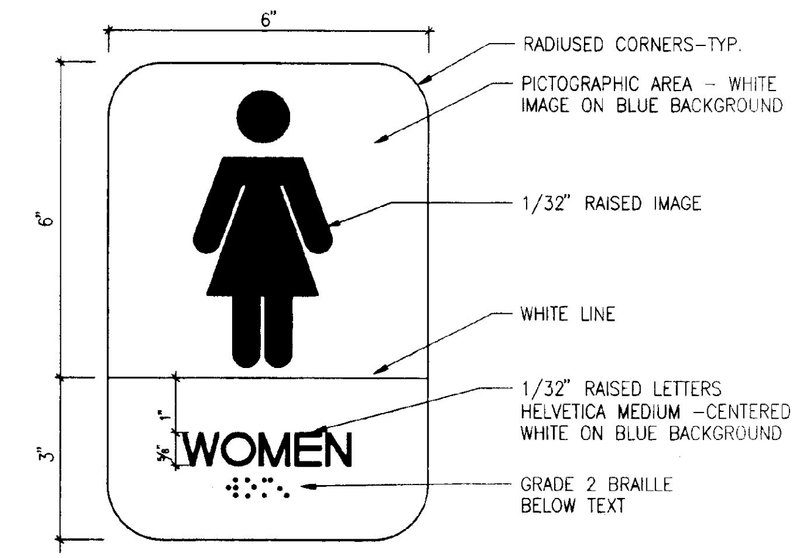

4 **SIGN TYPE #4**
SCALE: N.T.S.

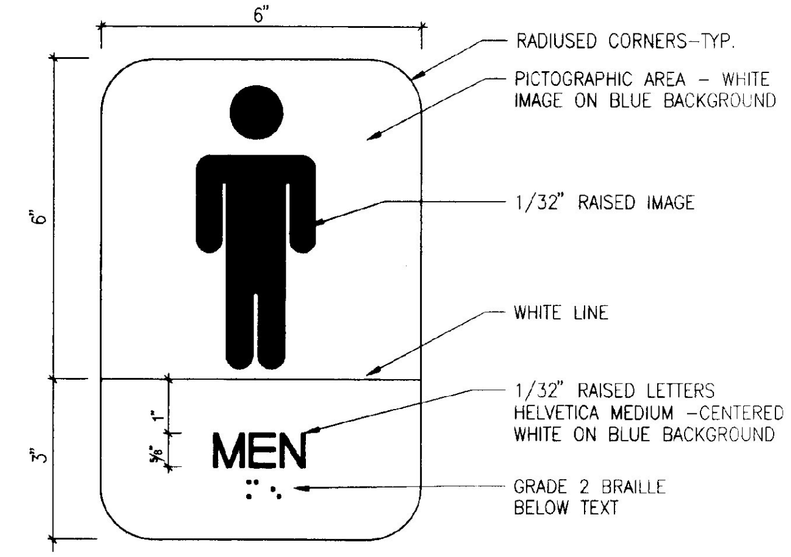

5 **SIGN TYPE #5**
SCALE: N.T.S.

STATE OF VERMONT
DEPARTMENT OF BUILDINGS AND GENERAL SERVICES
AGENCY OF ADMINISTRATION
MONTPELIER, VERMONT

GEORGIA INTERSTATE 89 REST AREAS
NORTHBOUND AND SOUTHBOUND

DATE:	SCALE:	REVISIONS:	DRAWING NAME:
JULY 27, 1998	1/8"=1'-0"		SIGNS
DRAWN BY: MBS	PROJECT NO. IM 089-3 (30)		DRAWING NO: A-3.6
CHECKED BY: JBA			