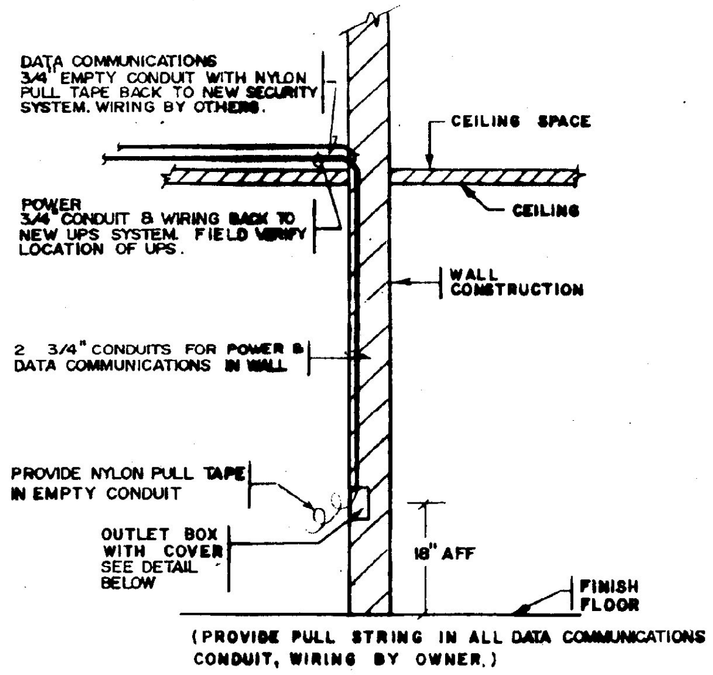

COMPUTER TERMINAL OUTLET DETAIL

NOT TO SCALE

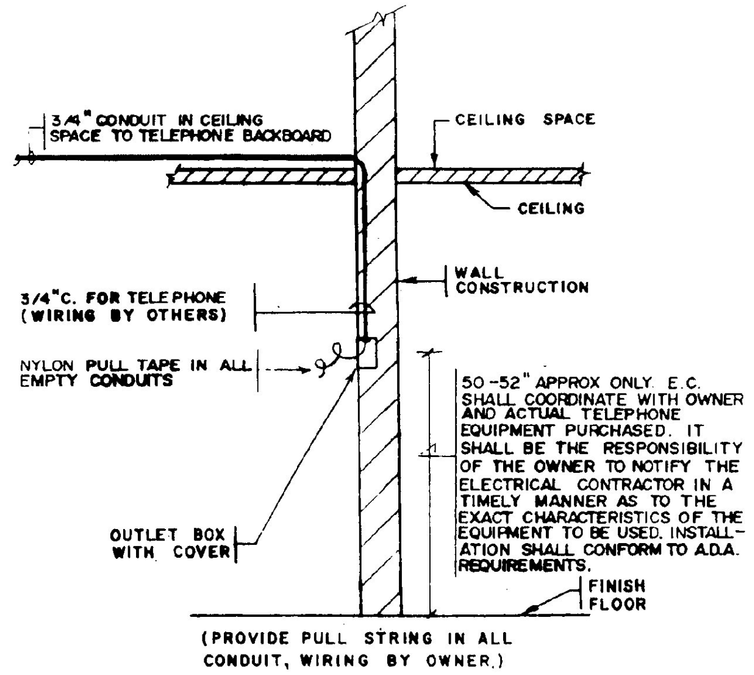

TELEPHONE OUTLET DETAIL

NOT TO SCALE

LIGHTING FIXTURE SCHEDULE

TYPE	MANUFACTURER & DESCRIPTION	LAMPS WATT.	LAMPS TYPE	MOUNTING	FINISH	REMARKS
A	LOBBY NEWSTAR VANDALPROOF NO. 54-142	2-32	F-32 T-8 RS	SURFACE	WHITE	PROVIDE TAMPERPROOF SCREWS
B	HANDICAPPED TOILET RM. NEWSTAR VANDALPROOF CORNER NO. 54-142/45	2-32	F-32 T-8 RS	SURFACE/ CORNER MT.	WHITE	PROVIDE TAMPERPROOF SCREWS
C	PORTICO/CANOPY FAILSAFE NO. HDR-100M-120-93-8-SSP CI-ADD SUFFIX QRS	1-100	100 MGO MED	RECESSED	COORDINATE WITH ARCH.	PROVIDE TAMPER PROOF SCREWS. FIXTURE CI TO BE QUARTZ RESTRIKE
D	POLE MOUNTED LIGHT LITHONIA HI-TEK NO. KASI-250M-R4-120-SP12 QRS, POLE-SSS-16-125-DM19	1-250	250 MH	POLE-16'	COORDINATE WITH ARCH.	PROVIDE QUARTZ RESTRIKE
E	EXIT SIGN FAILSAFE NO. EXF-1-RW-120-EBP	2-9	9W PL BIAX	SURFACE COORDINATE WITH ARCH.	WHITE WITH RED LETTERS	INTEGRAL EMERGENCY BATTERY PACK TAMPERPROOF SCREWS
F	CLOSET LIGHT FAILSAFE FBO-14-120	2-7	7W PL BIAX	WALL 6'-6" AFF	OPAL WHITE	
G	SIGNAGE LIGHTING DAYBRITE 4' STRIP T148HO-LT20	60	60W 800MA LOW TEMP	SEE ARCH. DETAILS	WHITE	PROVIDE LOW TEMP (-20°) SIGN TYPE LAMP AND BALLASTS
H	TRACK LIGHTING PROGRESS Nº P6254-10	75	75W PAR 16	CEILING SUSPENDED	WHITE	PROVIDE WHITE TRACKS (3)-4' TRACKS W/ 5 HEADS.
I	PASS & SEYMOUR LAMP HOLDER NO. 1AB17	60	60W I	WALL 7'-6" A.F.F.	—	MTD IN PLB'S CHASE WALL W/ LIGHT SWITCH INSTALL 48" A.F.F
J	POLE MOUNTED LIGHT G.E. STREET LIGHT TYPE M	250	250 MER.	POLE 25' FIELD VERIFY TO EXIST.	SAME AS EXISTING	

ELECTRICAL LEGEND

SYMBOLS USED ARE INDICATED BY A CHECK

✓	J	JUNCTION BOX
		SINGLE RECEPTACLE 18" A.F.F.
✓		DUPLEX RECEPTACLE 18" A.F.F.
		QUAD. RECEPTACLE 18" A.F.F.
		SPECIAL RECEPTACLE RATING ADJACENT
✓		POWER PANEL
	F	FIRE STATION
✓	▼	TELEPHONE OUTLET
	⊠	MOTOR STARTER
✓		DISCONNECT
	H	FIRE HORN & LIGHT
✓	T	TRANSFORMER
✓	P	HOME RUN TO PANEL P (MIN. 3/4" CONDUIT)
✓		CONDUIT TURNING UP
✓		CONDUIT TURNER UP
✓		EXIT LIGHT
✓		FLOURESCENT LIGHT
✓		TO BE REMOVED
✓	P	POINT OF N ELEC. CONNECTION TO E
✓	N	NEW
✓	E	EXISTING
✓	S	SINGLE POLE SWITCH 48" A.F.F.
✓	S_3	THREE-WAY SWITCH 48" A.F.F.
✓	A.F.F.	ABOVE FINISHED FLOOR
✓	A.F.C.	ABOVE FINISHED COUNTER
✓		INCANDESCENT CEILING LIGHT
✓		NIGHT LIGHT
		DUPLEX RECEPTACLE IN FLOOR
	C	CLOCK OUTLET 7'-0" AFF
✓	— SM —	MOTOR THERMAL SWITCH
	A.H.U.	AIRHANDLING UNIT
✓		GFI TYPE DUPLEX RECEPTACLE
✓	▼P	PAY TELEPHONE OUTLET
✓	▼P TTY	PAY TELEPHONE OUTLET, HANDICAP ACCESSIBLE
✓		EMERGENCY LIGHT FIXTURE
✓		REMOTE EMERGENCY LIGHT HEAD
✓	E	ELECTRIC DOOR STRIKE LOCATION
✓		CCTV CAMERA LOCATION
✓		COMPUTER TERMINAL OUTLET DETAIL

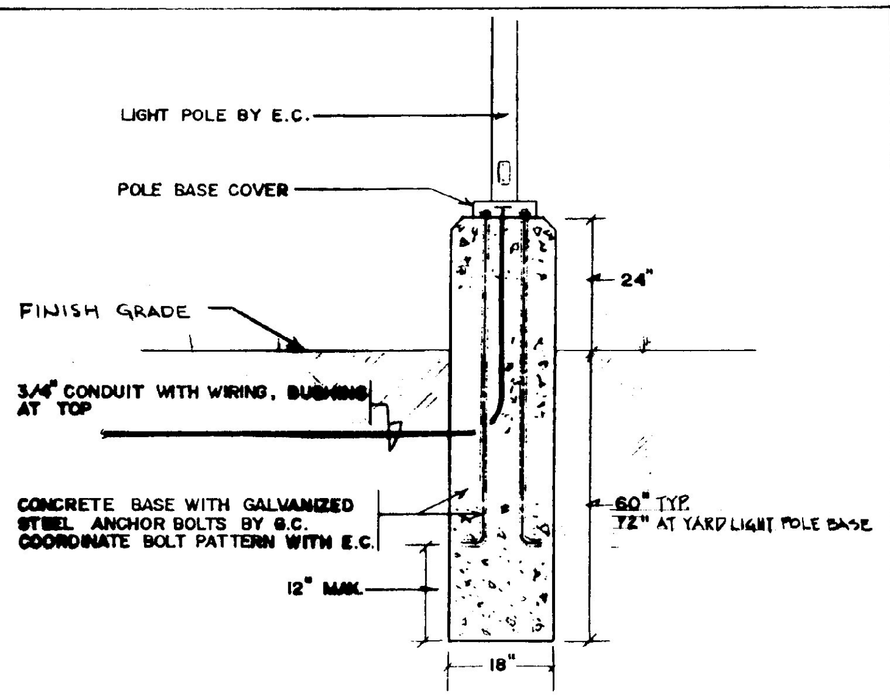

LIGHT POLE BASE DETAIL

NOT TO SCALE

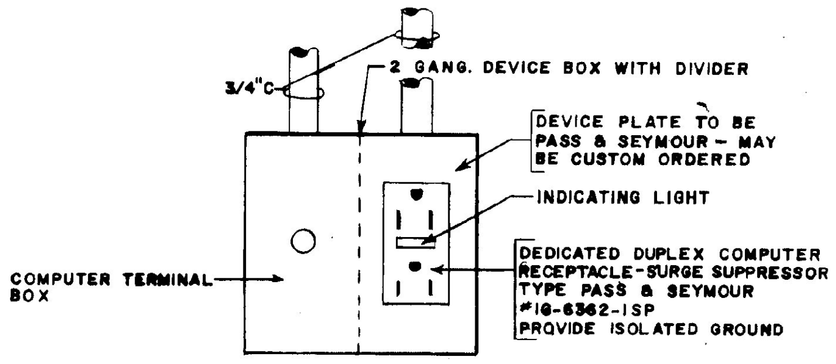

THIS SYMBOL WHERE SHOWN ON THE DRAWINGS, INCLUDES ALL ITEMS INDICATED ON THIS DETAIL. A DUPLEX RECEPTACLE SYMBOL SHOWN ADJACENT TO THE COMPUTER TERMINAL/RECEPTACLE SYMBOL (ABOVE) INDICATES AN ADDITIONAL, SEPARATE DUPLEX OUTLET

COMPUTER TERMINAL/RECEPTACLE DETAIL

NOT TO SCALE

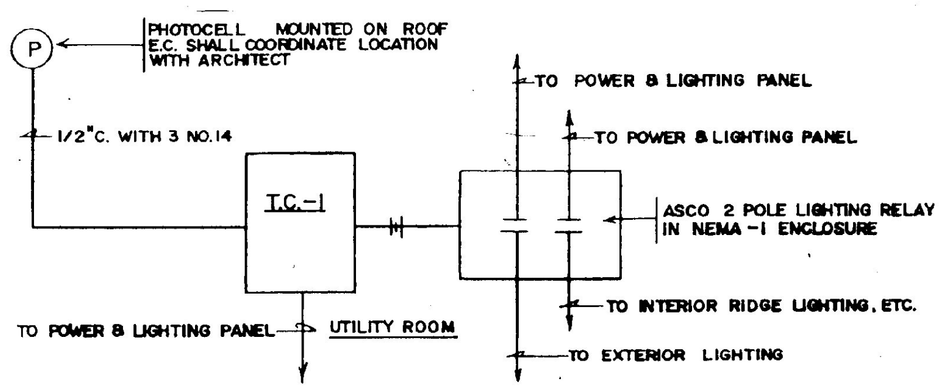

TIMECLOCK T.C.-1 DETAIL — INTERIOR & EXTERIOR LIGHTING

NOT TO SCALE

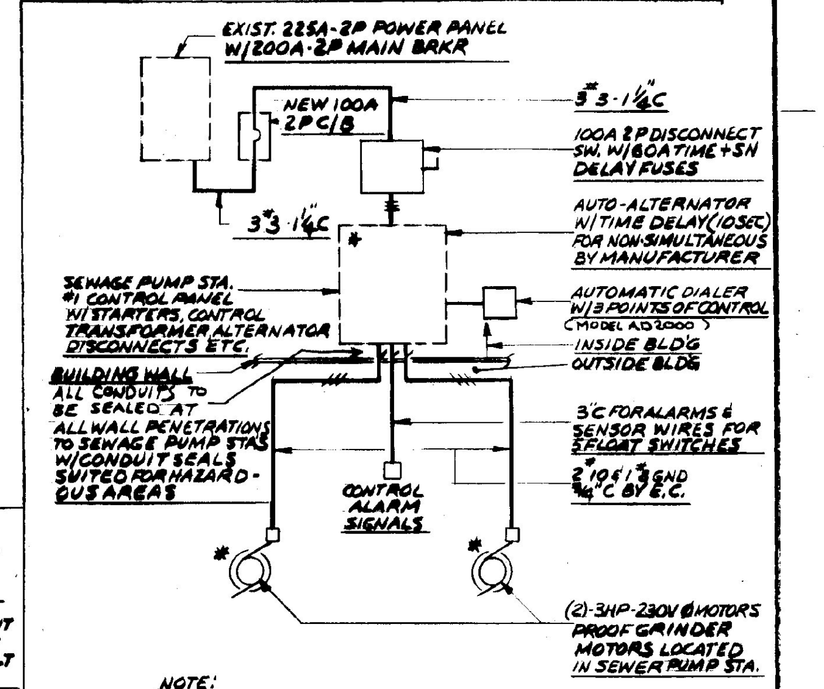

NOTE: SYMBOL # NEXT TO ITEMS INDICATES ARE FURNISHED BY OTHERS.

"GEORGIA NORTHBOUND"

WIRING DIAGRAM
SEWERAGE PUMPING STATION #1

NTS

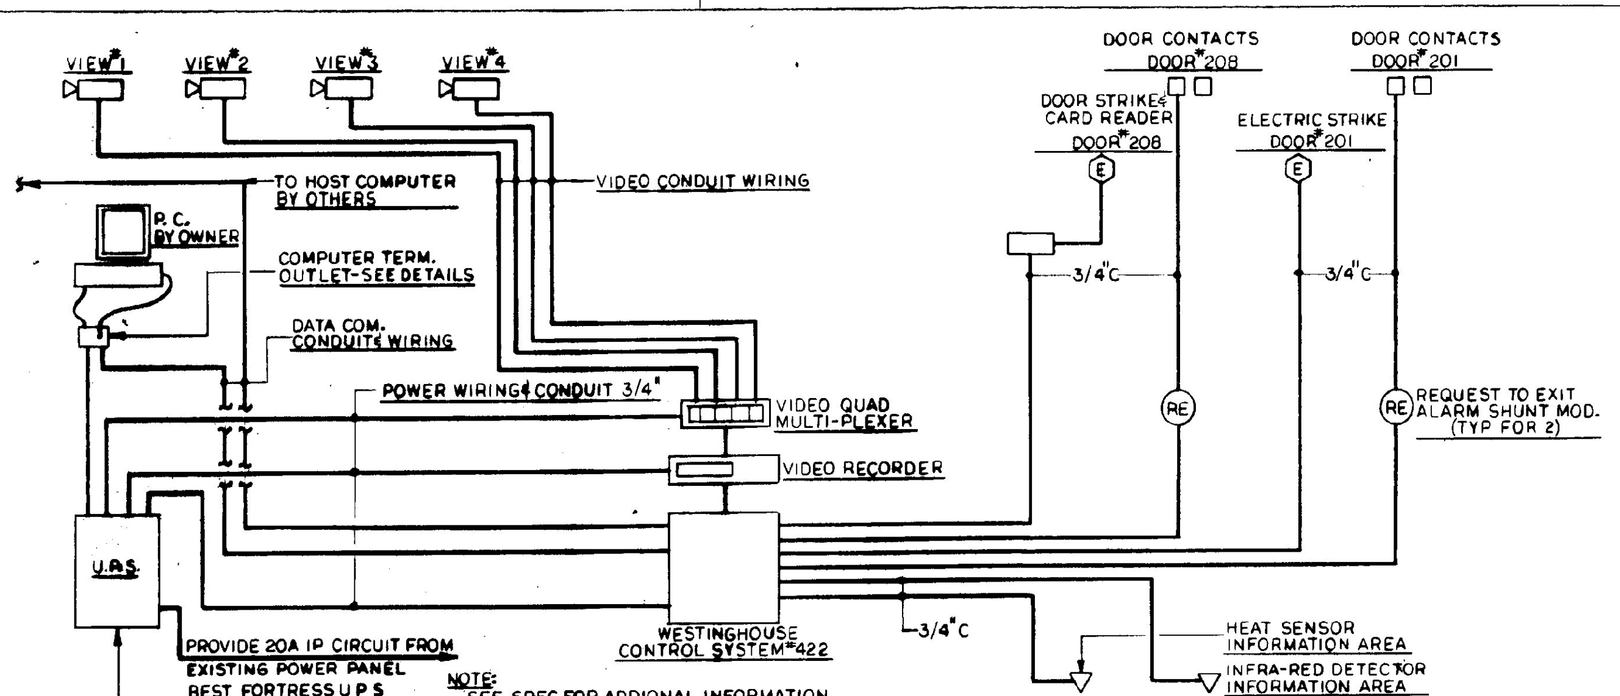

PROXIMITY ACCESS CONTROL SYSTEM-ONE LINE DIAGRAM

NTS

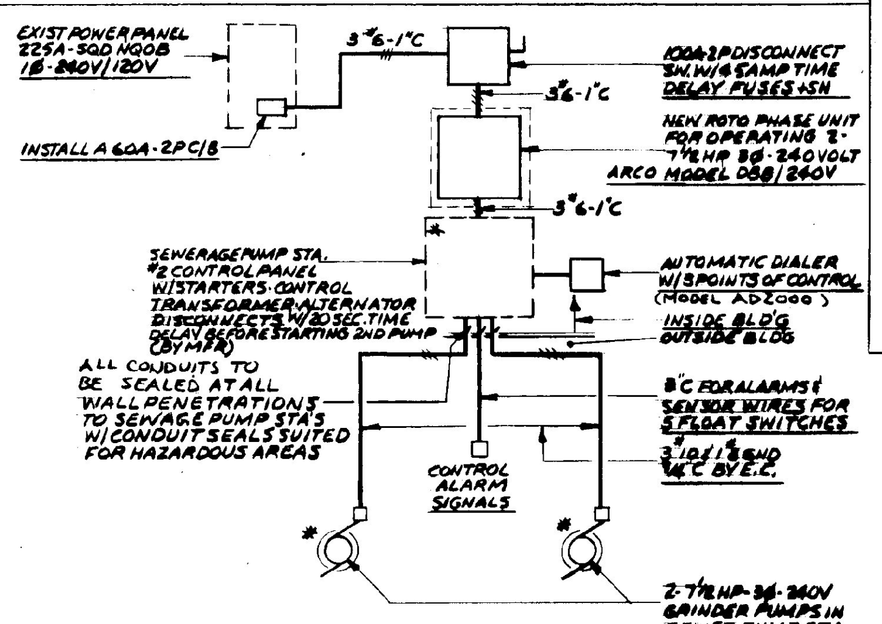

NOTE: SYMBOL # NEXT TO ITEMS INDICATES ARE FURNISHED BY OTHERS.

"GEORGIA SOUTHBOUND"

WIRING DIAGRAM
SEWERAGE PUMPING STATION #2

NTS

STATE OF VERMONT
DEPARTMENT OF STATE BUILDINGS
AGENCY OF ADMINISTRATION
MONTPELIER, VERMONT

REST AREA REHABILITATION
GEORGIA I-89
NORTH & SOUTHBOUND
RECORD DRAWING

DATE: 8-21-98	SCALE: 1/4"=1'-0"	REVISIONS:	DRAWING NO: E-3.0
DRAWN BY: DG	APPROVED BY: NFL 779 A/C	DRAWING NAME: ELECTRICAL LEGEND, DET.	SHEET ___ OF ___

STATE OF VERMONT — NEALE F. LAWRENCE — No. 3448 — REGISTERED PROFESSIONAL ENGINEER