AS BUILTS
DATE: 7/21/99

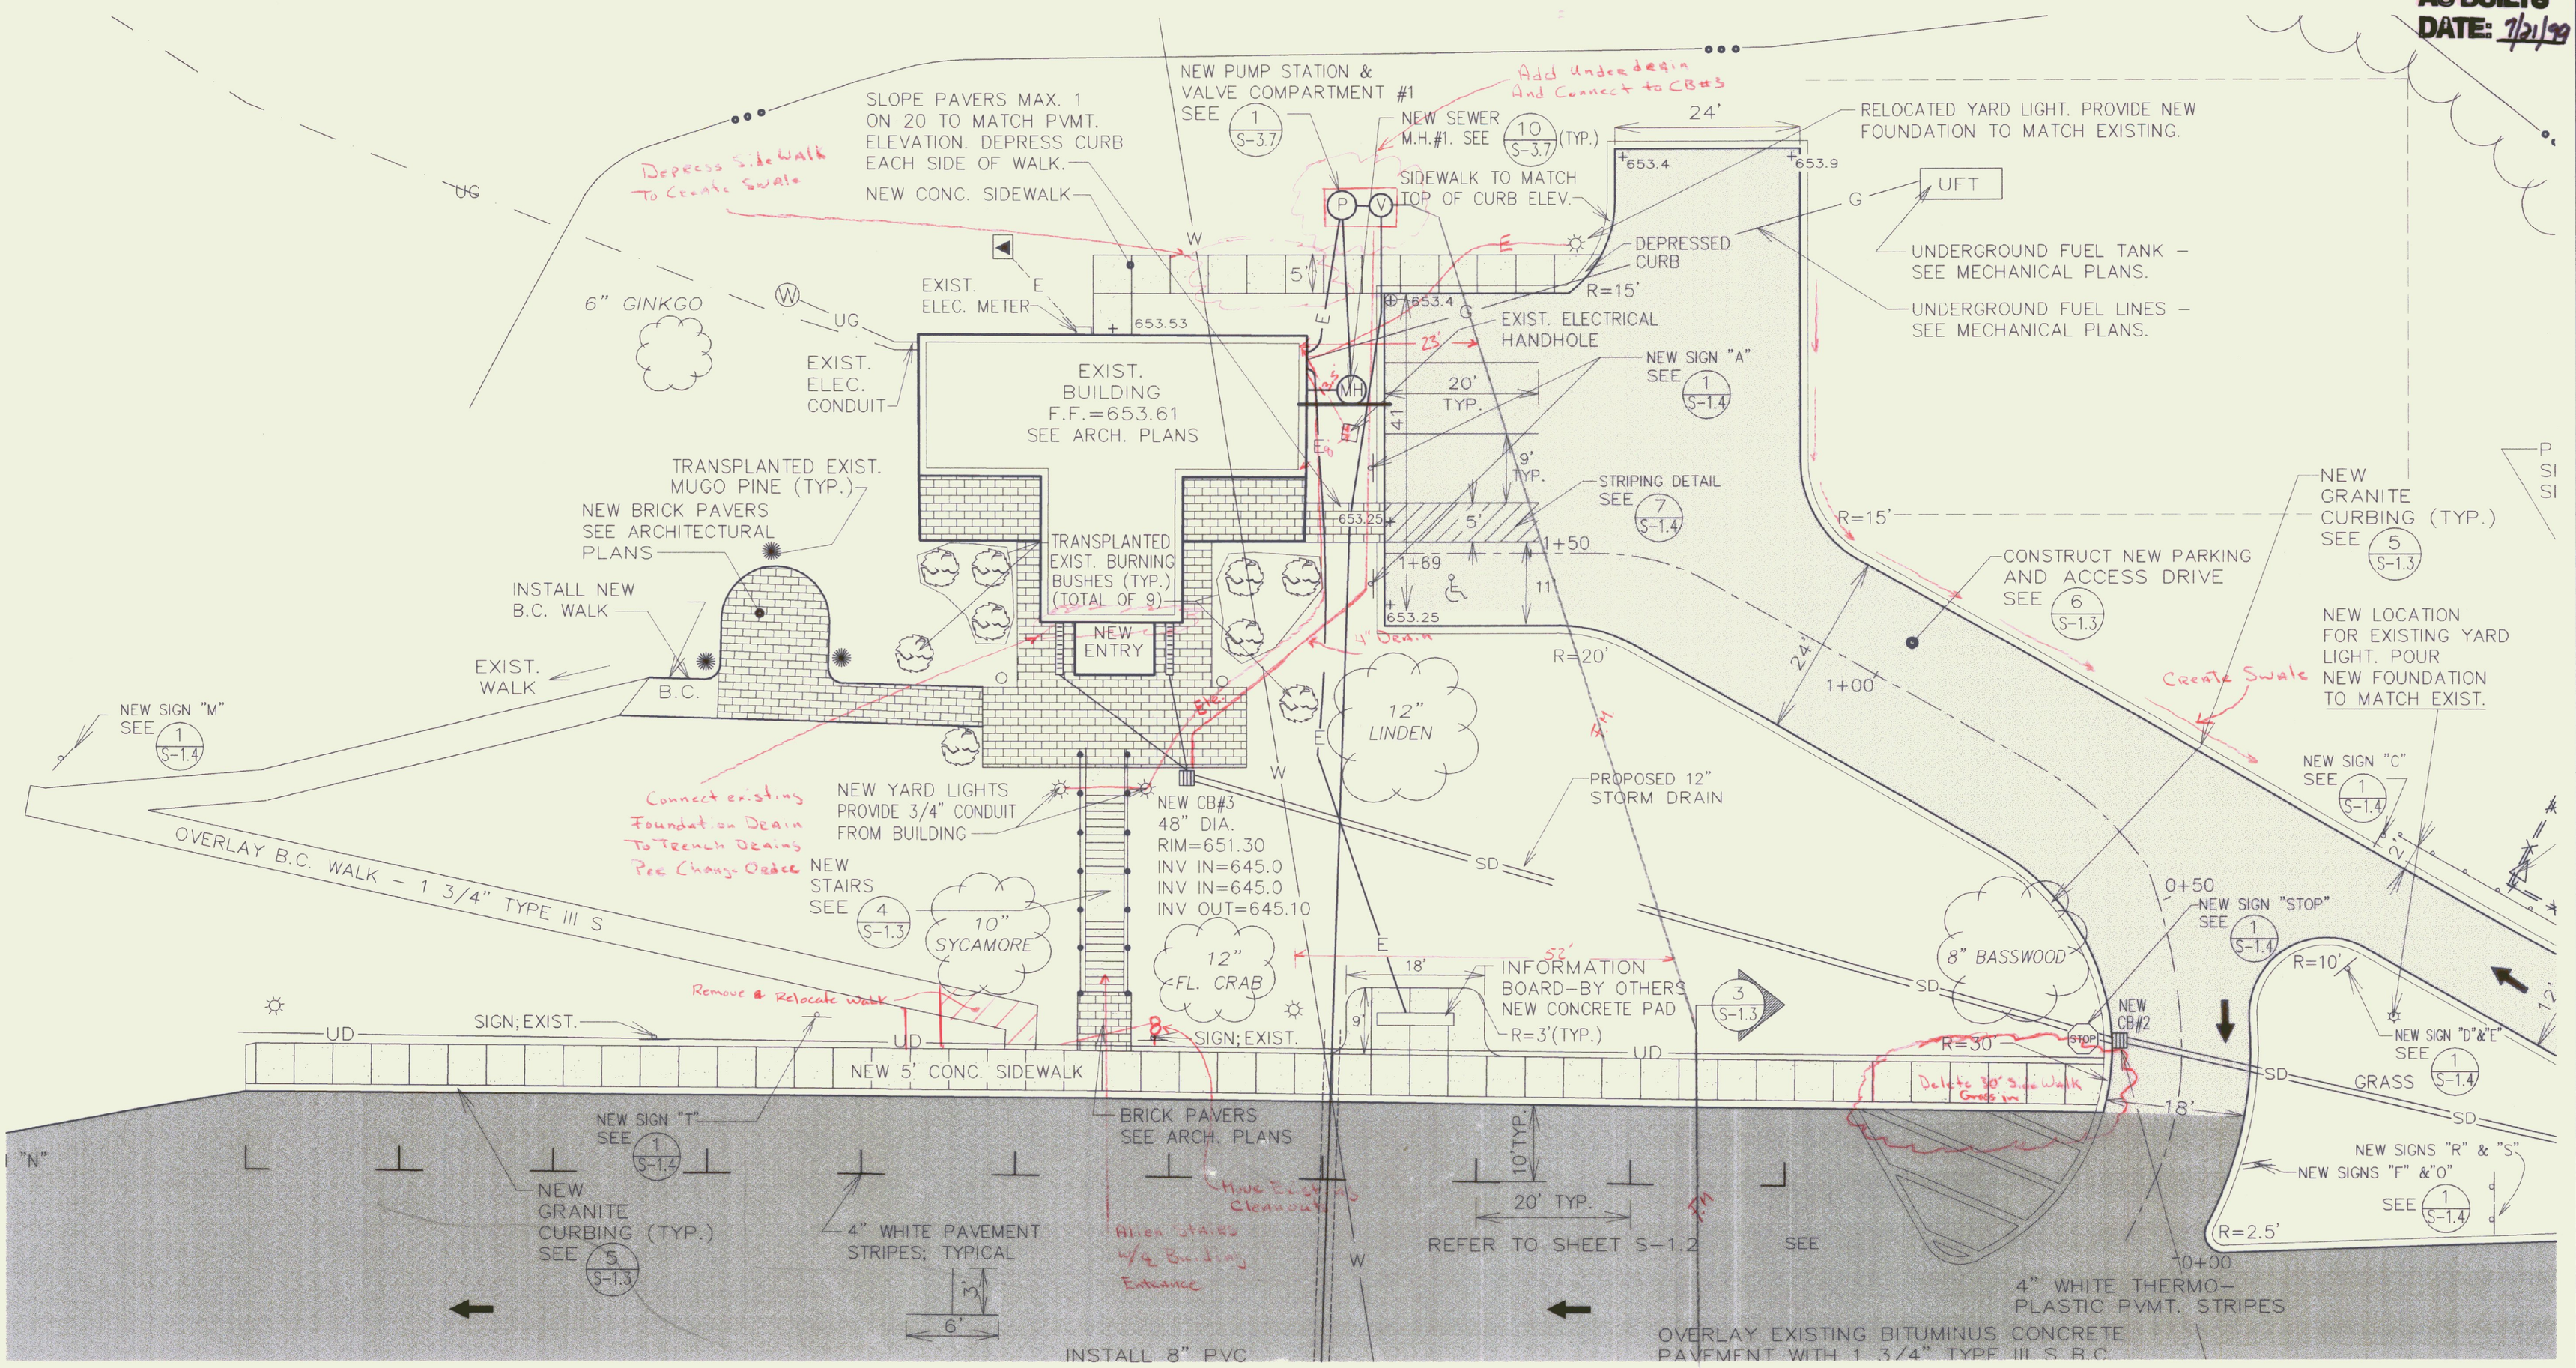

Relocate Force Main
Sleeve Across RT 89
Changed By Others

STATE OF VERMONT
DEPARTMENT OF BUILDINGS AND GENERAL SERVICES
AGENCY OF ADMINISTRATION
MONTPELIER, VERMONT

GEORGIA INTERSTATE 89 REST AREAS
NORTHBOUND AND SOUTHBOUND

DATE:	SCALE:	REVISIONS:	DRAWING NAME:
AUG. 21, 1998	1"=10'	8/12/98: Miscellaneous	NORTHBOUND LANDSCAPING PLAN
DRAWN BY: WHP/kac	PROJECT NO. 97041		DRAWING NO: S-1.2
CHECKED BY: SHR/PHC			

SHEET ____ OF ____
DATE PLOTTED: 8/21/98