AS BUILTS
DATE: 7/21/99

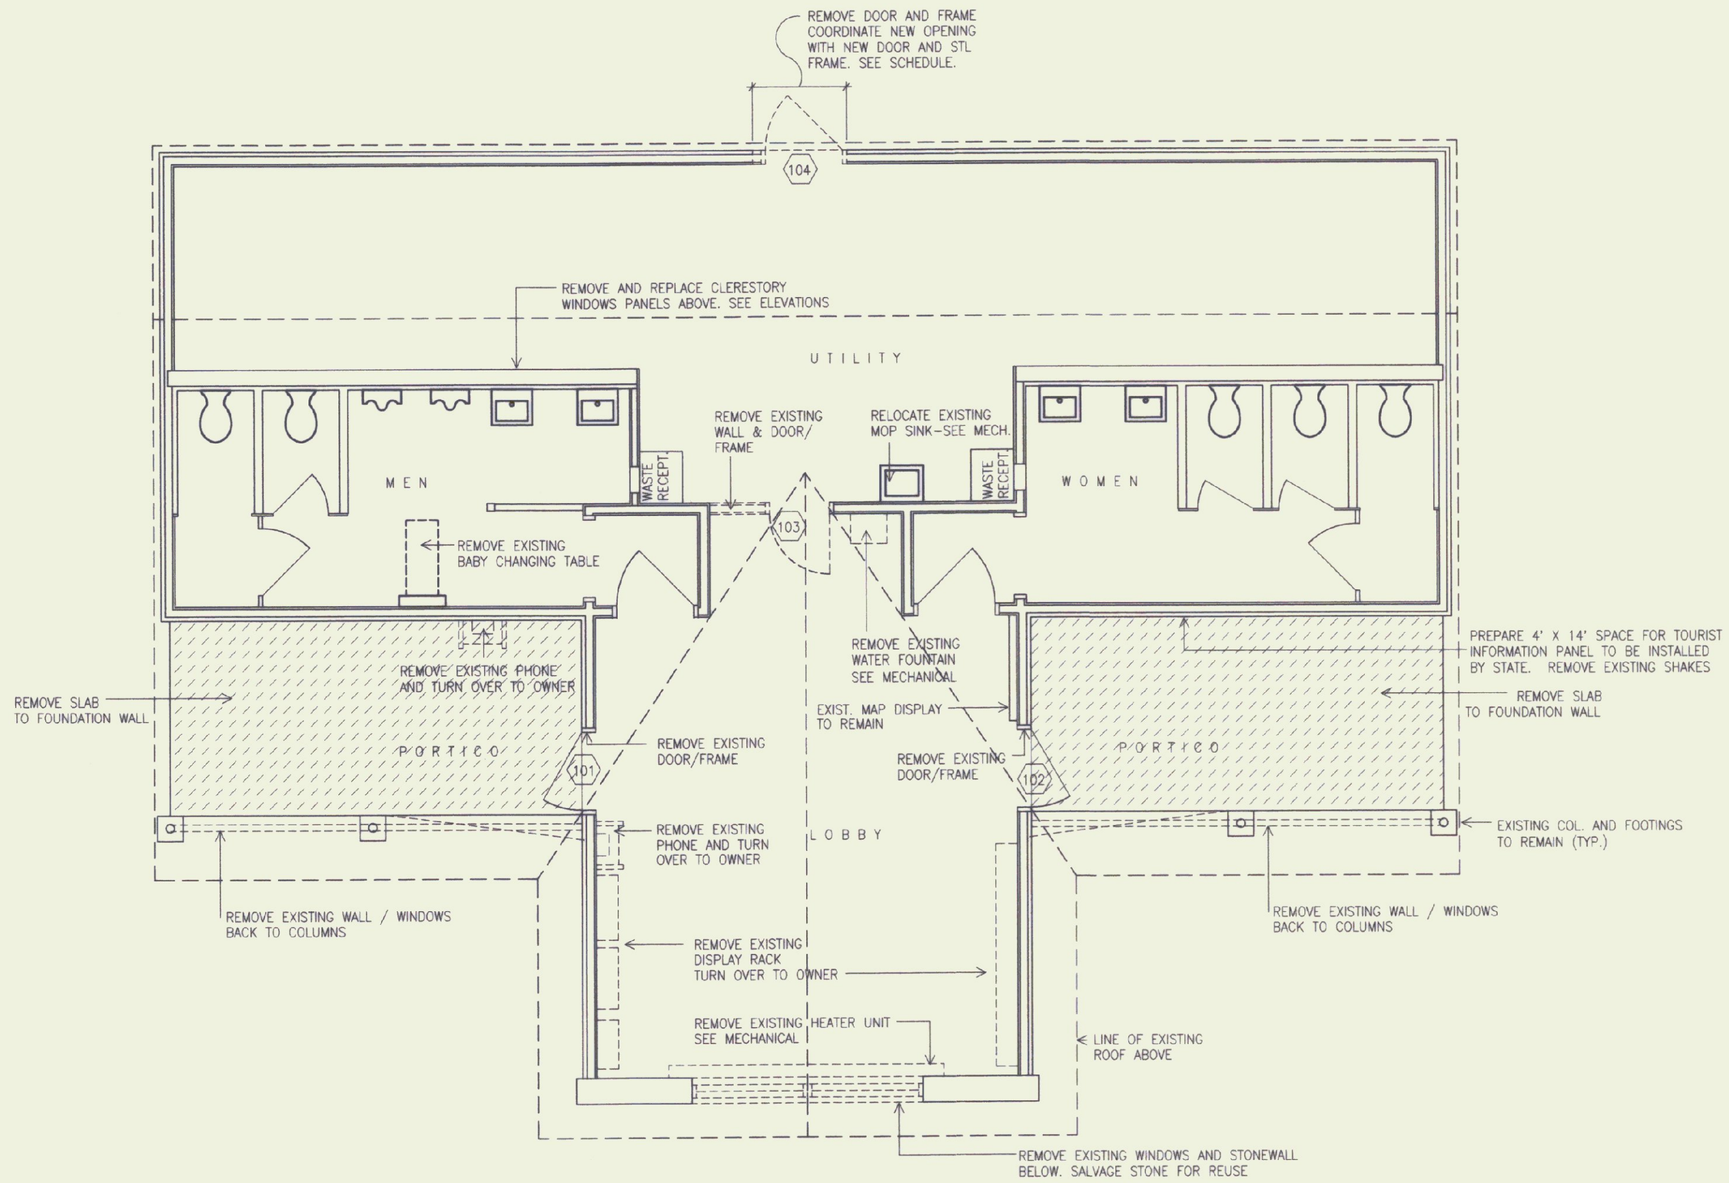

1 EXISTING FLOOR PLAN

SCALE: 1/4" = 1'

N O T E S:

- REMOVE ANY EXISTING HANDICAPPED SIGNAGE AT RESTROOMS AND SIGNAGE THAT DOES NOT COMPLY
- SEE MECH / ELEC FOR ADDITIONAL REMOVALS
- SEE ELEVATIONS FOR ADDITIONAL REMOVALS

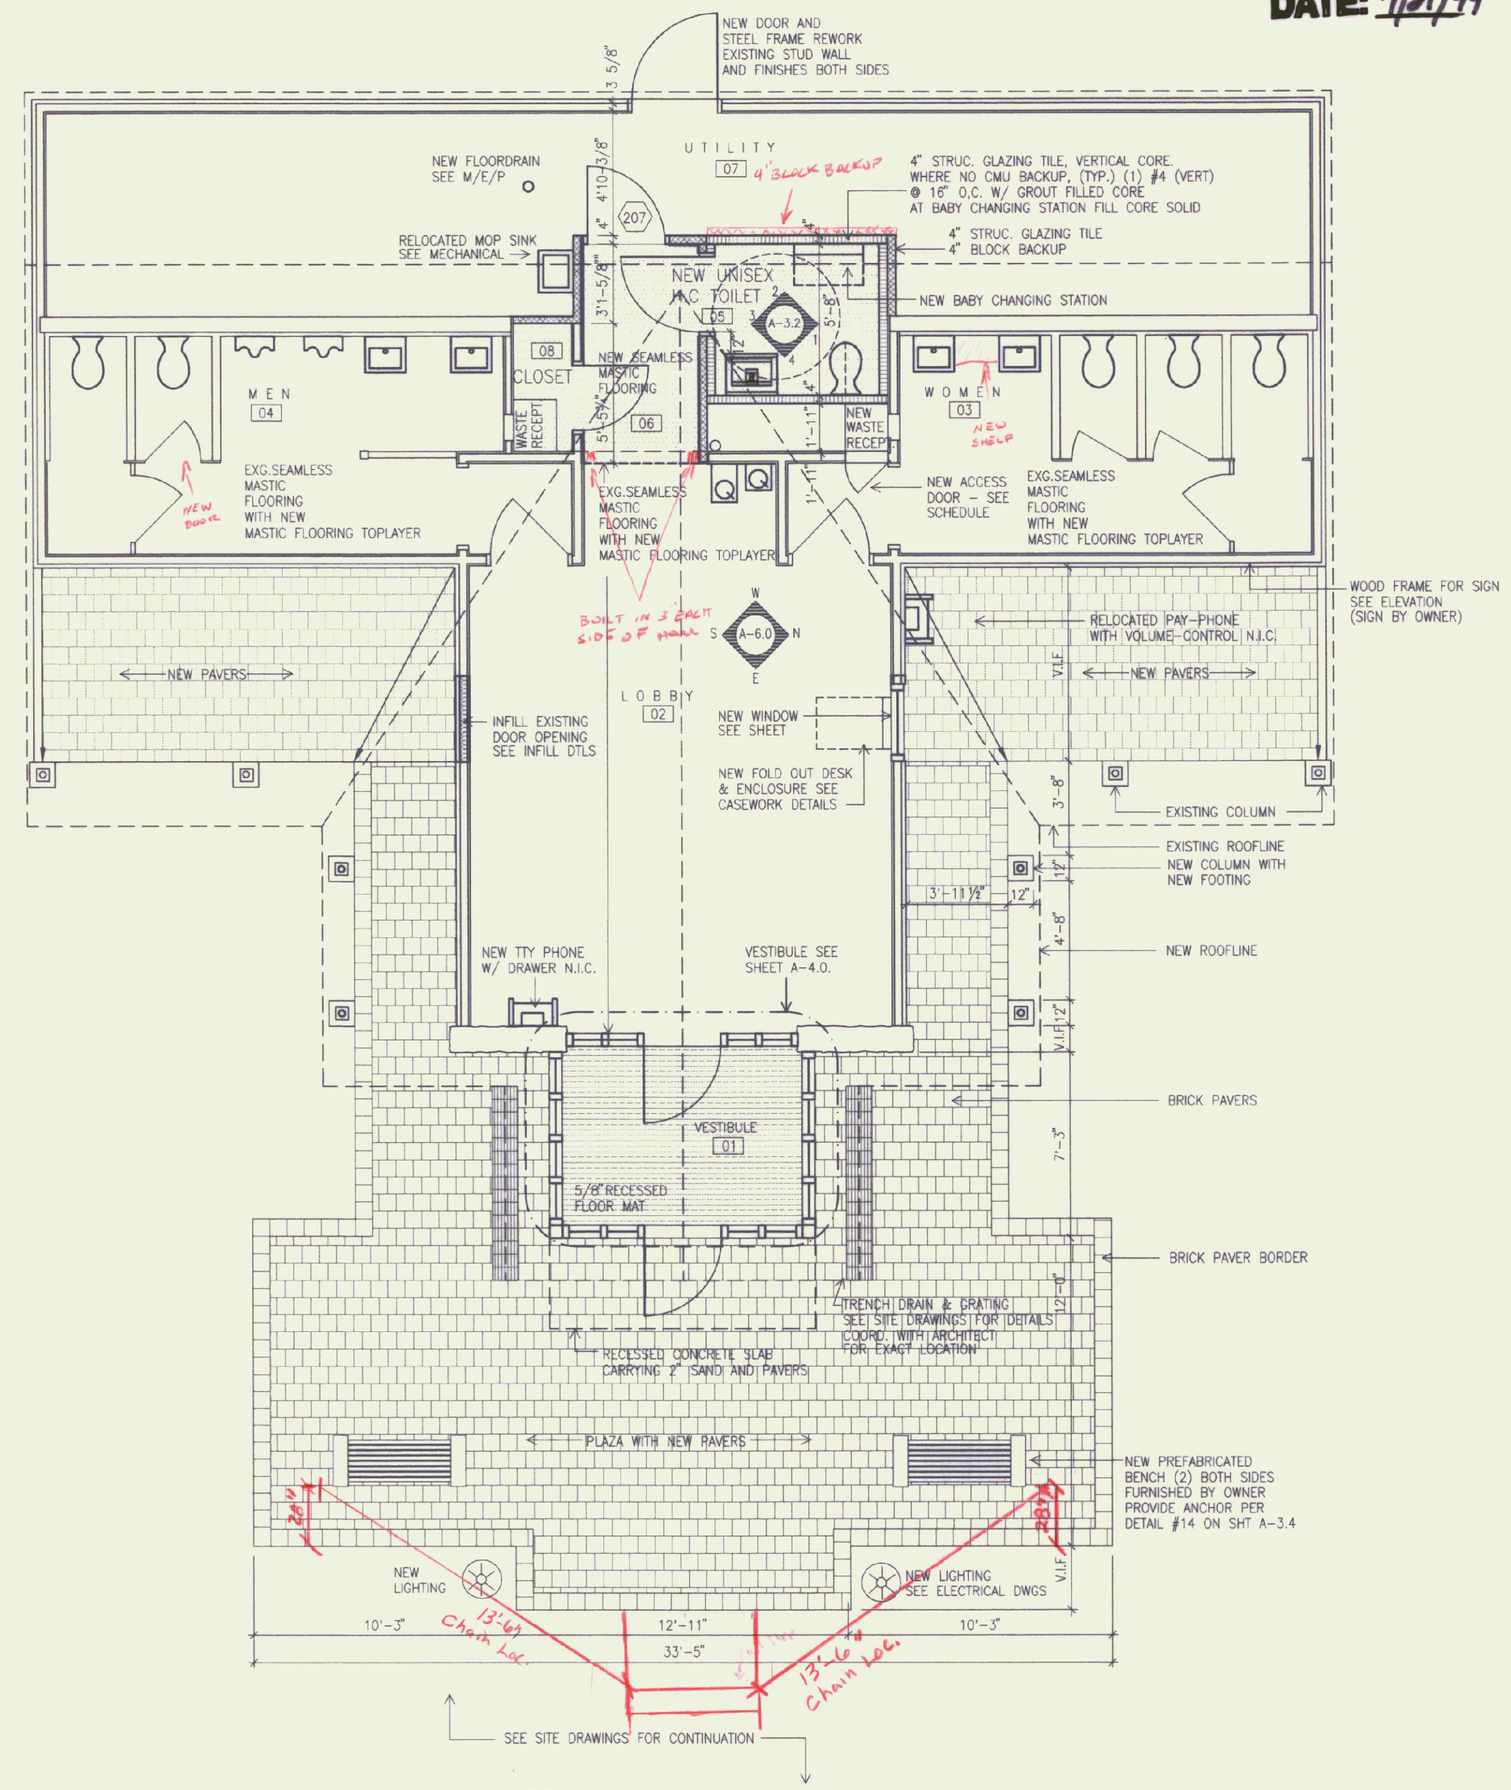

N O T E S:

- INSTALL NEW HANDICAPPED SIGNAGE WHERE REQUIRED
- INSTALL NEW SIGNAGE FOR BABY CHANGING STATION.

2 NEW FLOOR PLAN

SCALE: 1/4" = 1'

L E G E N D

CONCRETE
CMU
STRUCTURAL GLAZED TILE
PRECAST CONCRETE BRICK PAVERS
ASPHALT
NEW MASTIC FLOORING
SIGNAGE
EXISTING DOOR
NEW DOOR
DEMOLITION


STATE OF VERMONT
DEPARTMENT OF BUILDINGS AND GENERAL SERVICES
AGENCY OF ADMINISTRATION
MONTPELIER, VERMONT

GEORGIA INTERSTATE 89 REST AREAS NORTHBOUND

DATE:	SCALE:	REVISIONS:	DRAWING NAME:
AUGUST 21, 1998	1/4"=1'-0"		BUILDING PLAN
DRAWN BY: MSS	PROJECT NO. IM 089-3 (30)		DRAWING NO: A-1.0
CHECKED BY: JBA			

SHEET _____ OF _____

G:\PROJECTS\VAOA\GEORG-NS\A10 Mon Aug 24 09:20:17 1998 Plotter By: Michael S. Simanskas