AS BUILTS
DATE: 7/21/99

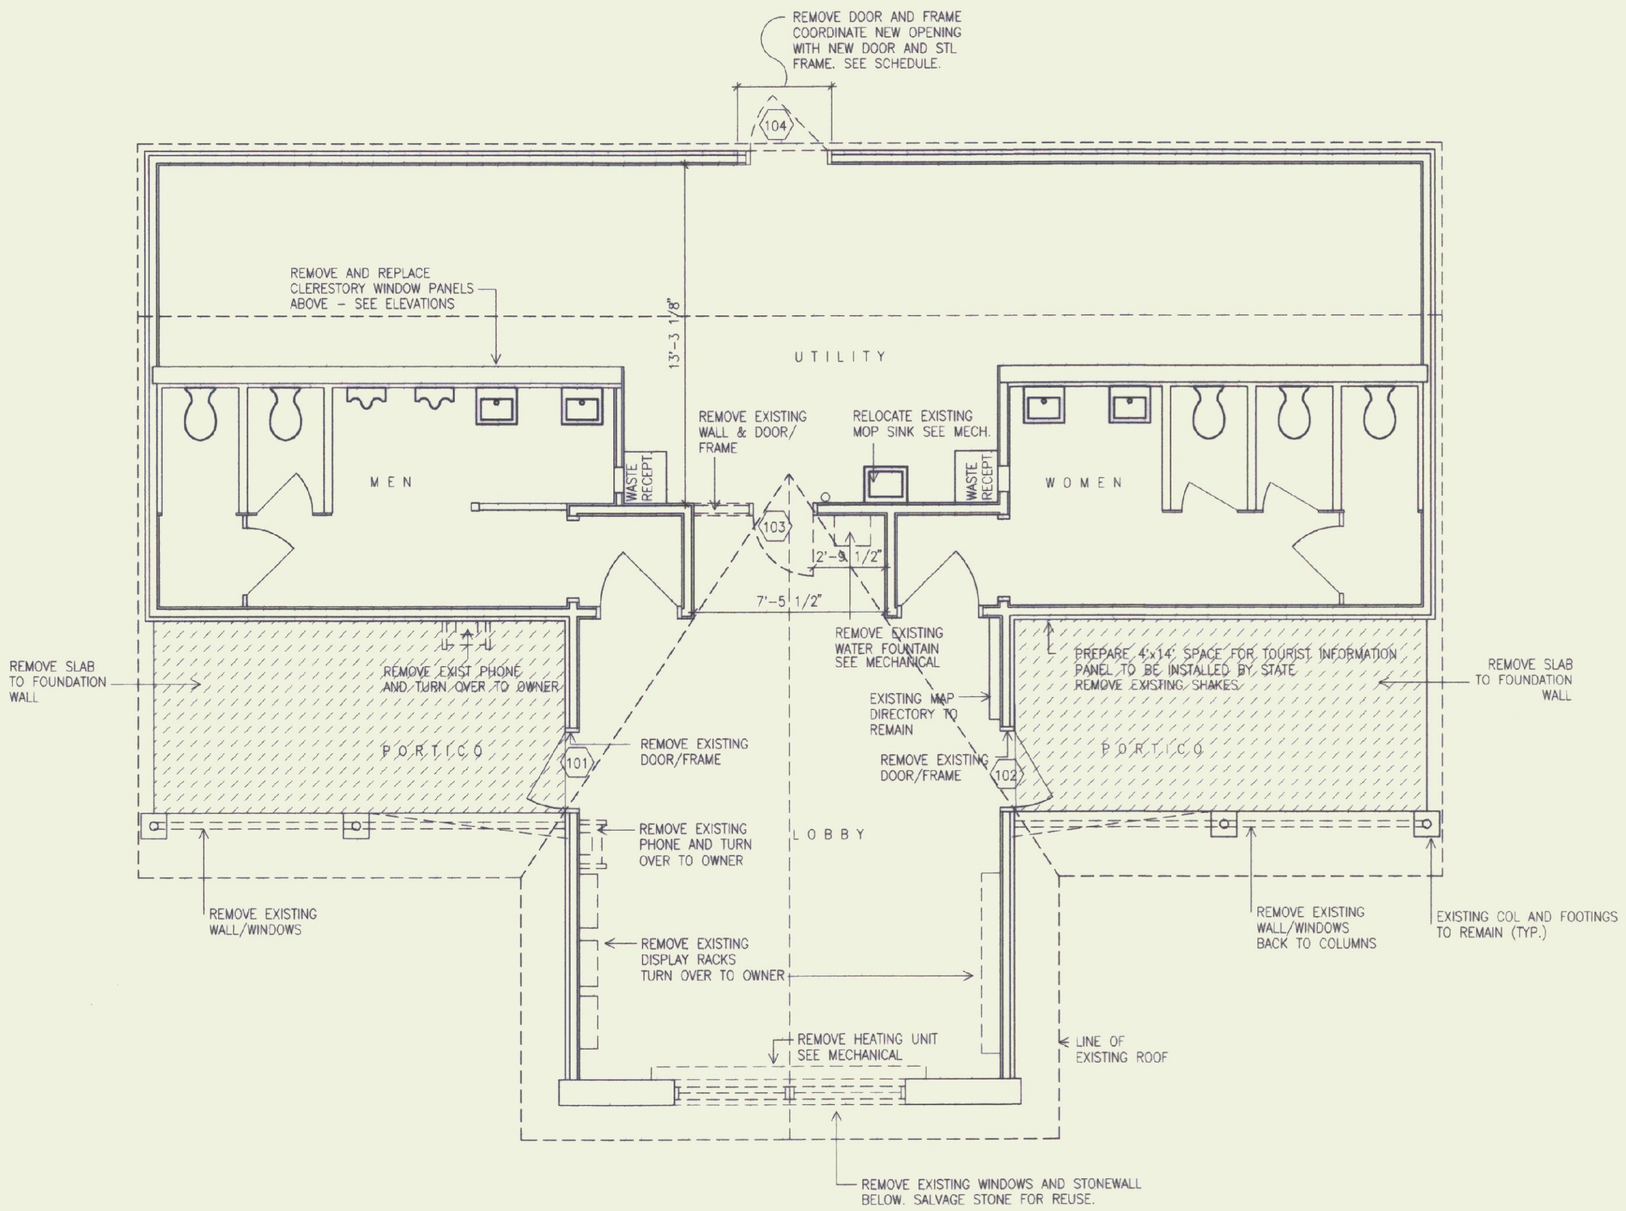

2 EXISTING FLOOR PLAN

SCALE: 1/4" = 1'

NOTES:

- REMOVE ANY EXISTING HANDICAPPED SIGNAGE AT RESTROOMS AND SIGNAGE THAT DOES NOT COMPLY
- SEE MECH / ELEC FOR ADDITIONAL REMOVALS
- SEE ELEVATIONS FOR ADDITIONAL REMOVALS

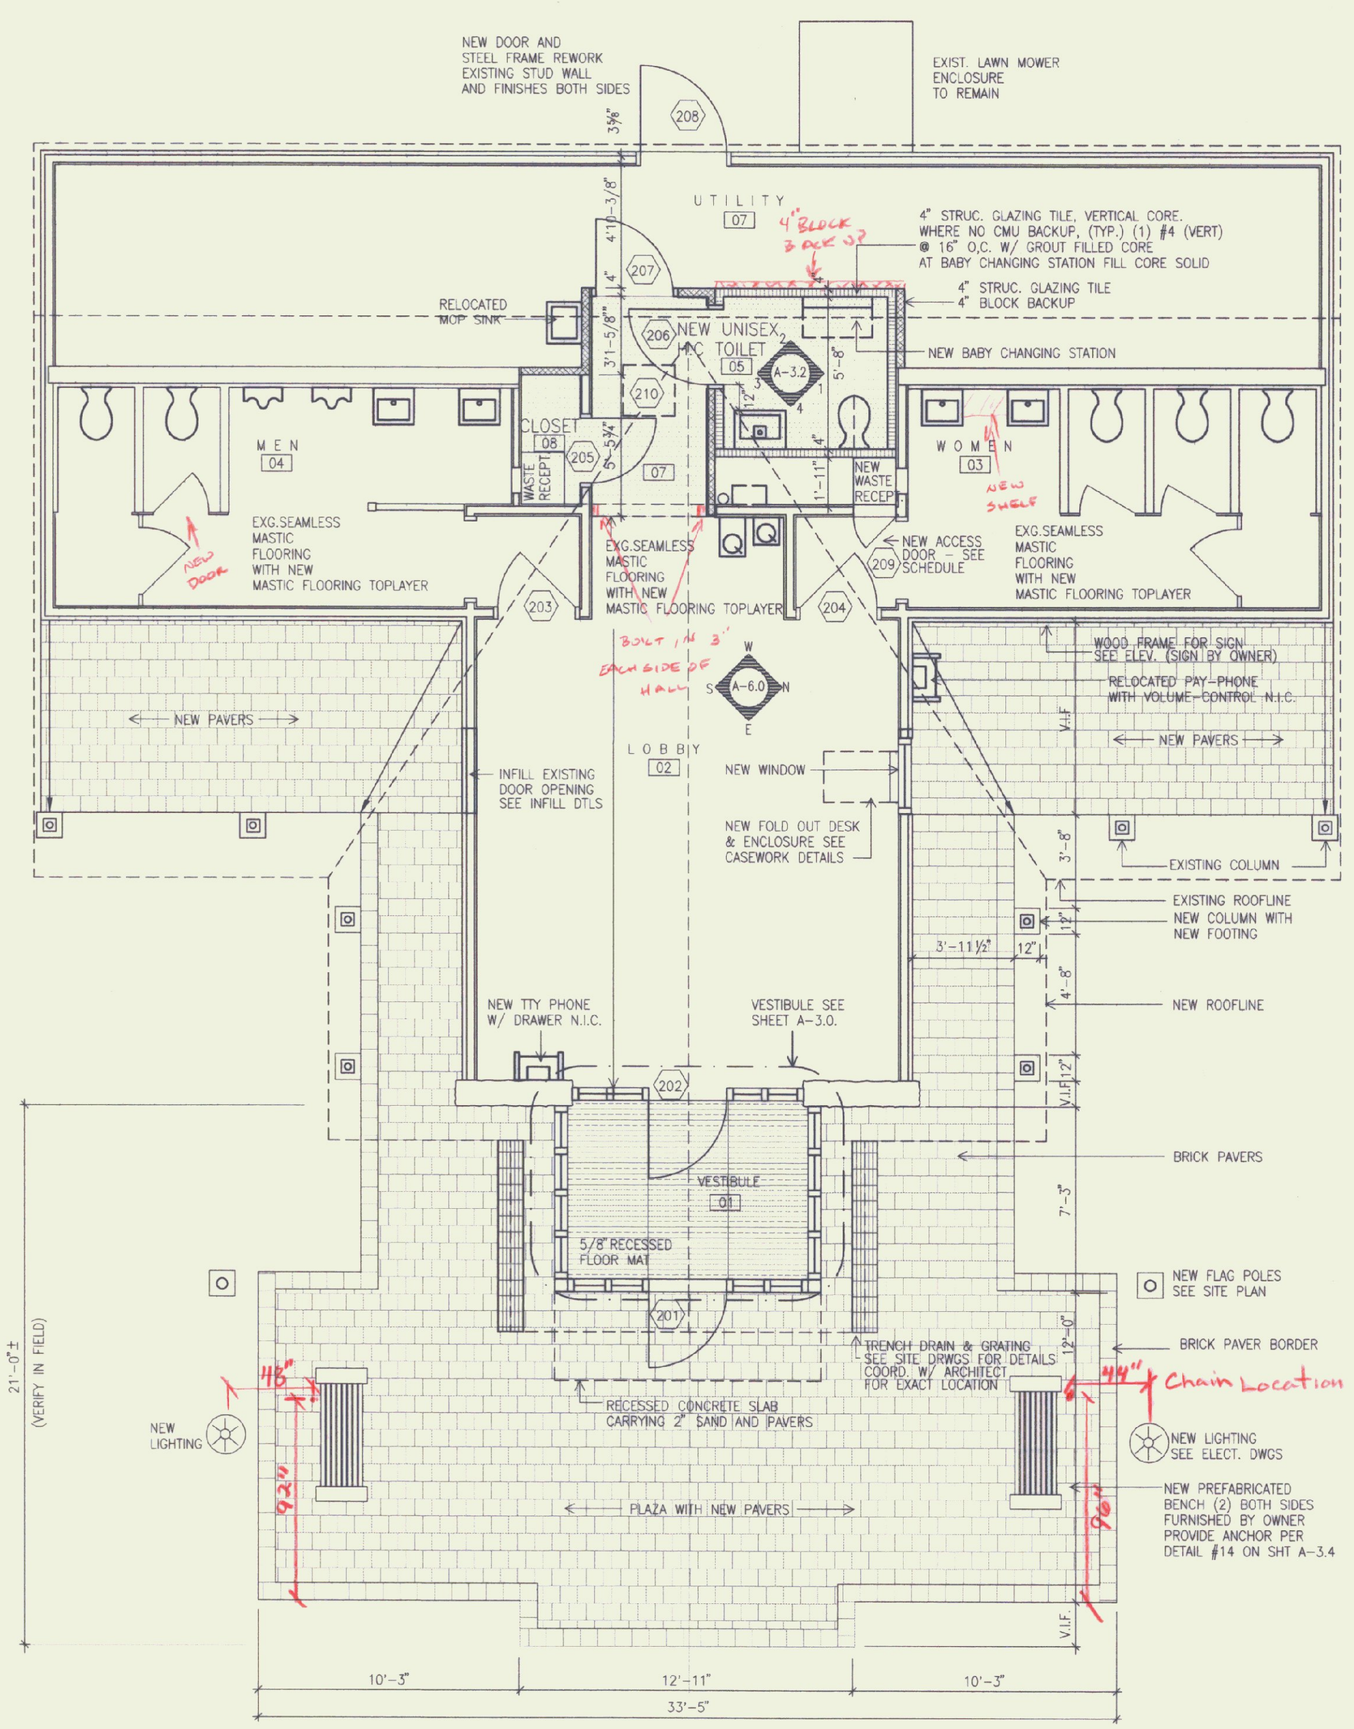

NEW GRANITE CURBING SEE SITE PLAN FOR EXTENT

NEW SIDEWALK. SEE SITEPLAN

NEW PAINTED PARKING LOT STRIPING – SEE SITE PLAN

SEE SITE DRAWINGS FOR CONTINUATION

2 NEW FLOOR PLAN

SCALE: 1/4" = 1'

NOTES:

- INSTALL NEW HANDICAPPED SIGNAGE WHERE REQUIRED
- INSTALL NEW SIGNAGE FOR BABY CHANGING STATION.

LEGEND

- CONCRETE
- CMU
- STRUCTURAL GLAZED TILE
- PRECAST CONCRETE BRICK PAVERS
- ASPHALT
- NEW MASTIC FLOORING
- SIGNAGE
- EXISTING DOOR
- NEW DOOR
- DEMOLITION

REGISTERED ARCHITECT R. JOHN BORN NO. 1169 STATE OF VERMONT

STATE OF VERMONT
DEPARTMENT OF BUILDINGS AND GENERAL SERVICES
AGENCY OF ADMINISTRATION
MONTPELIER, VERMONT

GEORGIA INTERSTATE 89 REST AREAS SOUTHBOUND

DATE:	SCALE:	REVISIONS:	DRAWING NAME:
AUGUST 21, 1998	1/4"=1'-0"		BUILDING PLAN
DRAWN BY: MSS	PROJECT NO. IM 089-3 (30)		DRAWING NO: A-2.0
CHECKED BY: JBA			

SHEET _____ OF _____

G:\PROJECTS\AOA\GEORG-NS\A20 Mon Aug 24 08:45:43 1998 Plotter By: Michael S. Siamaskas