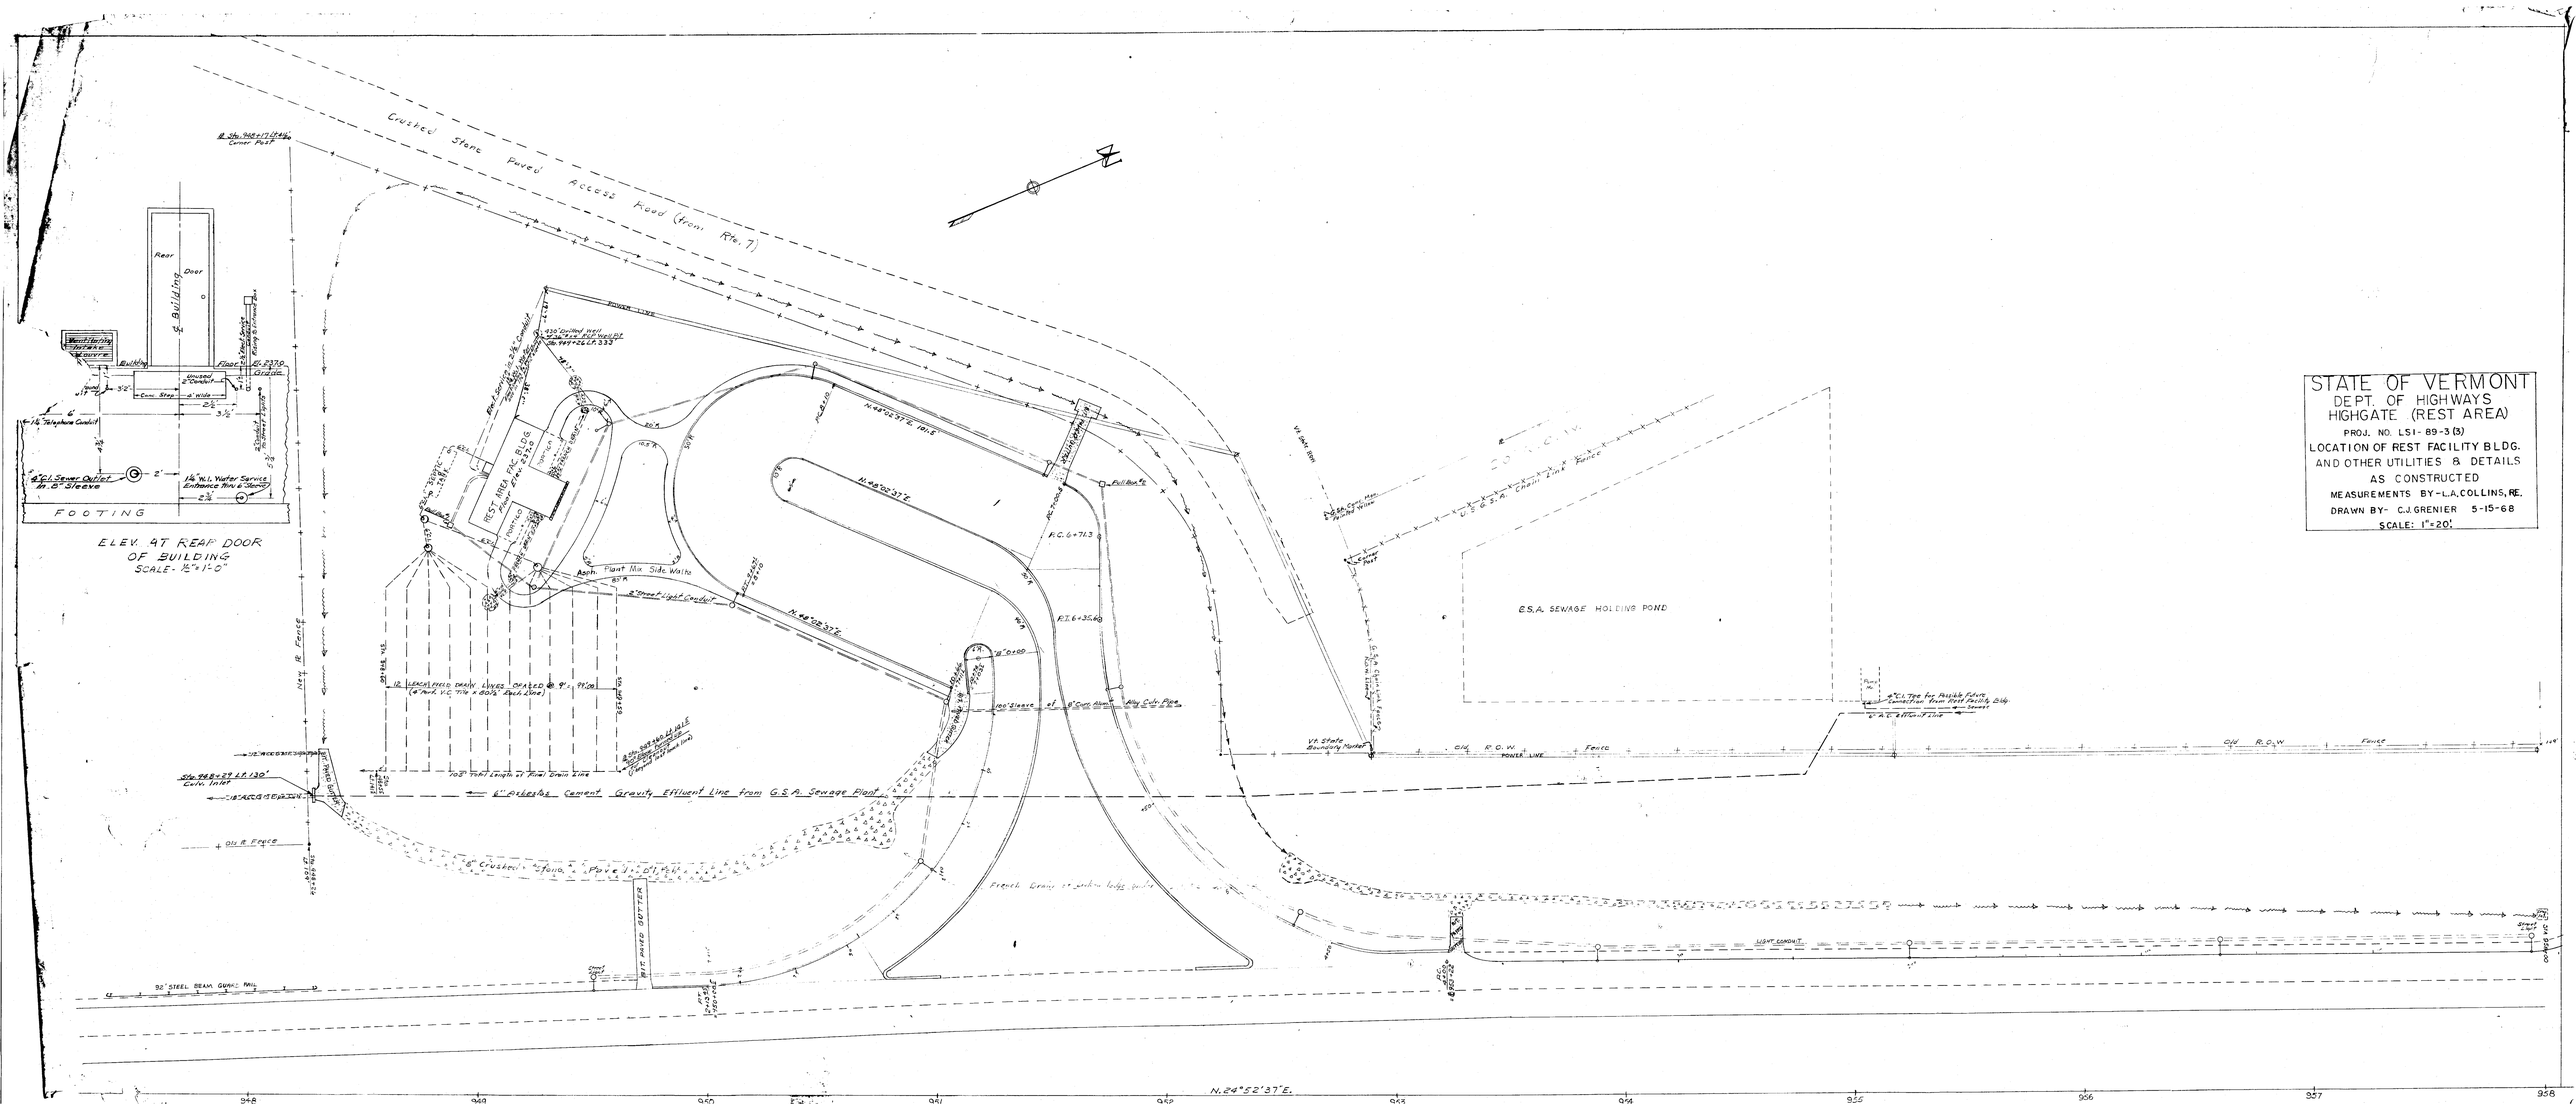
STATE OF VERMONT
DEPT. OF HIGHWAYS
HIGHGATE (REST AREA)
PROJ. NO. LSI-89-3(3)
LOCATION OF REST FACILITY BLDG.
AND OTHER UTILITIES & DETAILS
AS CONSTRUCTED
MEASUREMENTS BY-L.A. COLLINS, RE.
DRAWN BY- C.J. GRENIER 5-15-68
SCALE: 1"=20'
Crushed Stone Paved Access Road (From Rte. 7)
N
Rear Door
℄ Building
Water Heater
Furnace
Building
Floor El. 237.0
Grade
Housed 2" Conduit
Conc. Step
2' Wide
2½'
3½'
6"
14" Telephone Conduit
2" C.I. Sewer Outlet in 8" Sleeve
14" W.I. Water Service Entrance Thru 6" Sleeve
FOOTING
ELEV. AT REAR DOOR OF BUILDING
SCALE- ½"=1'-0"
POWER LINE
REST AREA BLDG.
Asph. Plant Mix Side Walks
8" Street Light Conduit
N.48°00'37"E.
N.24°52'37"E.
P.C. 6+71.3
P.T. 6+35.60
Full Box
12 LEACH FIELD DRAIN LINES GRADED @ 9" (4" Perf. V.C. Tile x 80½' Each Line)
103' Total Length of Final Drain Line
6" Asbestos Cement Gravity Effluent Line from G.S.A. Sewage Plant
6" Crushed Stone Paved Ditch
French Drains at bottom ledge
WIT PAVED GUTTER
92' STEEL BEAM GUARD RAIL
LIGHT CONDUIT
C.S.A. SEWAGE HOLDING POND
C.H. R.O.W.
Fence
U.S.G.S. A. Chain Link Fence
Vt. State Boundary Marker
Fence
Sewer Line
Drainage Ditch