STATE OF VERMONT
AGENCY OF TRANSPORTATION
MATERIALS & RESEARCH SECTION
SUBSURFACE INFORMATION

BORING NUMBER: MW-304c
SHEET 1 of 3
DATE STARTED: 6/12/13
DATE COMPLETED: 6/12/13

PROJECT NAME: Newport City STP 134-3(22)
SITE NAME: Route 191 Landslide
STATION: -
OFFSET: -
VTSPG: N 888295.13 ft E 1721196.97 ft

PROJECT NUMBER: GAI 133-87312
SITE NUMBER: -
GROUND ELEVATION: 800.19 ft
GROUNDWATER DEPTH: 41.78 ft 6/13/13
PROJECT PIN NUMBER: -

BORING CREW: Boart Longyear
DRILLER: Jason Koering
LOGGER: Helena Hollauer
BORING RIG: 600T Sonic

BORING TYPE: Sonic
SAMPLE TYPE: Continuous Core
HAMMER TYPE: N/A
CHECKED BY:

DEPTH (ft)	SYMBOL	CLASSIFICATION OF MATERIALS (Description)	WELL DIAGRAM	BLOWS PER 6 IN (N VALUE)	M.C. (%)	AASHTO GRAVEL (%)	AASHTO SAND (%)	AASHTO FINES (%)
		Top of Well Elevation: 802.56 ft						
		0.0 ft - 46.0 ft, No samples taken.						

LOG OF BORING & WELL NEWPORT.GPJ VT AOT.GDT 8/13/14

STATE OF VERMONT
AGENCY OF TRANSPORTATION
MATERIALS & RESEARCH SECTION
SUBSURFACE INFORMATION

BORING NUMBER: MW-304c
SHEET 2 of 3
DATE STARTED: 6/12/13
DATE COMPLETED: 6/12/13

PROJECT NAME: Newport City STP 134-3(22)
SITE NAME: Route 191 Landslide
STATION: -
OFFSET: -
VTSPG: N 888295.13 ft E 1721196.97 ft

PROJECT NUMBER: GAI 133-87312
SITE NUMBER: -
GROUND ELEVATION: 800.19 ft
GROUNDWATER DEPTH: 41.78 ft 6/13/13
PROJECT PIN NUMBER: -

BORING CREW: Boart Longyear
DRILLER: Jason Koering
LOGGER: Helena Hollauer
BORING RIG: 600T Sonic

BORING TYPE: Sonic
SAMPLE TYPE: Continuous Core
HAMMER TYPE: N/A
CHECKED BY:

DEPTH (ft)	SYMBOL	CLASSIFICATION OF MATERIALS (Description)	WELL DIAGRAM	BLOWS PER 6 IN (N VALUE)	M.C. (%)	AASHTO GRAVEL (%)	AASHTO SAND (%)	AASHTO FINES (%)

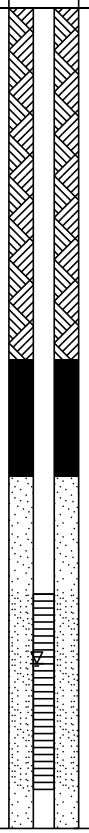

Hole stopped @ 46.0 ft

Notes:
- 6" casing with continuous 4" core barrel sampling used in exploration.
- Boring completed to set well casing. Use B-304a and B-304b for stratigraphy.
- 2" well screen set 40 to 45 ft. Sand pack from 37 to 46 ft. Bentonite chips from 34 to 37 ft. Grouted from 37 ft to ground

LOG OF BORING & WELL NEWPORT.GPJ VT AOT.GDT 8/13/14