


MS # 100

VT 67A NORTH

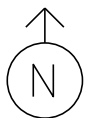

HANNAFORDS


BENNINGTON PLAZA

12' 12' 12' 12' 12'

LANE LINE 170'

(2)

ONLY

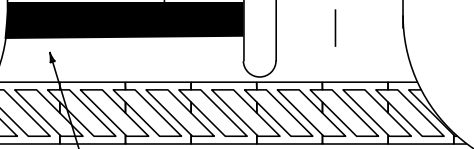

STOP BAR 36'

23'

STOP BAR 30'

LANE LINE 25'

11'



ONLY

11'

11'

ONLY



LANE LINE 120'

STOP BAR 22'

22'



STOP BAR 43'

12' 12' 12' 12' 12'

LANE LINE 170'

ONLY



VT 67A SOUTH

NOT TO SCALE