


MS # 105

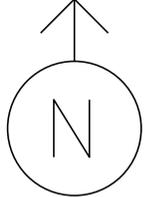


VT 7A NORTH

19'

13'

12'

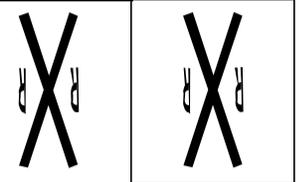

STOP

LANE LINE 120'

ONLY



14'

13'

STOP BAR 19'

CROSSWALK 60'
STOP BAR 25'

CROSSWALK 24'

21'

14'

STOP BAR 25'

11'

STOP BAR 22'

LANE LINE 75'

STOP BAR 14'

12'

ONLY



13'

BENMONT AVE.

STOP BAR 24'

15'

15'

11'

13'

ONLY

LANE LINE 110'



VT 7A SOUTH