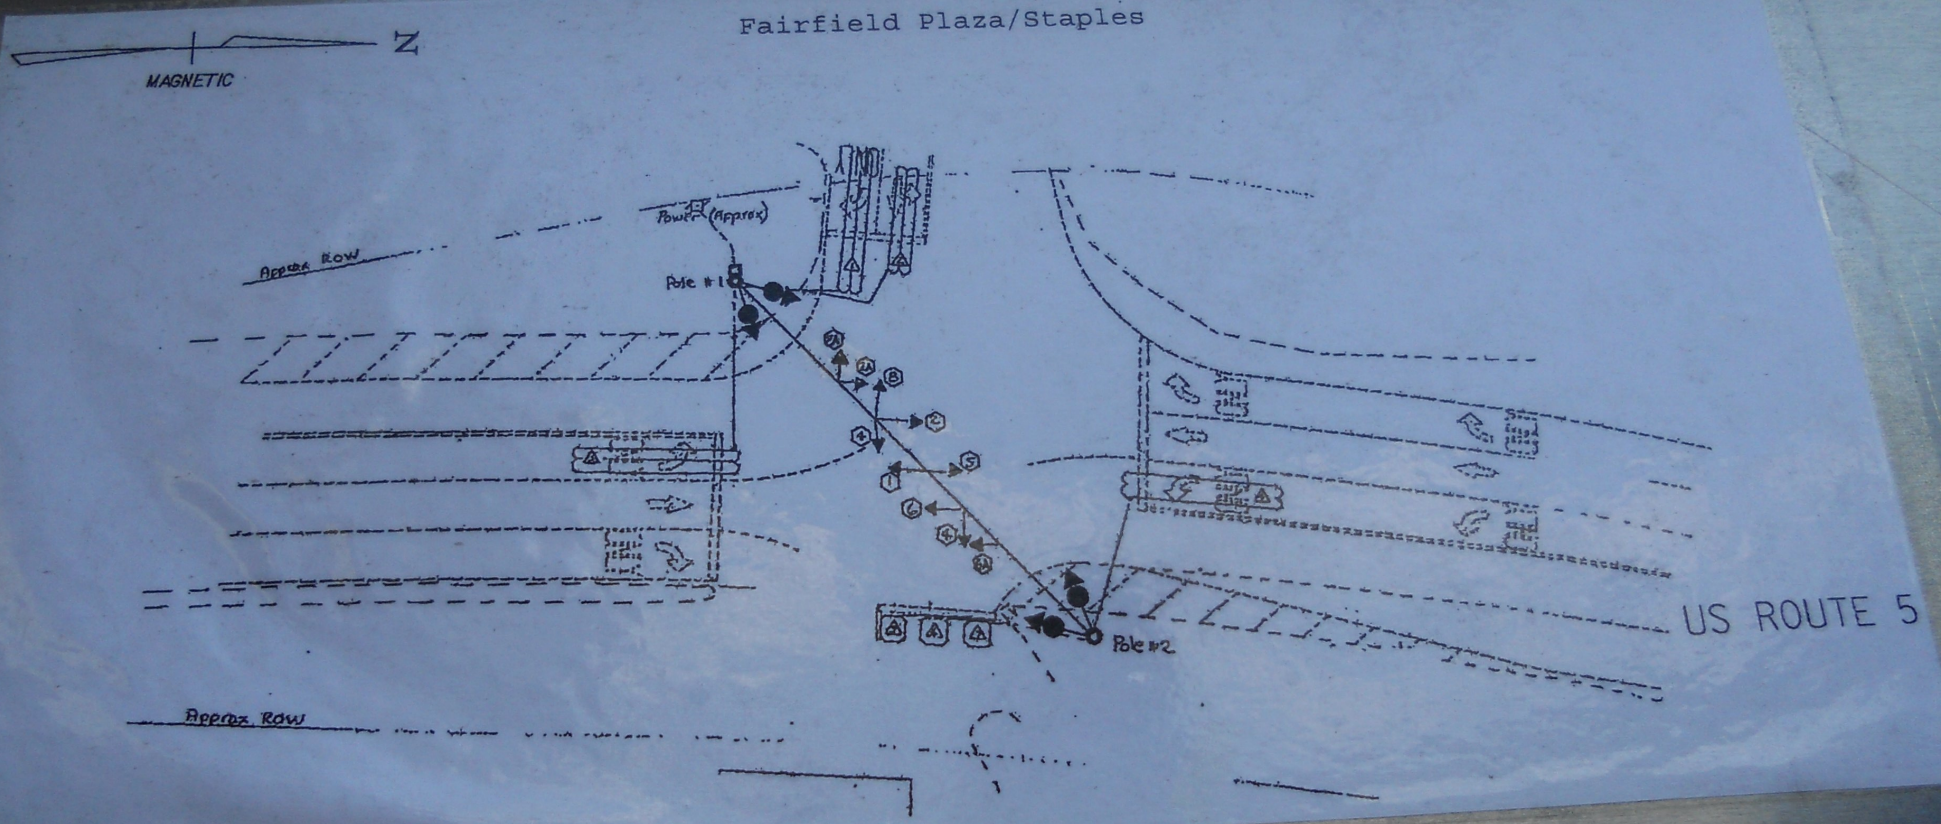

PHASE TIMINGS

US Route 5 @ Fairfield Plaza - Brattleboro, Vermont - East Coast Signal

	ø1	ø2	ø3	ø4	ø5	ø6	ø7	ø8	ø9	ø10	ø11	ø12	ø13	ø14	ø15	ø16
E																
	5	5		5	5	5		5								
RN				1.5	1.5			1.5								