



MS # 210

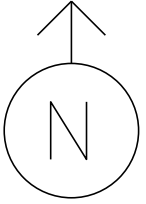

US 5 NORTH

VT 131 WEST

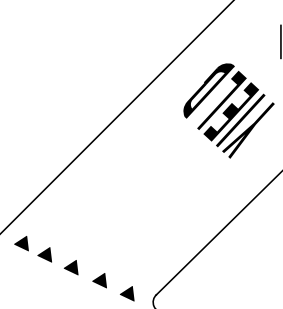

14'

14'




STOP BAR 20'



12'

STOP BAR 32'

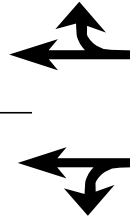

12'

11'

11' ONLY



STOP BAR 35'

12'



12'



11'


11'

STOP BAR 15'



13'

15'

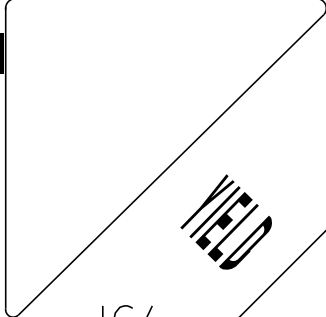

16'

VT 12 SOUTH

US 5 SOUTH

NOT TO SCALE