


MS # 301

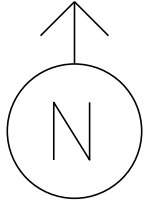


US 7 NORTH

11'

11'

VT 140 WEST

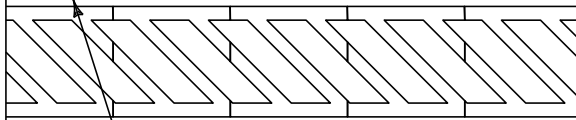

CROSSWALK 34'
STOP BAR 11'

STOP BAR 11'

11'

11'


CROSSWALK 30'

CROSSWALK 30'


11'

11'

STOP BAR 11'

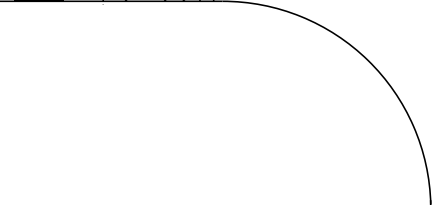

CROSSWALK 31'
STOP BAR 11'

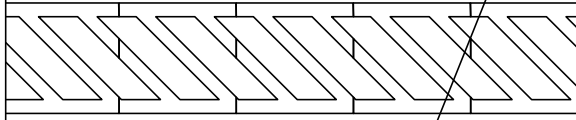

VT 140 EAST

11'

11'

US 7 SOUTH

NOT TO SCALE