



MS # 303

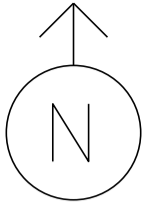

US 7 NORTH

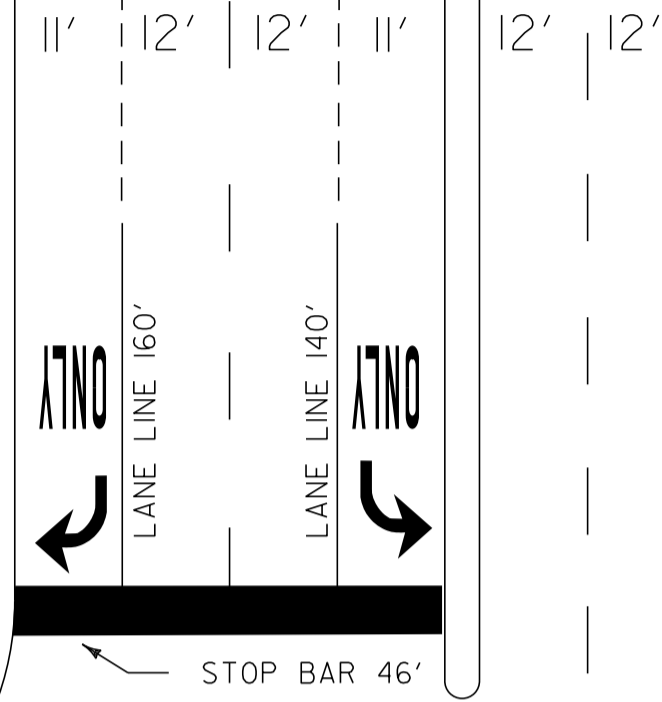

STOP BAR 50'

11'

14'

10'

STOP BAR 31'

12'

STOP BAR 37'

12' | 12' | 12' | 12' | 12'

LANE LINE 160'

ONLY

US 7 SOUTH

NORTH SHREWSBURY RD

NOT TO SCALE