


MS # 311

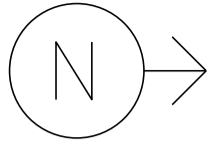

US 4 WEST

CATAMOUNT
PET SUPPLY

11'

11'

11'

11'

ONLY



STOP BAR 22'

10'

STOP BAR 23'



ONLY

11'

STOP BAR 16'



11'


11'

STOP BAR 16'

22'

HOME DEPOT

STOP BAR 32'

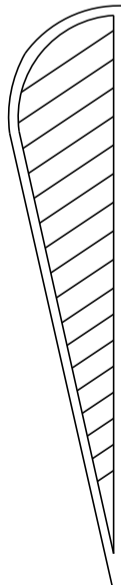

ONLY

11'

11'

11'

11'

10'

US 4 EAST

NOT TO SCALE