



MS # 411

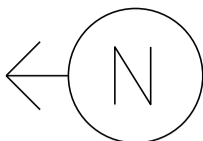

VT 10A EAST

I-91 SB ON RAMP

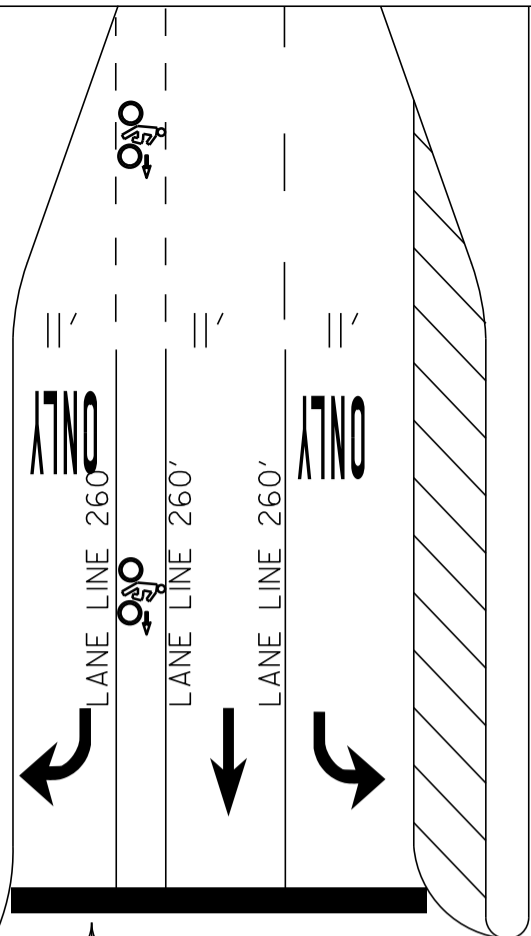

12' | 12'

STOP BAR 46'

STOP BAR 20'

STOP BAR 22'

LANE LINE 100'



11'

11'

20'

I-91 SB OFF RAMP




12' | 12' | 12'

LANE LINE 310'

STOP BAR 49'

US 5 NORTH

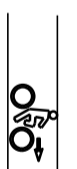

CROSSWALK 71'

18'

18'

STOP BAR 25'

US 5 SOUTH

NOT TO SCALE