



MS # 514

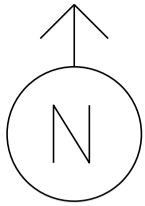

US-7 NORTH

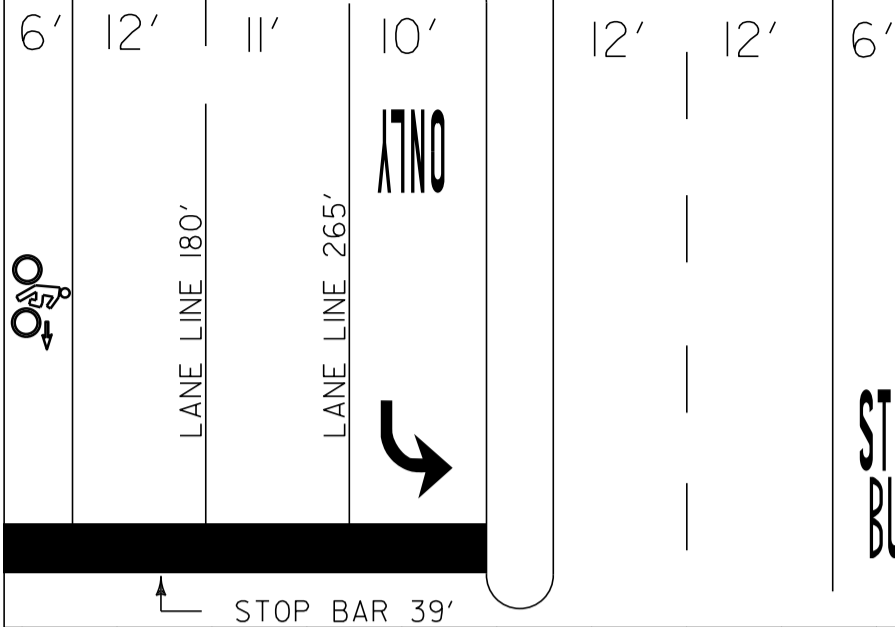

STOP BAR 39'

CROSSWALK 78'

STOP BAR 29'

12'

LANE LINE 120'

11'

11'

CROSSWALK 65'

ALLEN ROAD

MIT SUBISHI DEALERSHIP

STOP BAR 14'

STOP BAR 39'

STOP BUS

LANE LINE 160'

LANE LINE 105'

6' 12' 12'

ONLY

10'

11'

12'



US-7 SOUTH

NOT TO SCALE