



MS # 516

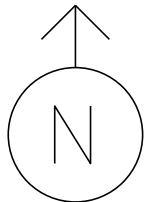

US-7 NORTH

BARLETT'S BAY ROAD

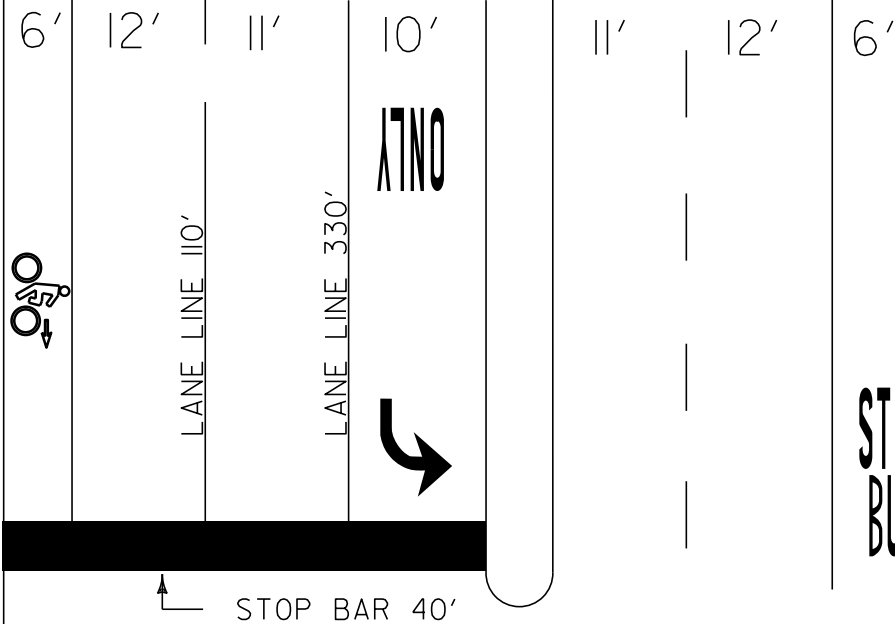

13'

12'

LANE LINE 100'

12'

STOP BAR 29'

CROSSWALK 70'

STOP BAR 29'

CROSSWALK 70'

LANE LINE 155'

14'

11'

12'

CROSSWALK 78'

STOP BAR 38'

STOP BUS



US-7 SOUTH

GREEN MNT. DR.

NOT TO SCALE