


MS # 571

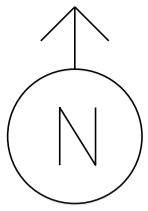

VT 2A NORTH

- ☐ PREEMPTION DETECTOR
- ☐ PREEMPTION STROBE
- ☒ CONTROL BOX
- MAST ARM
- LOOP DETECTION
- ☐ JB JUNCTION BOX
- ☉ LUMINAIRE
- STANCHION
- ROADWAY SIGN
- Ⓚ =
- Ⓢ =
- Ⓤ =

I-89 NB ON RAMP

I-89 NB OFF RAMP

6

6

ONLY

8

8

ONLY

8

9

9

9

5 B

2

8

8

8

Ⓢ


●

5

2

VT 2A SOUTH

MS # 571

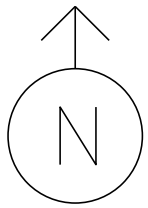

VT 2A NORTH

I-89 NB ON RAMP

I-89 NB OFF RAMP

11'

11'

12'

12'

LANE LINE 495'




STOP BAR 26'



15'

LANE LINE 175'

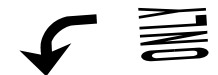

12'

STOP BAR 40'

18'

STOP BAR 22'




12'

10'

LANE LINE ---'

VT 2A SOUTH

D  
I  
A  
G  
R  
A  
M

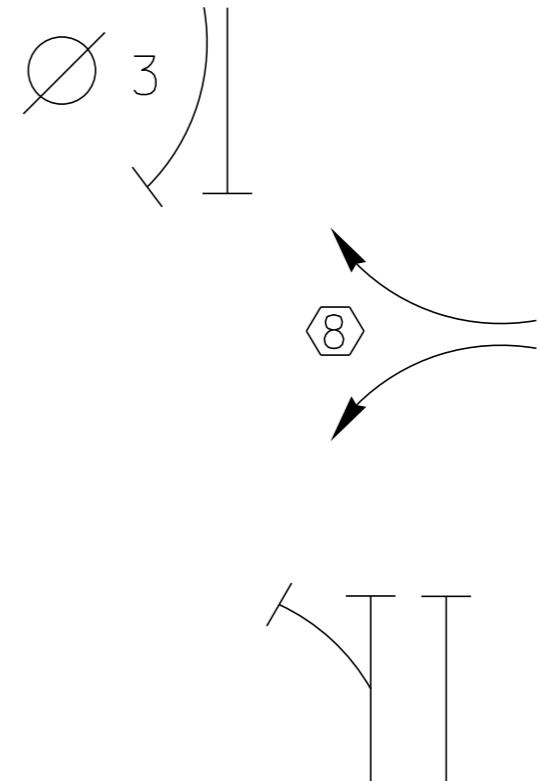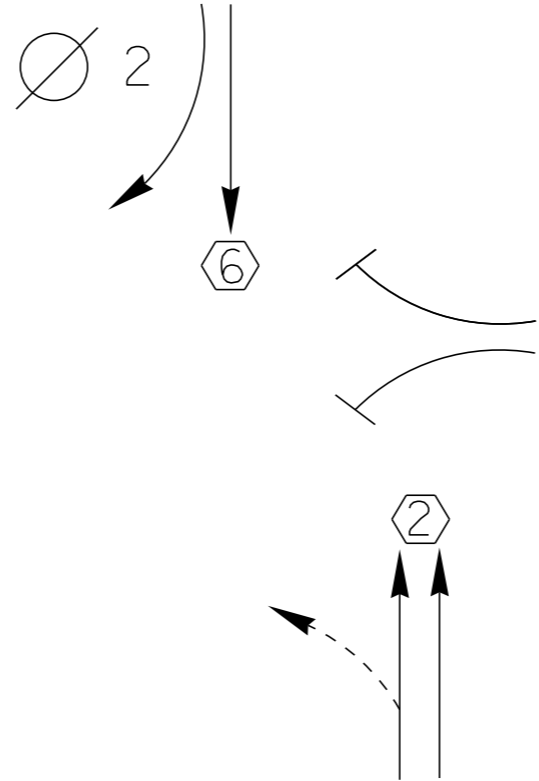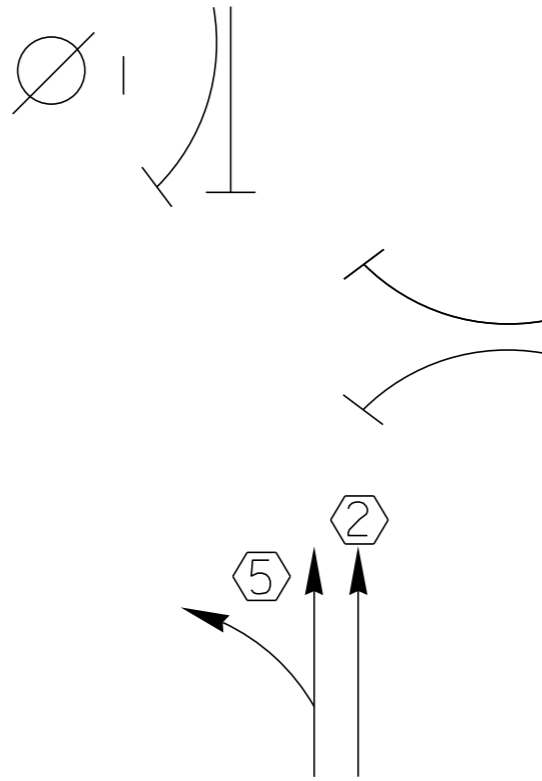

TIMING



G =  
Y =

G =  
Y =

G =  
Y =

G =  
Y =

D  
I  
A  
G  
R  
A  
M

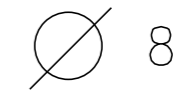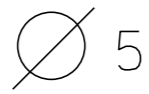


TIMING

G =  
Y =


G =  
Y =

G =  
Y =

G =  
Y =

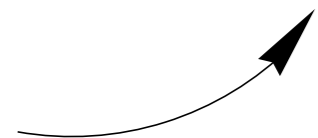

PROTECTED  
TURNS

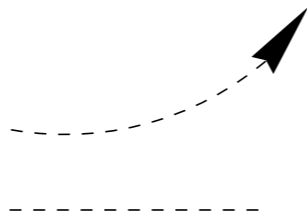

PERMITTED  
TURNS  
PEDESTRIAN

CYCLE LENGTH, C = \_\_\_\_\_ S



PROPERTY OF  
VT. AGENCY OF TRANS.  
MAINTENANCE DIV.

IN EMERGENCY CALL:  
DIST. TRANS. OFFICE

NIGHT & WEEKENDS:

INTERSECTION NO.

[REDACTED]

[REDACTED]

[REDACTED]

**WARNING**  
DO NOT OPERATE  
CABINET WITHOUT  
CMU / MMU

TURN ON  
12 10 01

**DANGER**  
115 VOLTS A.C.

CONTROLLER  
ON  
OFF

SIGNALS  
AUTO  
FLASH

MAIN  
ON  
OFF

STOP TIME  
AUTO  
OFF  
ON

12 10 01




SECONOLITE


WARRANTY

SECONOLITE

TURN ON

12 10 01

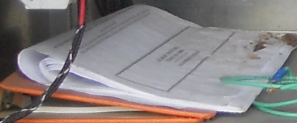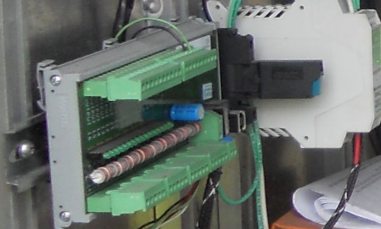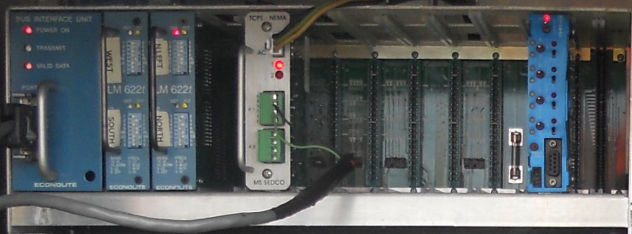

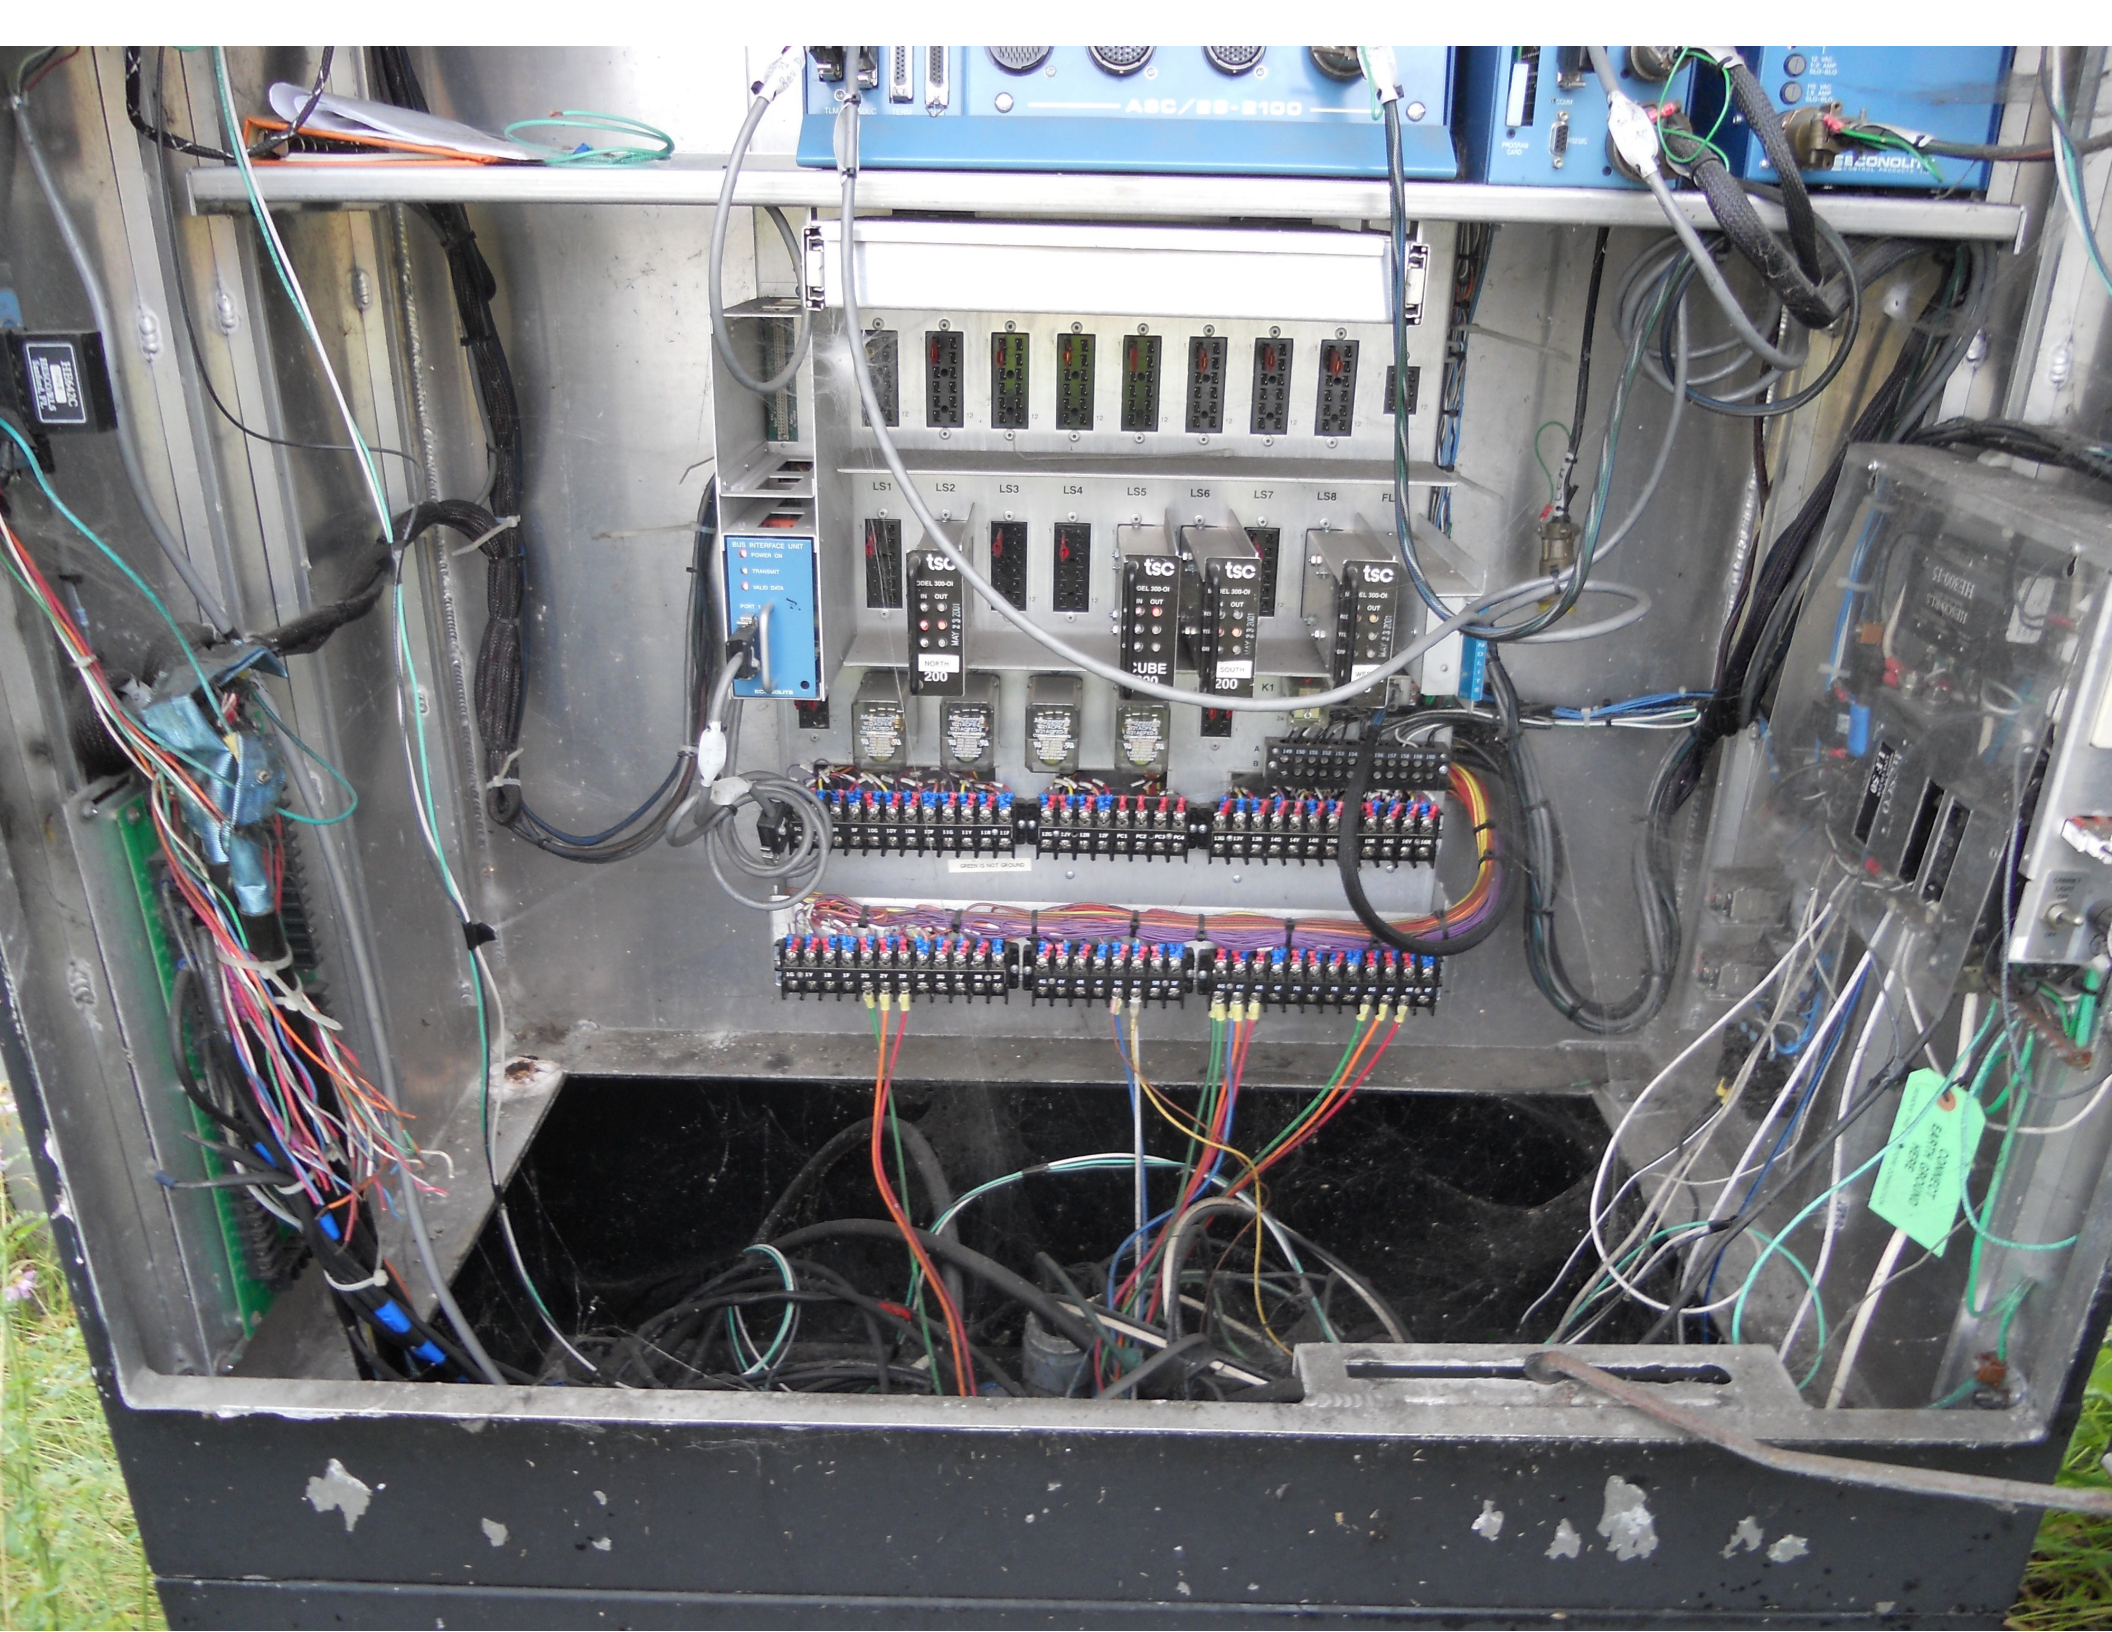

ABC/BB-2100

REL 300-01  
REL 300-02  
REL 300-01  
REL 300-02  
REL 300-01  
REL 300-02  
REL 300-01  
REL 300-02

LS1 LS2 LS3 LS4 LS5 LS6 LS7 LS8 FL

RUE INTERFACE UNIT  
POWER ON  
TRANSMIT  
REC'D DATA  
PORT 1  
tsc-100-010

tsc  
REL 300-01  
IN OUT  
NORTH 200  
MW 23200

tsc  
REL 300-01  
IN OUT  
SOUTH 200  
MW 23200


tsc  
REL 300-01  
IN OUT  
K1  
MW 23200

tsc  
REL 300-01  
IN OUT  
K2  
MW 23200




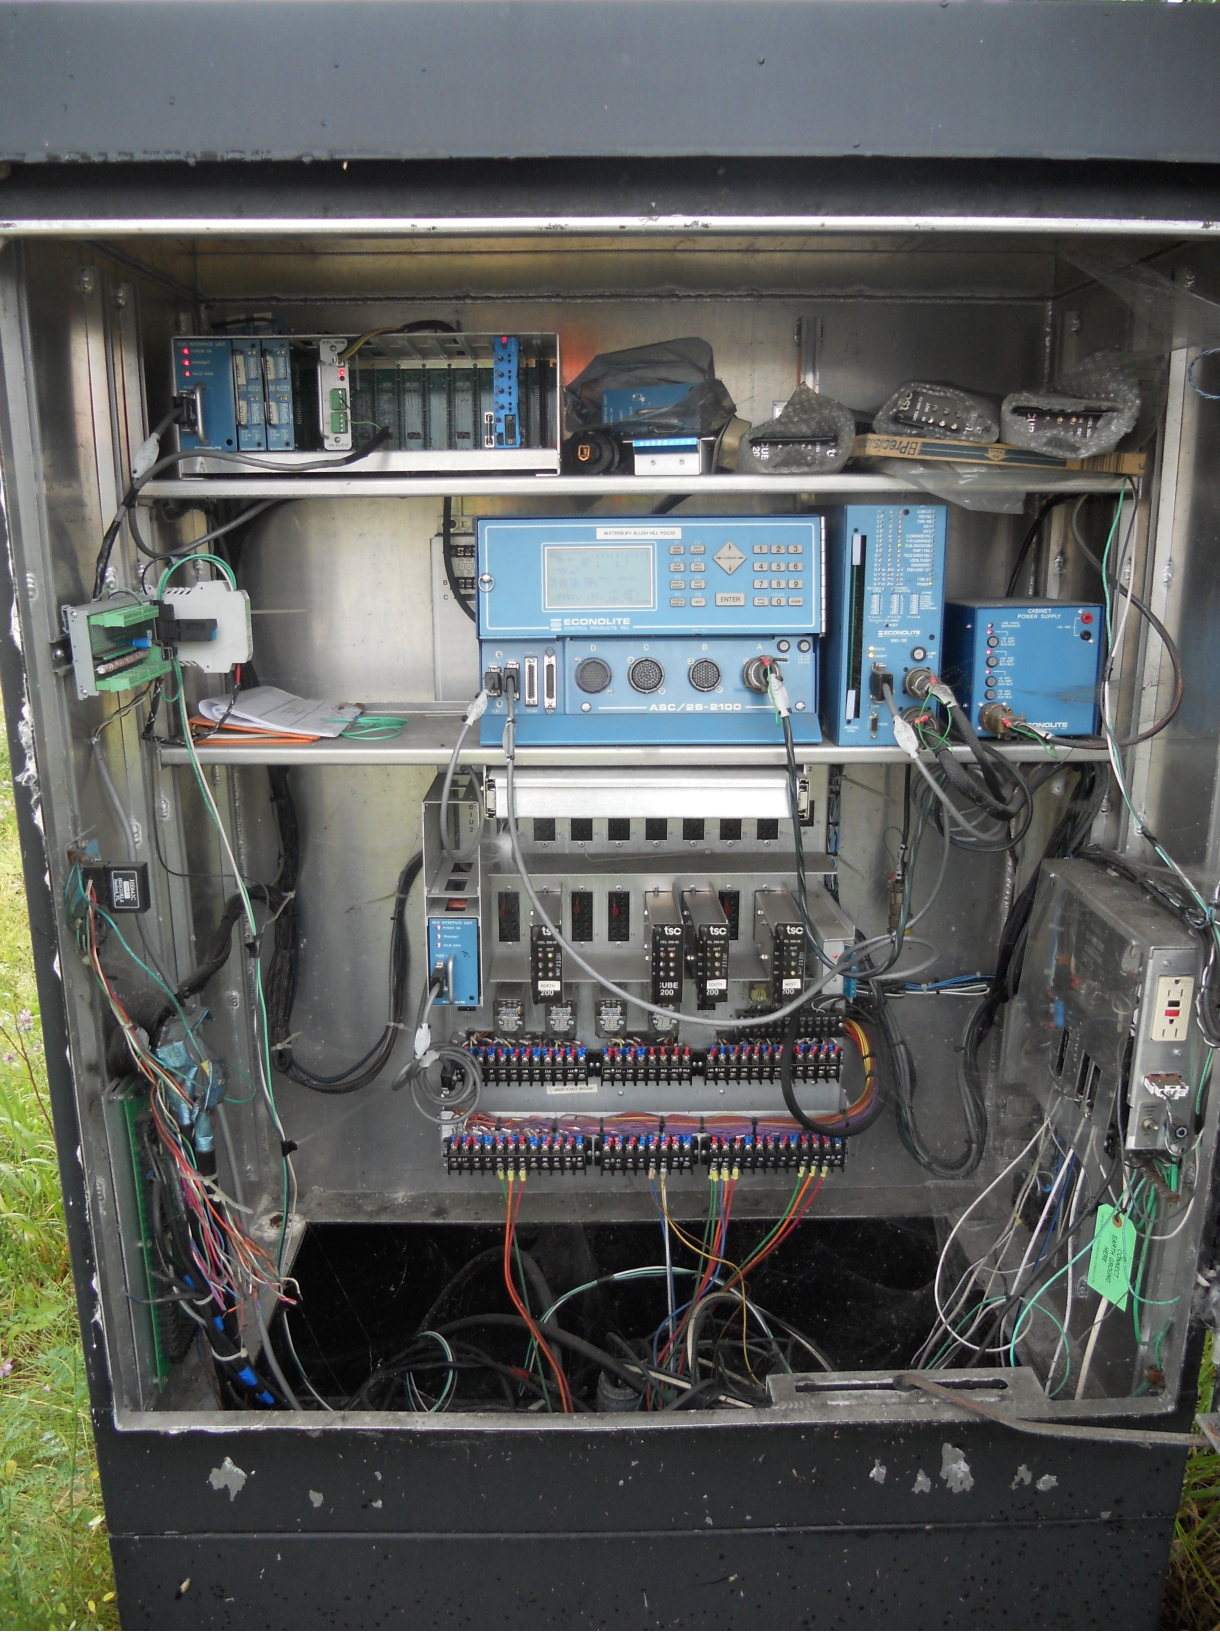







LEFT TURN  
YIELD  
ON GREEN

SUNOCO

369  
379  
389

SPEED  
LIMIT





WE-15.0X32

7E-9.61X55

55KSI

2001

UNION METAL CORPORATION



Con-way  
TRUCK

ONLY ONLY

ONLY ONLY







↑  
↗  
ONLY

89

St. Joseph









89 SOUTH  
←

2A TO 116  
↓

RIGHT TURN  
ON RED  
AFTER  
STOPPING

ONLY ↑





2E-11.0X32  
2E-8.0X35  
55KSI  
2001  
ALUMINUM METAL CORPORATION





© 2012 Google

Google earth





Coordination Patterns

```

-----
Pattern 1
Cycle Length . . . 84  COS . . . . . 111
Offset . . . . . 5
Vehicle Permissive . . [1] 0 [2] 0
Vehicle Perm 2 Displacement 0 Phase Reservice. . NO
Splits: Phase 1- 0 2- 59 3- 0 4- 0
          Phase 5- 14 6- 45 7- 0 8- 25
          Phase 9- 0 10- 0 11- 0 12- 0 Split Sum: 0
Split Extension/Ring [1] 0 [2] 0
Split Demand Pattern [1] 0 [2] 0
XRT Pattern. . . 0
Phase Number: 1 2 3 4 5 6 7 8 9 10 11 12
Coord Phases . . . X . . . X . . . . .
Veh Recall . . . . . . . . . . . . .
Veh Max Recall . . . . . . . . . . . .
Ped Recall . . . . . . . . . . . . .
Veh Omit . . . . . . . . . . . . .
Alt Sequence . . A: . B: . C: . D: . E: . F: .
-----
    
```

```

-----
Pattern 2
Cycle Length . . . 88  COS . . . . . 211
Offset . . . . . 21
Vehicle Permissive . . [1] 0 [2] 0
Vehicle Perm 2 Displacement 0 Phase Reservice. . NO
Splits: Phase 1- 0 2- 61 3- 0 4- 0
          Phase 5- 11 6- 50 7- 0 8- 27
          Phase 9- 0 10- 0 11- 0 12- 0 Split Sum: 0
Split Extension/Ring [1] 0 [2] 0
Split Demand Pattern [1] 0 [2] 0
XRT Pattern. . . 0
Phase Number: 1 2 3 4 5 6 7 8 9 10 11 12
Coord Phases . . . X . . . X . . . . .
Veh Recall . . . . . . . . . . . . .
Veh Max Recall . . . . . . . . . . . .
Ped Recall . . . . . . . . . . . . .
Veh Omit . . . . . . . . . . . . .
Alt Sequence . . A: . B: . C: . D: . E: . F: .
-----
    
```

```

-----
Pattern 3
Cycle Length . . . 96  COS . . . . . 311
Offset . . . . . 30
Vehicle Permissive . . [1] 0 [2] 0
Vehicle Perm 2 Displacement 0 Phase Reservice. . NO
Splits: Phase 1- 0 2- 78 3- 0 4- 0
          Phase 5- 11 6- 67 7- 0 8- 18
          Phase 9- 0 10- 0 11- 0 12- 0 Split Sum: 0
Split Extension/Ring [1] 0 [2] 0
Split Demand Pattern [1] 0 [2] 0
XRT Pattern. . . 0
Phase Number: 1 2 3 4 5 6 7 8 9 10 11 12
Coord Phases . . . . . . . . . . . . .
Veh Recall . . . . . . . . . . . . .
Veh Max Recall . . . . . . . . . . . .
Ped Recall . . . . . . . . . . . . .
Veh Omit . . . . . . . . . . . . .
Alt Sequence . . A: . B: . C: . D: . E: . F: .
-----
    
```



NIC Program Steps

-----

Step	Program	Step Begins	Pattern	Override
1	1	0600	1	NO
2	1	1000	2	NO
3	1	1430	3	NO
4	1	1900	2	NO
5	1	2200	0	NO
6	2	0600	1	NO
7	2	0900	3	NO
8	2	2200	0	NO

TOD Program Steps

-----  
 Step 1            Program 1            Step Begins    0600

Flash. . . . . Dimming Enable. . . . .  
 Red Rest . . . . . Alt Veh Extension . . . . .  
 Spare 5. . . . . Det Log Enable. . . . .  
 Spare 3. . . . . Spare 4 . . . . .  
 Type 0 Dly Enable. . . Spare 2 . . . . .  
 Det Diag Plan. . . . 0

Phase Number

	1	2	3	4	5	6	7	8	9	10	11	12
Max 2 Enable . . . . .	.	.	.	.	.	.	.	.	.	.	.	.
Max 3 Enable . . . . .	.	.	.	.	.	.	.	.	.	.	.	.
Veh Recall . . . . .	.	.	.	.	.	.	.	.	.	.	.	.
Veh Max Recall . . . . .	.	X	.	.	.	X	.	.	.	.	.	.
Ped Recall . . . . .	.	.	.	.	.	.	.	.	.	.	.	.
Cond Service Inhibit. . . . .	.	.	.	.	.	.	.	.	.	.	.	.
Phase Omit . . . . .	.	.	.	.	.	.	.	.	.	.	.	.
Special Function . . . . .	.	.	.	.	.	.	.	.	.	.	.	.

A    B    C    D    E    F

Alt Sequence . . . . .  
 -----

Step 2            Program 1            Step Begins    1000

Flash. . . . . Dimming Enable. . . . .  
 Red Rest . . . . . Alt Veh Extension . . . . .  
 Spare 5. . . . . Det Log Enable. . . . .  
 Spare 3. . . . . Spare 4 . . . . .  
 Type 0 Dly Enable. . . Spare 2 . . . . .  
 Det Diag Plan. . . . 0

Phase Number

	1	2	3	4	5	6	7	8	9	10	11	12
Max 2 Enable . . . . .	X	X	X	X	X	X	X	X	.	.	.	.
Max 3 Enable . . . . .	.	.	.	.	.	.	.	.	.	.	.	.
Veh Recall . . . . .	.	.	.	.	.	.	.	.	.	.	.	.
Veh Max Recall . . . . .	.	X	.	.	.	X	.	.	.	.	.	.
Ped Recall . . . . .	.	.	.	.	.	.	.	.	.	.	.	.
Cond Service Inhibit. . . . .	.	.	.	.	.	.	.	.	.	.	.	.
Phase Omit . . . . .	.	.	.	.	.	.	.	.	.	.	.	.
Special Function . . . . .	.	.	.	.	.	.	.	.	.	.	.	.

A    B    C    D    E    F

Alt Sequence . . . . .  
 -----

TOD Program Steps

-----  
 Step 3            Program 1            Step Begins    1430

Flash. . . . . Dimming Enable. . . . .  
 Red Rest . . . . . Alt Veh Extension . . . . .  
 Spare 5. . . . . Det Log Enable. . . . .  
 Spare 3. . . . . Spare 4 . . . . .  
 Type 0 Dly Enable. . . Spare 2 . . . . .  
 Det Diag Plan. . . . 0

Phase Number

	1	2	3	4	5	6	7	8	9	10	11	12
Max 2 Enable . . . . .	.	.	.	.	.	.	.	.	.	.	.	.
Max 3 Enable . . . . .	X	X	X	X	X	X	X	X	.	.	.	.
Veh Recall . . . . .	.	.	.	.	.	.	.	.	.	.	.	.
Veh Max Recall . . . . .	.	X	.	.	.	X	.	.	.	.	.	.
Ped Recall . . . . .	.	.	.	.	.	.	.	.	.	.	.	.
Cond Service Inhibit. . . . .	.	.	.	.	.	.	.	.	.	.	.	.
Phase Omit . . . . .	.	.	.	.	.	.	.	.	.	.	.	.
Special Function . . . . .	.	.	.	.	.	.	.	.	.	.	.	.

A    B    C    D    E    F

Alt Sequence . . . . .  
 -----

Step 4            Program 1            Step Begins    1900

Flash. . . . . Dimming Enable. . . . .  
 Red Rest . . . . . Alt Veh Extension . . . . .  
 Spare 5. . . . . Det Log Enable. . . . .  
 Spare 3. . . . . Spare 4 . . . . .  
 Type 0 Dly Enable. . . Spare 2 . . . . .  
 Det Diag Plan. . . . 0

Phase Number

	1	2	3	4	5	6	7	8	9	10	11	12
Max 2 Enable . . . . .	X	X	X	X	X	X	X	X	.	.	.	.
Max 3 Enable . . . . .	.	.	.	.	.	.	.	.	.	.	.	.
Veh Recall . . . . .	.	X	.	.	.	X	.	.	.	.	.	.
Veh Max Recall . . . . .	.	.	.	.	.	.	.	.	.	.	.	.
Ped Recall . . . . .	.	.	.	.	.	.	.	.	.	.	.	.
Cond Service Inhibit. . . . .	.	.	.	.	.	.	.	.	.	.	.	.
Phase Omit . . . . .	.	.	.	.	.	.	.	.	.	.	.	.
Special Function . . . . .	.	.	.	.	.	.	.	.	.	.	.	.

A    B    C    D    E    F

Alt Sequence . . . . .  
 -----

TOD Program Steps

-----  
 Step 5            Program 1            Step Begins    2200

Flash. . . . . Dimming Enable. . . . .  
 Red Rest . . . . . Alt Veh Extension . . . . .  
 Spare 5. . . . . Det Log Enable. . . . .  
 Spare 3. . . . . Spare 4 . . . . .  
 Type 0 Dly Enable. . . Spare 2 . . . . .  
 Det Diag Plan. . . . 0

Phase Number

	1	2	3	4	5	6	7	8	9	10	11	12
Max 2 Enable . . . . .	.	.	.	.	.	.	.	.	.	.	.	.
Max 3 Enable . . . . .	.	.	.	.	.	.	.	.	.	.	.	.
Veh Recall . . . . .	.	.	.	.	.	.	.	.	.	.	.	.
Veh Max Recall . . . . .	.	X	.	.	.	X	.	.	.	.	.	.
Ped Recall . . . . .	.	.	.	.	.	.	.	.	.	.	.	.
Cond Service Inhibit. . . . .	.	.	.	.	.	.	.	.	.	.	.	.
Phase Omit . . . . .	.	.	.	.	.	.	.	.	.	.	.	.
Special Function . . . . .	.	.	.	.	.	.	.	.	.	.	.	.

A    B    C    D    E    F

Alt Sequence . . . . .  
 -----

Step 6            Program 2            Step Begins    0600

Flash. . . . . Dimming Enable. . . . .  
 Red Rest . . . . . Alt Veh Extension . . . . .  
 Spare 5. . . . . Det Log Enable. . . . .  
 Spare 3. . . . . Spare 4 . . . . .  
 Type 0 Dly Enable. . . Spare 2 . . . . .  
 Det Diag Plan. . . . 0

Phase Number

	1	2	3	4	5	6	7	8	9	10	11	12
Max 2 Enable . . . . .	.	.	.	.	.	.	.	.	.	.	.	.
Max 3 Enable . . . . .	.	.	.	.	.	.	.	.	.	.	.	.
Veh Recall . . . . .	.	.	.	.	.	.	.	.	.	.	.	.
Veh Max Recall . . . . .	.	X	.	.	.	X	.	.	.	.	.	.
Ped Recall . . . . .	.	.	.	.	.	.	.	.	.	.	.	.
Cond Service Inhibit. . . . .	.	.	.	.	.	.	.	.	.	.	.	.
Phase Omit . . . . .	.	.	.	.	.	.	.	.	.	.	.	.
Special Function . . . . .	.	.	.	.	.	.	.	.	.	.	.	.

A    B    C    D    E    F

Alt Sequence . . . . .  
 -----

TOD Program Steps

-----  
 Step 7            Program 2            Step Begins    0900

Flash. . . . . Dimming Enable. . . . .  
 Red Rest . . . . . Alt Veh Extension . . . . .  
 Spare 5. . . . . Det Log Enable. . . . .  
 Spare 3. . . . . Spare 4 . . . . .  
 Type 0 Dly Enable. . . Spare 2 . . . . .  
 Det Diag Plan. . . . 0

	Phase Number											
	1	2	3	4	5	6	7	8	9	10	11	12
Max 2 Enable . . . . .	.	.	.	.	.	.	.	.	.	.	.	.
Max 3 Enable . . . . .	X	X	X	X	X	X	X	X	.	.	.	.
Veh Recall . . . . .	.	.	.	.	.	.	.	.	.	.	.	.
Veh Max Recall . . . . .	.	X	.	.	.	X	.	.	.	.	.	.
Ped Recall . . . . .	.	.	.	.	.	.	.	.	.	.	.	.
Cond Service Inhibit. . . . .	.	.	.	.	.	.	.	.	.	.	.	.
Phase Omit . . . . .	.	.	.	.	.	.	.	.	.	.	.	.
Special Function . . . . .	.	.	.	.	.	.	.	.	.	.	.	.

Alt Sequence . . . . . A B C D E F  
 -----

Step 8            Program 2            Step Begins    2200

Flash. . . . . Dimming Enable. . . . .  
 Red Rest . . . . . Alt Veh Extension . . . . .  
 Spare 5. . . . . Det Log Enable. . . . .  
 Spare 3. . . . . Spare 4 . . . . .  
 Type 0 Dly Enable. . . Spare 2 . . . . .  
 Det Diag Plan. . . . 0

	Phase Number											
	1	2	3	4	5	6	7	8	9	10	11	12
Max 2 Enable . . . . .	.	.	.	.	.	.	.	.	.	.	.	.
Max 3 Enable . . . . .	.	.	.	.	.	.	.	.	.	.	.	.
Veh Recall . . . . .	.	.	.	.	.	.	.	.	.	.	.	.
Veh Max Recall . . . . .	.	X	.	.	.	X	.	.	.	.	.	.
Ped Recall . . . . .	.	.	.	.	.	.	.	.	.	.	.	.
Cond Service Inhibit. . . . .	.	.	.	.	.	.	.	.	.	.	.	.
Phase Omit . . . . .	.	.	.	.	.	.	.	.	.	.	.	.
Special Function . . . . .	.	.	.	.	.	.	.	.	.	.	.	.

Alt Sequence . . . . . A B C D E F  
 -----