


MS # 604

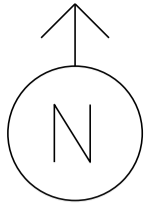

11'

11'


11'

11'

11'

US 302 WEST

SHOPPING CENTER

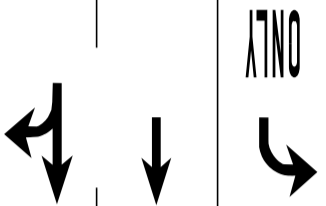

LANE LINE 185'

STOP BAR 33'

12'

STOP BAR 16'

STOP BAR 25'




LANE LINE 75'

12'

12'

18'

STOP BAR 40'

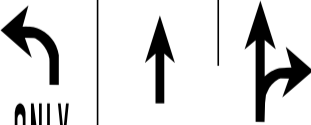

LANE LINE 55'

11'

11'

11'

11'

11'

US 302 EAST

NOT TO SCALE