


MS # 612

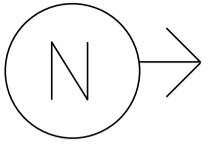


VT-62 WEST

12' 11'

12'

LANE LINE 290'

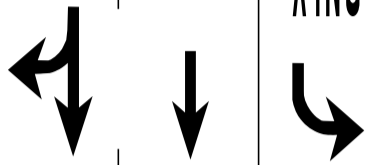


ONLY

STOP BAR 35'

CROSSWALK 72'

STOP BAR 26'

LANE LINE 50' 18'

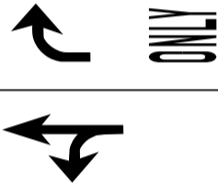


ONLY

19' LANE LINE 50'

STOP BAR 38'

ONLY

STOP BAR 35'

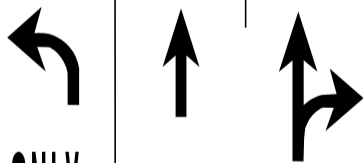

ONLY

LANE LINE 245'

12'

13'

11'

VT-62 EAST

BERLIN ST

NOT TO SCALE

BERLIN ST