


MS # 704

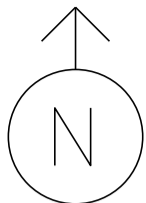

US 5 NORTH

VT 25 WEST



ONLY



CONTROL BOX



=



ONLY




VT 25 EAST

US 5 SOUTH

NOT TO SCALE

MS # 704

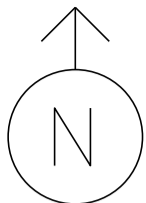

VT 25 WEST

14'

12'

14'

US 5 NORTH

LANE LINE 300'

ONLY



STOP BAR 24'

STOP BAR 31'

15'

11'

10'

LANE LINE 60'

STOP BAR 21'

STOP BAR 20'

LANE LINE 90'

9'

10'

STOP BAR 24'

STOP BAR 14'

12'

VT 25 EAST

ONLY


12'




LANE LINE 210'

14'

US 5 SOUTH

NOT TO SCALE

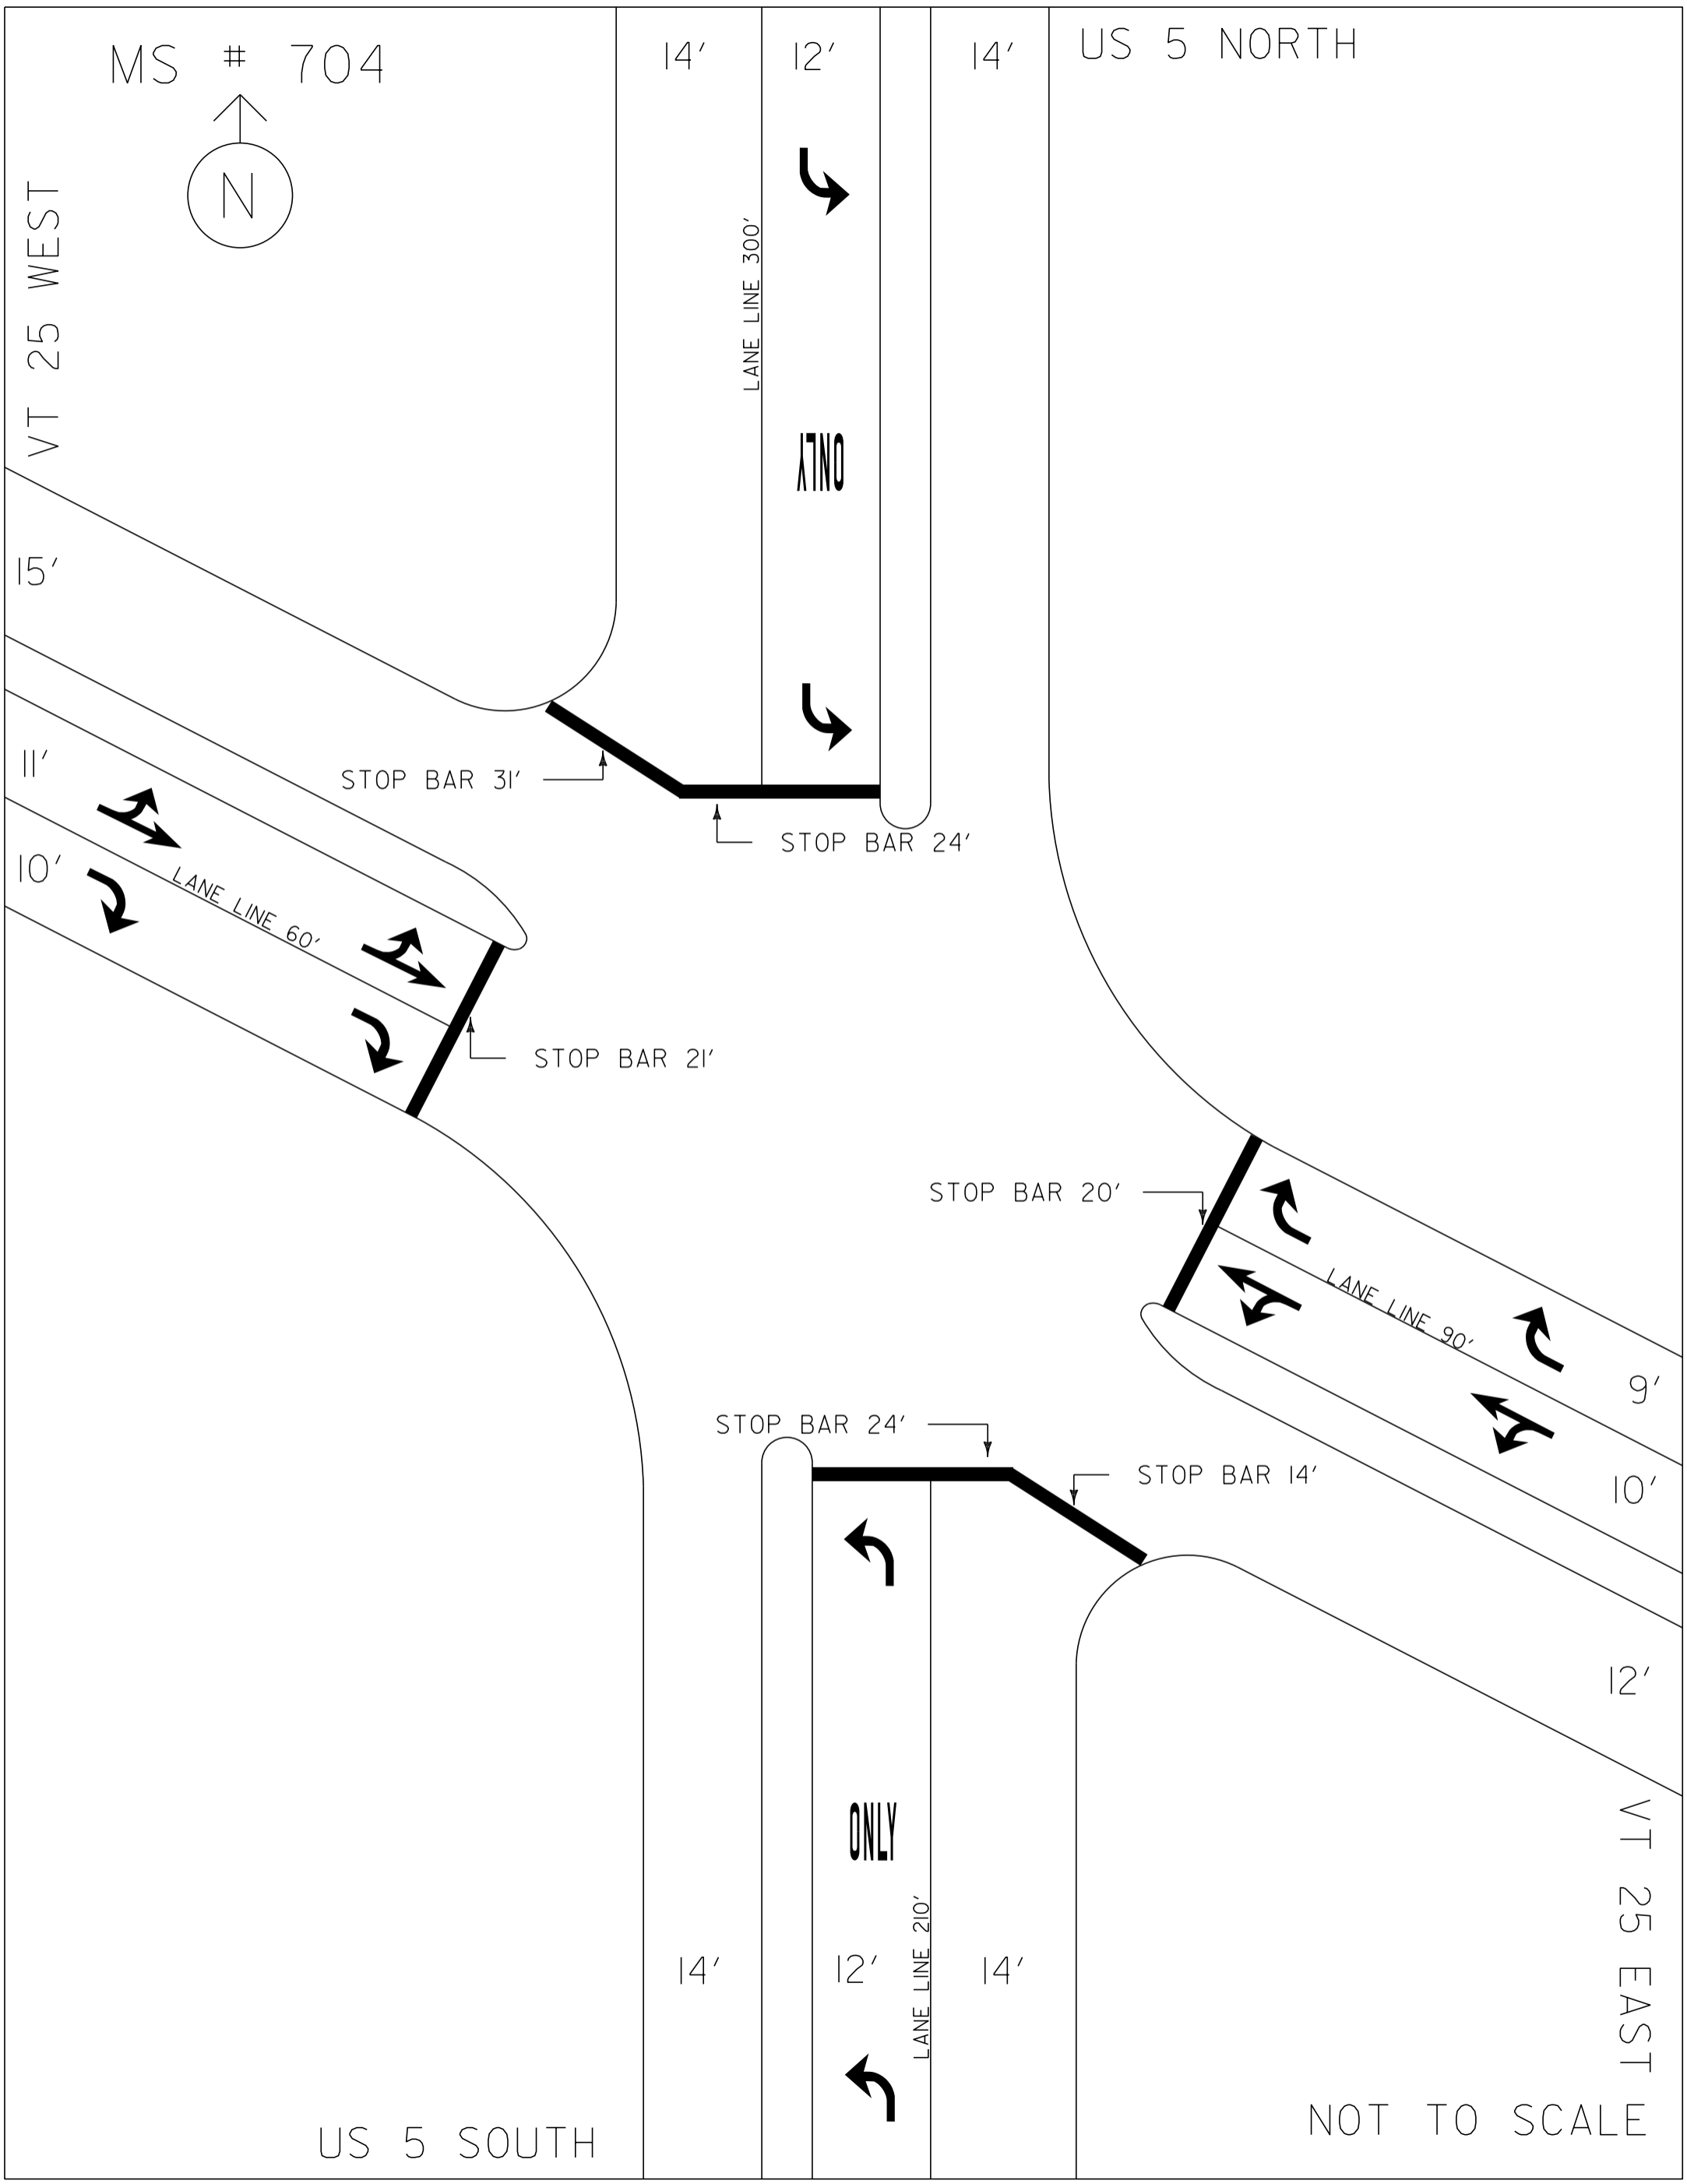

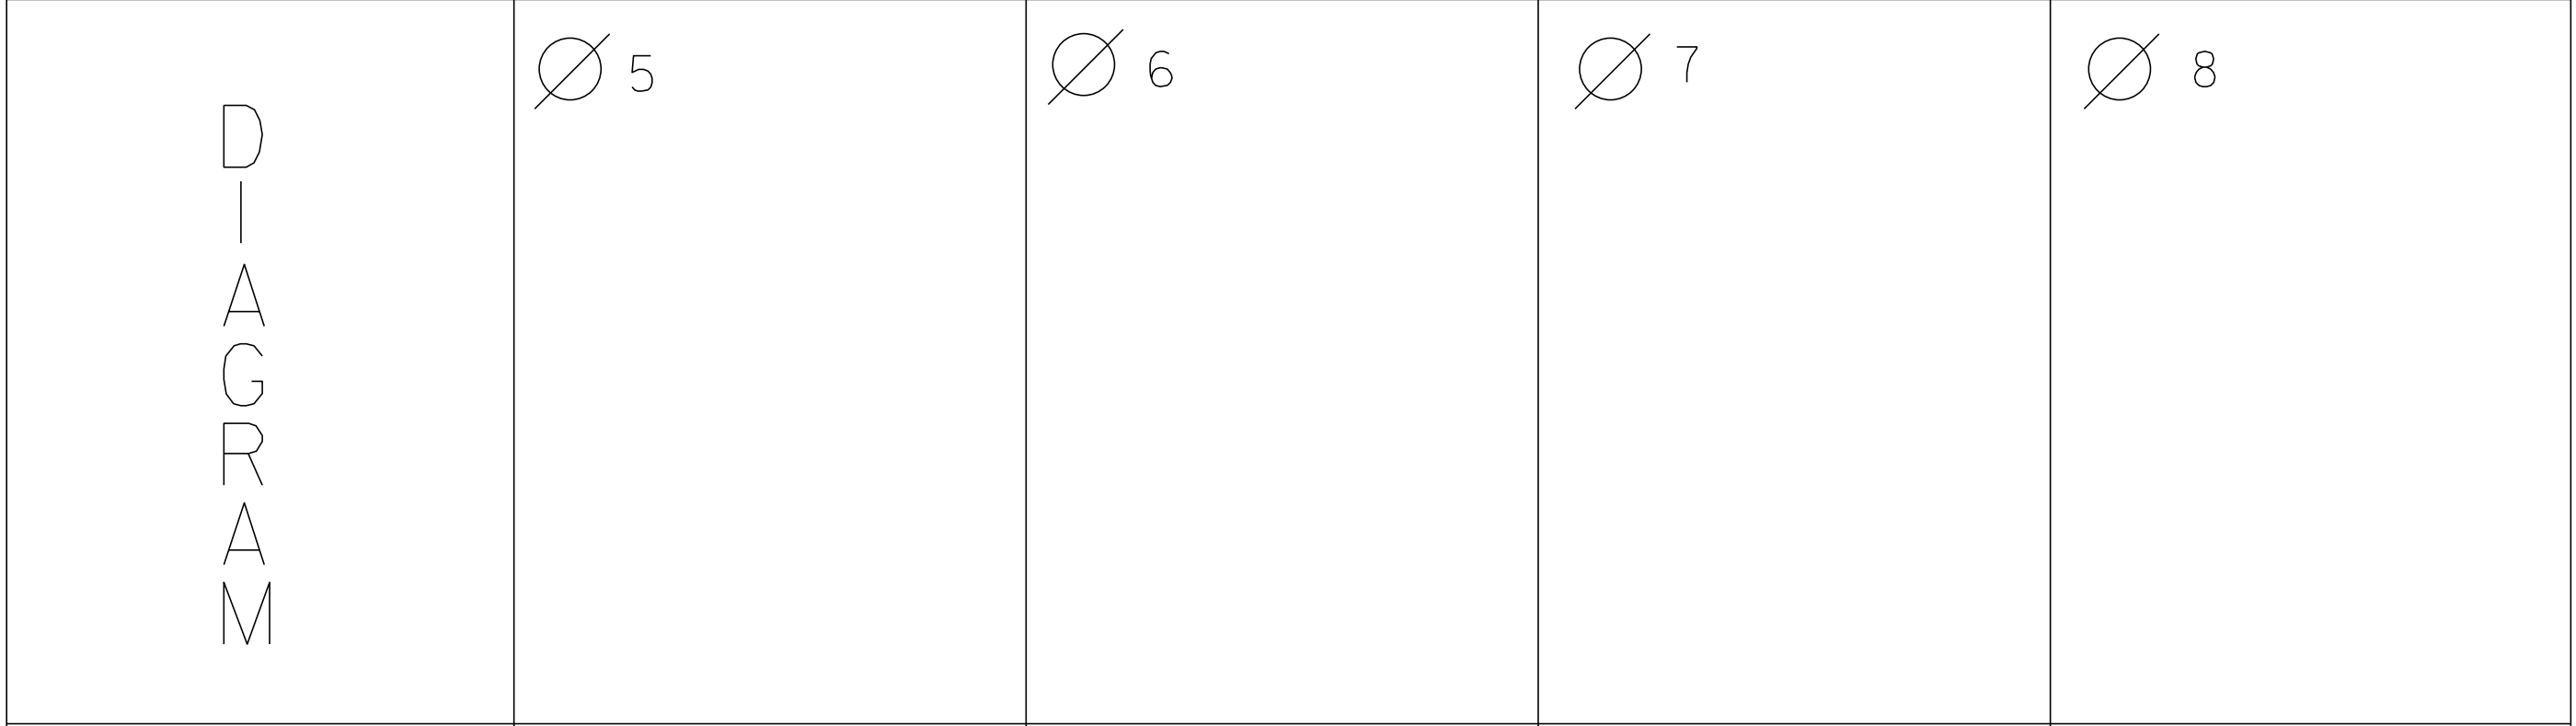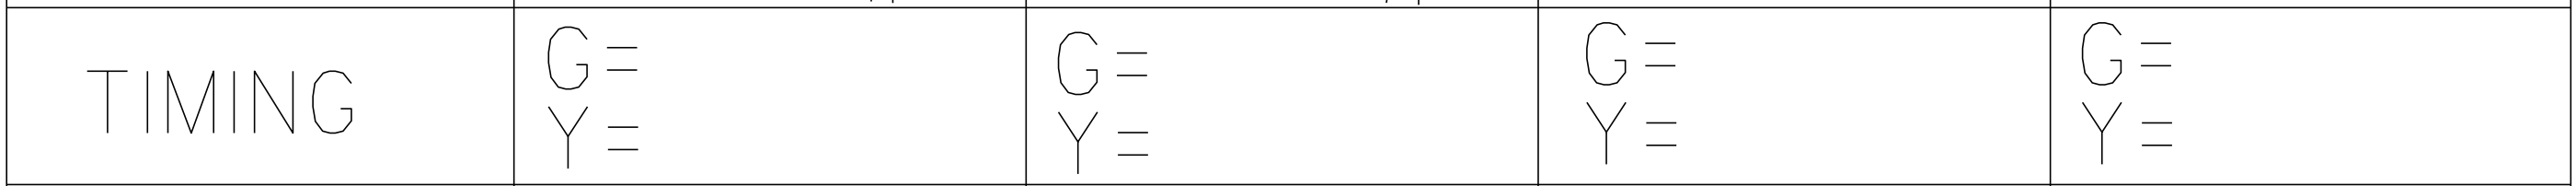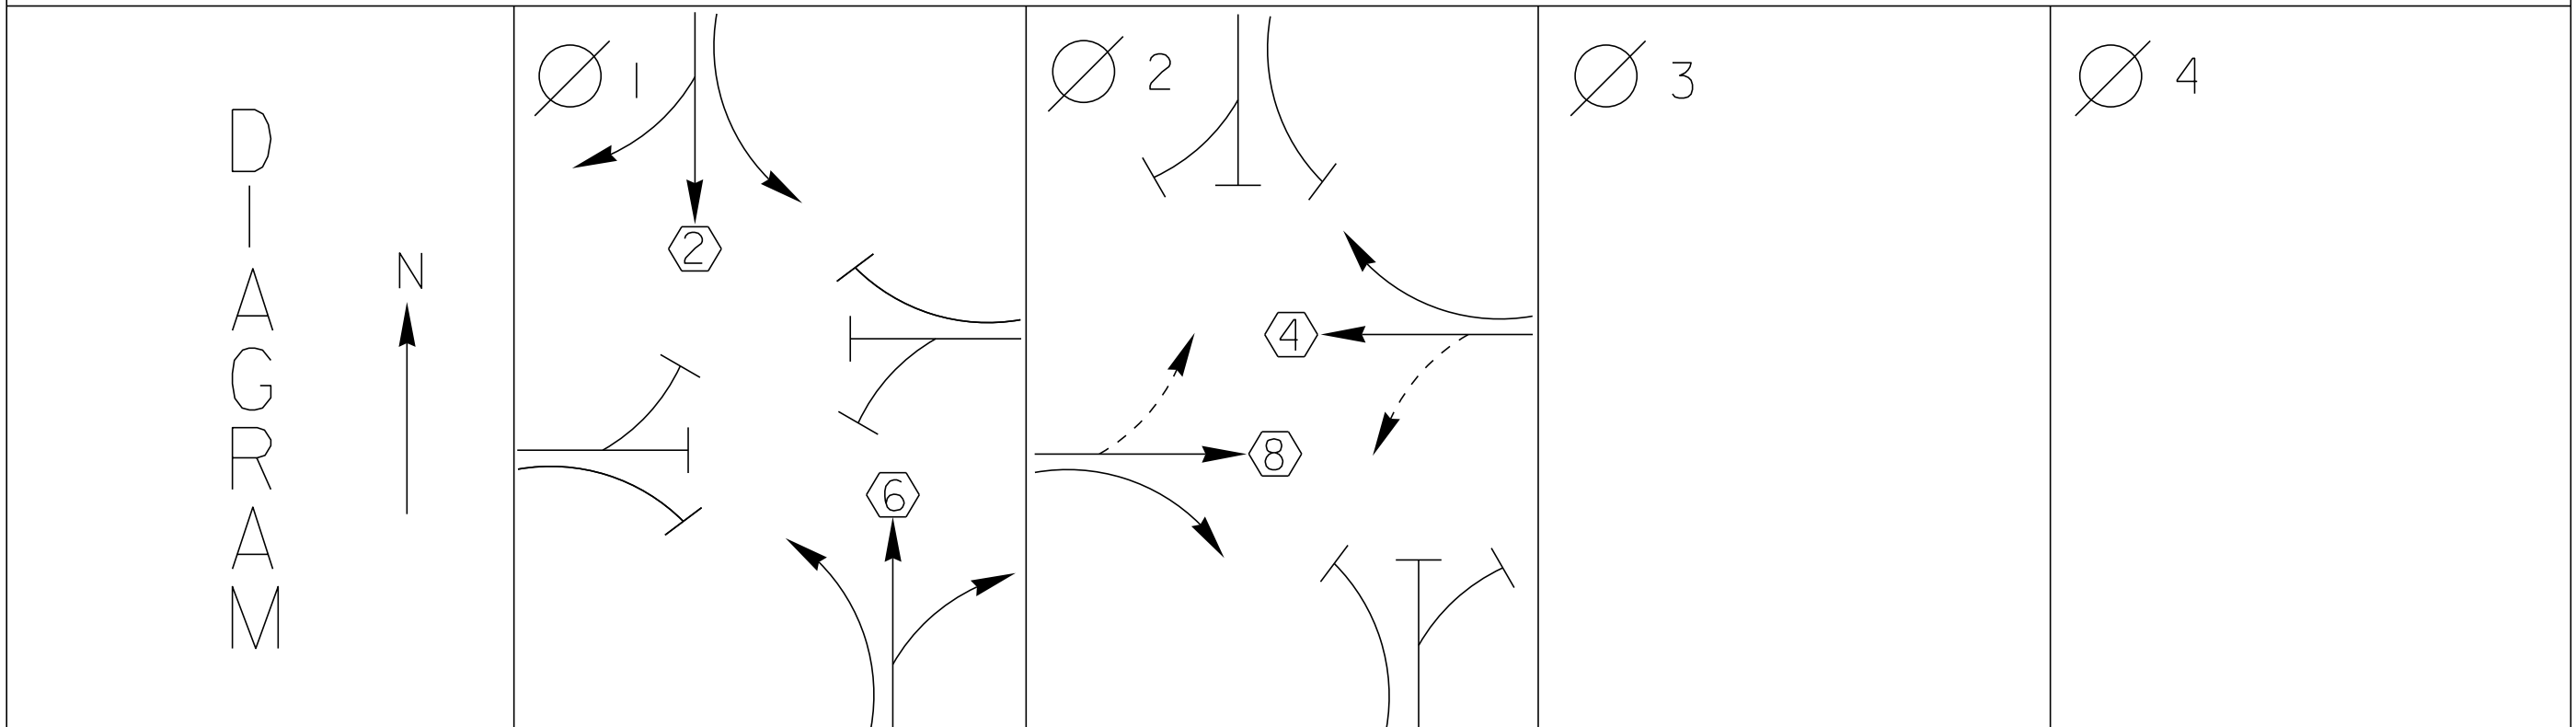



DANGER

115 VOLTS A.C.

WARNING

DO NOT OPERATE
CABINET WITHOUT
CONFLICT MONITOR UNIT


VEH TEST SW'S



AUTO S I O	AUTO OFF	CONT ON	#1A	#2B	#3C	#4D
FLASH	FLASH	OFF	#5	#6	#7	#8
OUTLET FUSE 15A	CABINET LIGHT ON	CABINET LIGHT OFF	#1A	#2B	#3C	#4D
	OFF	OFF	#5	#6	#7	#8


PEV TEST SW'S


#1A	#2B	#3C	#4D
#5	#6	#7	#8

1697-92-S

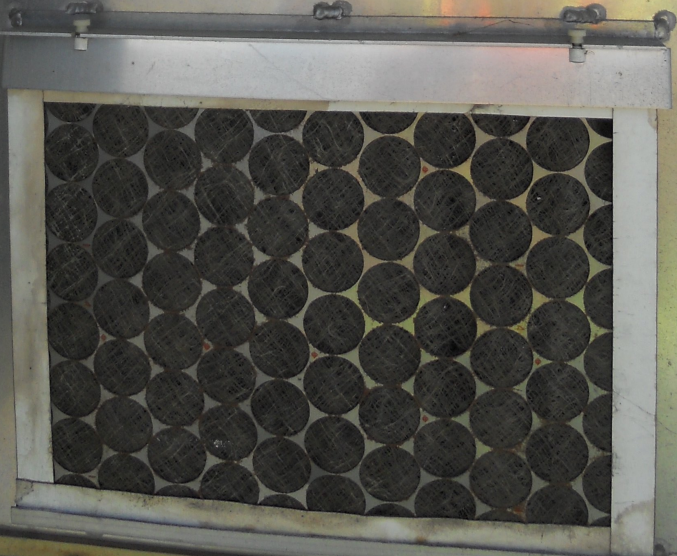


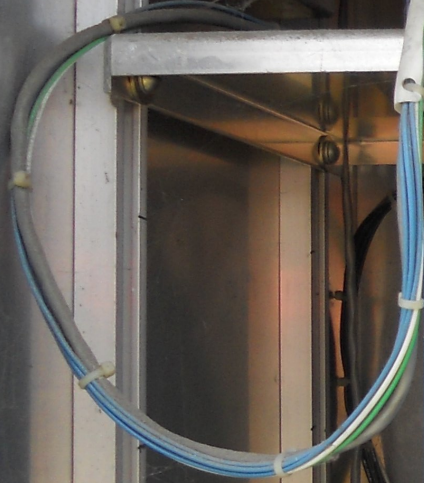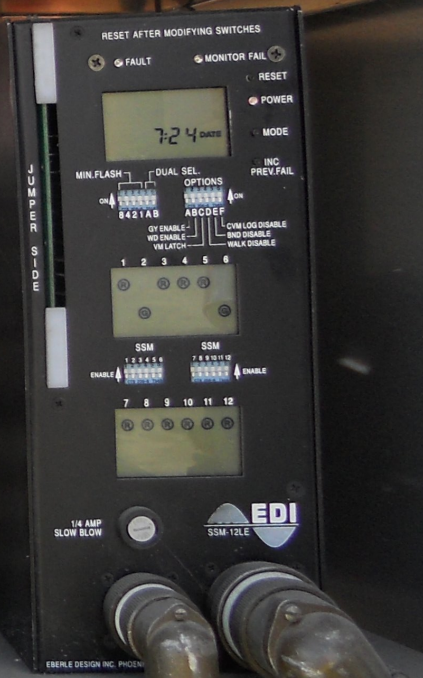

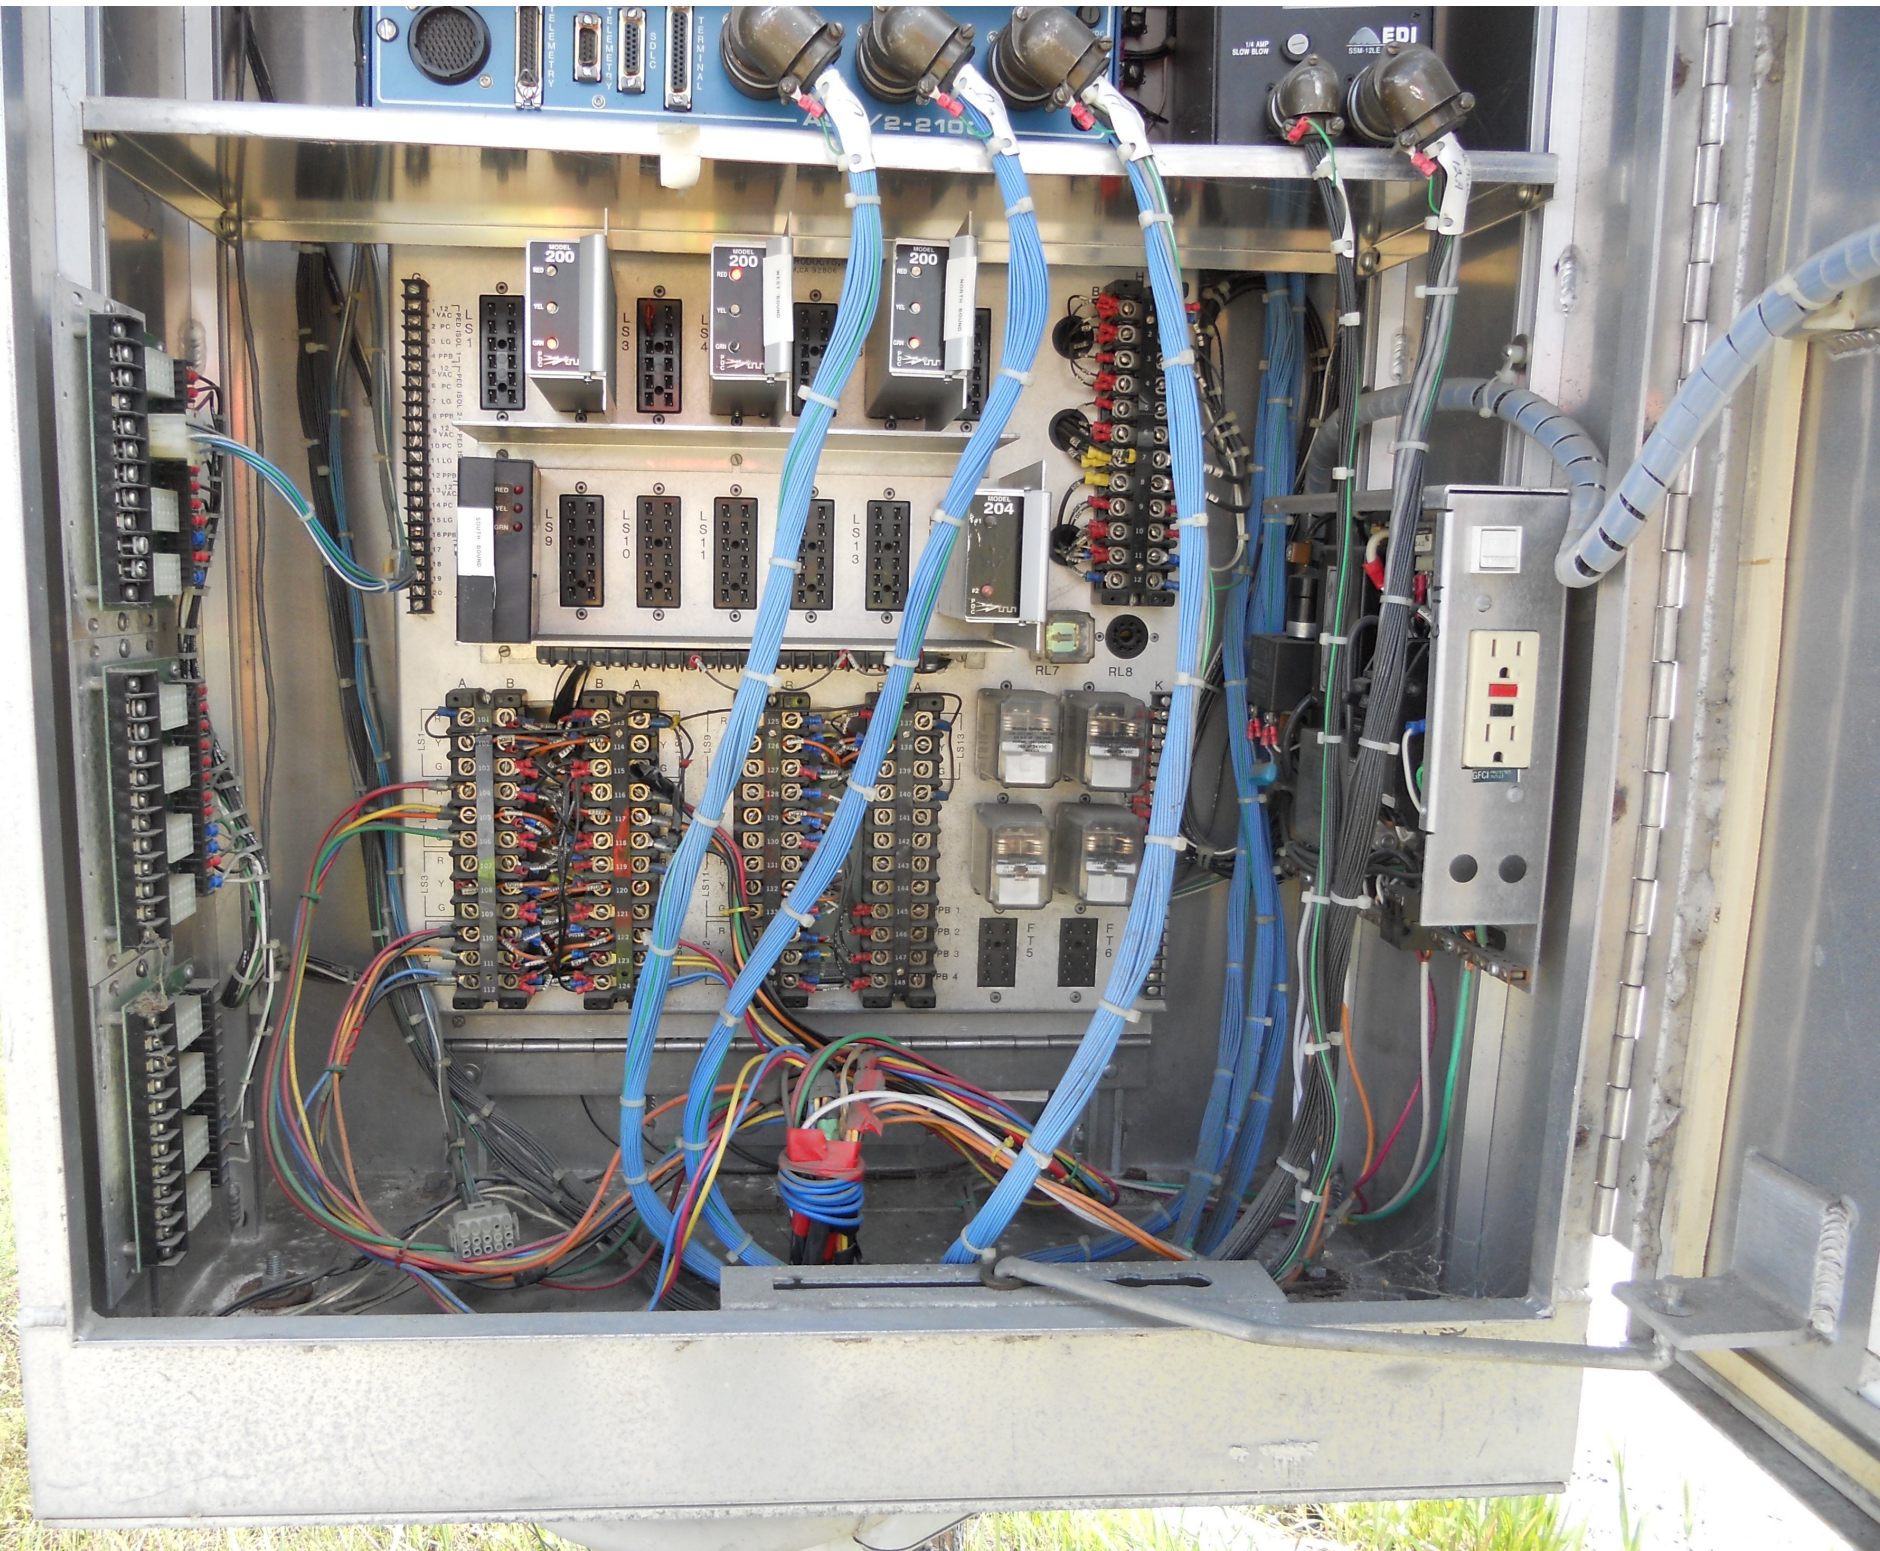

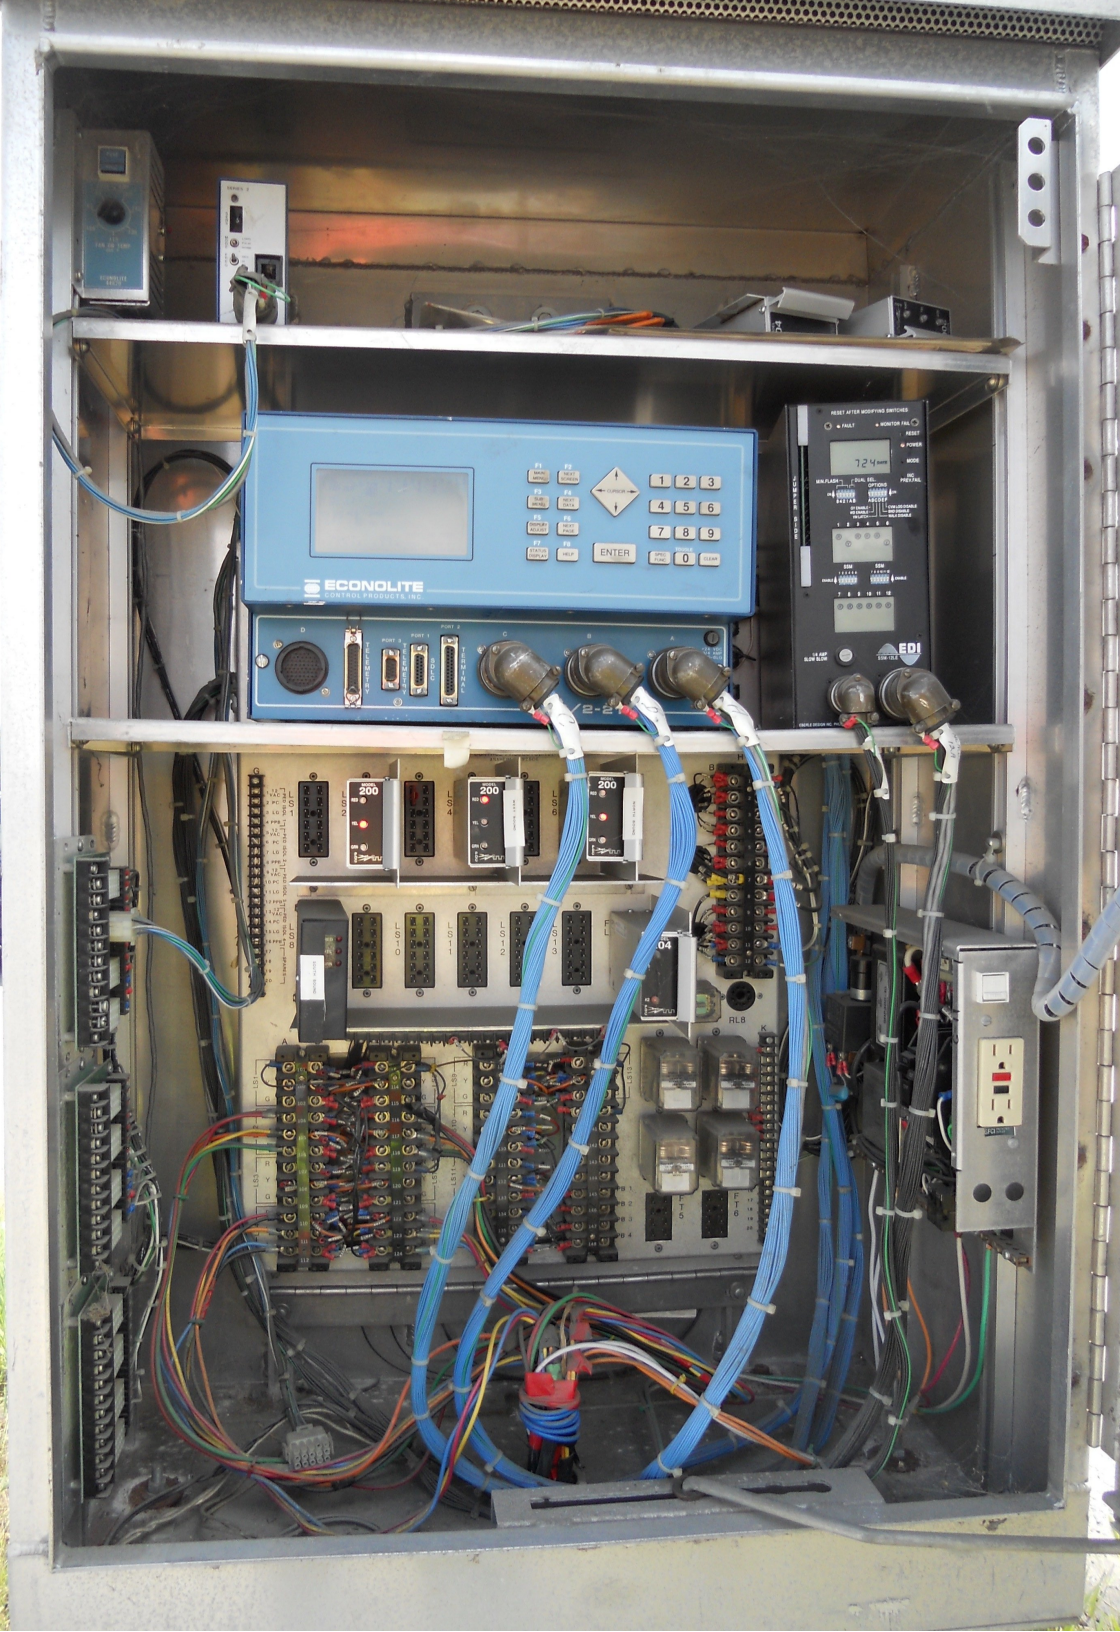

WARNING OF ELECTRICAL SHOCK OR BURN SERVICE BY UTILITY AUTHORIZED PERSONNEL ONLY NOT FOR: OVER CURRENT PROTECTION

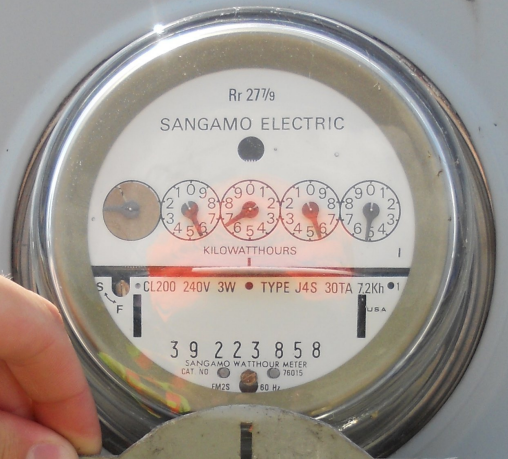



LEFT TURN ONLY

RIGHT TURN ONLY

TUESDAY
LADIES NIGHT
HALF OFF
SPECIALS
\$2 BUD LIGHT
BUD LIGHT

Mobil

JIFFY



SOUTH TO
5 INTERSTATE 91
↑ →
SOUTH NORTH
VERMONT VERMONT
25 25
← →

Traffic light signals showing red and yellow lights.

White sedan driving away from the camera.

Dark sedan driving in the adjacent lane.

Guardrail along the right side of the road.



LEFT TURN
YIELD
ON GREEN

LEFT TURN
YIELD
ON GREEN



SOUTH
5

WYOMING

Winney
PHARMACY
DRIVE THRU PHARMACY
PHOTO CENTER

MYERS





CONTINUE
YIELD
TO TRUCKS



LOWER PLAN
WATTS RIVER RD





LEFT TURN
YIELD
ON GREEN

ROAD
WORK
AHEAD

SPEED
LIMIT
40





Winney
PHARMACY
DINE THRU PHARMACY
PHOTO CENTER

12¢

5
5
5



TO	NORTH
INTERSTATE	
91	5
←	↑
NORTH	SOUTH
VERMONT	VERMONT
25	25
←	→

Traffic lights showing green for the main road.

Yellow diamond warning sign.

White square sign with a 'V' logo.

Commercial buildings and a blue canopy tent on the right side of the intersection.

Gas station and other commercial buildings on the left side of the intersection.



LEFT TURN
YIELD
ON GREEN



SPEED
LIMIT
40

J.M. Landscaping

5



NORTH TO
VERMONT INTERSTATE
25 91
↑ ↑
SOUTH NORTH
5 5
← →





↑
← ONLY →

VALLEY FLOORS

40





LEFT TURN
YIELD
ON GREEN

Valley Floors
Sales and installation
of all types of flooring
CASH & CARRY WAREHOUSE SALE
LAMINATE W/ PAD \$1.50 S.F.
PORCELAIN TILE \$2.75 S.F.
WAREHOUSE BARGAINS
KERRON & BONE HARDWARE

?



LEFT TURN
YIELD
ON GREEN

LEFT TURN
YIELD
ON GREEN

DIESEL

NORTH TO
25 91

NO PARKING

363
377
391







A wooden utility pole stands vertically against a blue sky with scattered white clouds. Two green street signs are mounted on the pole. The top sign is tilted slightly upwards and to the right, displaying the text 'LOWER PLAIN' in white, bold, sans-serif capital letters. The bottom sign is horizontal and displays the text 'WAITS RIVER RD' in white, bold, sans-serif capital letters. The pole is made of weathered wood and has a metal bracket with several holes visible at the base of the signs.

LOWER PLAIN

WAITS RIVER RD





LOWER PLAN
WAITS RIVER RD

↑

PHARMACY
FOOD MART
PHOTO CENTER

LEFT TURN
YIELD
ON GREEN

Yellow diamond warning sign

White arrow sign pointing up and right

Orange diamond warning sign

Blue canopy

Several cars stopped at the intersection

Small sign on the right side of the road



NIC Program Steps

Step	Program	Step Begins	Pattern	Override
------	---------	-------------	---------	----------

TOD Program Steps

Step 1 Program 1 Step Begins 0600

Flash. Dimming Enable.
Red Rest Alt Veh Extension
Spare 5. Det Log Enable.
Spare 3. Spare 4
Type 0 Dly Enable. . . Spare 2
Det Diag Plan. . . . 0

Table with 12 columns for Phase Number (1-12) and rows for Max 2 Enable, Max 3 Enable, Veh Recall, Veh Max Recall, Ped Recall, Cond Service Inhibit, Phase Omit, and Special Function.

Alt Sequence A B C D E F

Step 2 Program 1 Step Begins 2200

Flash. X Dimming Enable.
Red Rest Alt Veh Extension
Spare 5. Det Log Enable.
Spare 3. Spare 4
Type 0 Dly Enable. . . Spare 2
Det Diag Plan. . . . 0

Table with 12 columns for Phase Number (1-12) and rows for Max 2 Enable, Max 3 Enable, Veh Recall, Veh Max Recall, Ped Recall, Cond Service Inhibit, Phase Omit, and Special Function.

Alt Sequence A B C D E F