TABLE OF APPROXIMATE DISTANCES IN VERMONT

To find distances between points listed in the table (as from Barre to Montpelier), find the first in alphabetical order (Barre) in the list and follow the vertical column to an intersection with the horizontal line from the second point (Montpelier) in the list (7 miles).

★★★★★

Alburg, Barre, Barton, Bellows Falls, Bennington, Bethel, Bradford, Brandon, Brattleboro, Bristol, Burlington, Canaan, Champlain Bridge, Chester, Derby Line, Dorset, Enosburg Falls, Essex Jct., Fair Haven, Hardwick, Island Pond, Ludlow, Lyndonville, Manchester, Middlebury, Montpelier, Morrisville, Newport, Northfield, North Troy, Norton, Plymouth, Poultney, Randolph, Richford, Rutland, St. Albans, St. Johnsbury, Springfield, Stowe, Swanton, Townshend, Vergennes, Wallingford, Waterbury, Wells River, White River Jct., Wilmington, Woodstock, Windsor

Compiled by the Department of Highways, Montpelier, Vt., April, 1937.

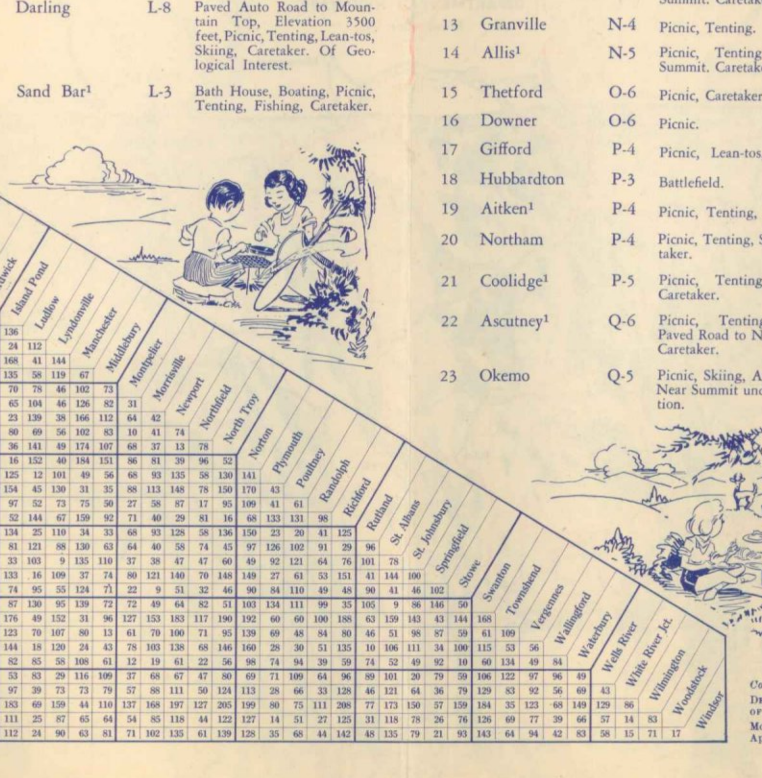

VERMONT STATE FORESTS, PARKS AND CAMPGROUNDS

No.	Forest or Park	Location	Facilities
1	Maidstone†	L-9	Picnic, Hiking, Fishing, Caretaker.
2	Willoughby[1]	L-7	Picnic and Tenting.
3	Crystal*	L-7	Bath House.
4	Bellevue Hill	K-3	Picnic, Caretaker.
5	St. Albans Bay	K-3	Bath House, Caretaker.
6	Darling	L-8	Paved Auto Road to Mountain Top, Elevation 3500 feet, Picnic, Tenting, Lean-tos, Skiing, Caretaker. Of Geological Interest.
7	Sand Bar[1]	L-3	Bath House, Boating, Picnic, Tenting, Fishing, Caretaker.
8	Elmore	L-5	Bath House, Boating, Fishing, Picnic, Caretaker.
9	Mt. Mansfield Smugglers Notch	L-4	Picnic, Skiing, Tenting, Lean-tos, Hiking, Road to Mountain Top, Caretaker.
10	Mt. Mansfield Underhill	L-4	Picnic, Camping, Lean-tos, Skiing, Hiking, Caretaker.
11	Groton[1]	M-7	Five areas. Tenting, Picnic, Swimming, Fishing, Hiking, Skiing, Caretaker.
12	Mt. Philo	M-3	Tenting, Picnic. Road to Summit. Caretaker.
13	Granville	N-4	Picnic, Tenting.
14	Allis[1]	N-5	Picnic, Tenting. Road to Summit. Caretaker.
15	Thetford	O-6	Picnic, Caretaker.
16	Downer	O-6	Picnic.
17	Gifford	P-4	Picnic, Lean-tos, Caretaker.
18	Hubbardton	P-3	Battlefield.
19	Aitken[1]	P-4	Picnic, Tenting, Caretaker.
20	Northam	P-4	Picnic, Tenting, Skiing, Caretaker.
21	Coolidge[1]	P-5	Picnic, Tenting, Lean-tos, Caretaker.
22	Ascutney[1]	Q-6	Picnic, Tenting, Hiking, Paved Road to Near Summit, Caretaker.
23	Okemo	Q-5	Picnic, Skiing, Auto Road to Near Summit under construction.
24	Proctor Piper[1]	Q-5	Picnic, Tenting, Caretaker.
25	Wilgus	Q-6	Picnic, Caretaker.
26	Grafton	R-5	Picnic, Tenting, Caretaker.
27	Jamaica	R-4	Undeveloped, Picnic, Bathing.
28	Townshend[1]	R-5	Picnic, Tenting, Skiing, Caretaker.
29	Dutton Pines	S-5	Picnic, Caretaker.

† Under construction 1941.
* To be ready in 1941.
[1] Trailer site.

All areas have fireplaces, spring water, tables and sanitary facilities. For further information or for State Forest and Park Folder, write Perry H. Merrill, State Forester, Montpelier, Vermont.

GREEN MOUNTAIN NATIONAL FOREST

No.		Location	Facilities
30	Hapgood Pond	Q-4	Swimming, Camping, Picnicking, Nature Trail, Caretaker and Life Guards.
31	White Rocks	Q-4	Picnicking, Nature Trail to Lookoff point. Interesting to Geologist and Botanist.
32	Texas Falls	O-4	Picnicking, Improved Nature Trail to vantage point for view of Falls and Gorge.
33	Greendale[1]	Q-4	Picnicking, Camping.
34	Bromley Mtn.	R-4	Winter Sports Area. 11 miles of down mountain runs.

VERMONT OFFICIAL TOURIST INFORMATION BOOTHS, 1941

Bennington	St. Johnsbury
Rutland	Barre
Vergennes	Montpelier
Burlington	Wells River
Colchester	White River Junction
Newport	Brattleboro

FISH AND GAME

Fish—Open Seasons

Trout—Brook, Brown, Lock Leven, Steelhead, Grayling, Black Spotted and Rainbow—May 1 to Aug. 15. Golden Trout, Lake Trout and Land-Locked Salmon—May 1 to Sept. 1. Pike Perch—May 1 to Mar. 15. Bass—July 1 to Dec. 1. Note: See General Laws for exceptions to the above applying to: Peacham Pond and Harvey's Lake in Caledonia County; Forest Lake, Big Averill Lake, Little Averill Lake and Back Pond in Essex County; Willoughby Lake, Lake Memphremagog, Seymour Lake, Echo Lake, Shadow Lake and Parker Pond in Orleans County; Chittenden Lake in Rutland County; and Lake Champlain.

Legal Lengths and Daily Limits

Trout—Brook, Brown, Lock Leven, Golden, Steelhead (see exceptions on Barton and Willoughby Rivers), Rainbow, Grayling and Black Spotted—not less than 6 inches in length; not more than 20 fish, nor more than 5 pounds. Lake Trout and Land-Locked Salmon—not less than 15 inches; limit 2 fish either trout or salmon or one of each. Black Bass—not less than 10 inches in length, and not more than 5 fish (7 fish in Lake Champlain). Pickerel—not less than 12 inches in length. Pike Perch—not less than 12 inches in length—not more than 25 pounds. (For exceptions see General Laws.)

Game—Open Season

When Lawful to Take Same

Deer, one deer with horns not less than three inches long, between November 21st and November 30th, both dates inclusive, excepting Sundays.

Rabbits or Hares..........Oct. 1-March 1
Gray Squirrels..........Oct. 1-Nov. 1
Moose, Caribou and Elk, protected at all times. Cottontail Rabbits, not protected.

(See General Laws for exception in Chittenden County on rabbits.)

Game Birds—Open Season

Ruffed Grouse (Partridge)—Oct. 1-Oct. 30. Woodcock and Ducks as regulated by the Bureau of Biological Survey. Pheasants—Wednesday and Saturday during month of October, 2 Cock Birds per day, 4 for season.

License Fees

Resident Fishing—$1.25. Resident Hunting—$1.25.
Resident Combination Hunting and Fishing—$2.00.
Non-Resident Fishing—
Season.............. $5.15
14 Days.............. 2.35
3 Days.............. 1.65
Non-Resident Hunting—$12.50.
Non-Resident Combination Hunting and Fishing—$15.50.
Resident Trapping—$1.25. Non-Resident Trapping—$50.00.

For all exceptions to the above General Laws, see Fish and Game Pamphlet, copy of which will be delivered by Town Clerk when license is obtained, or sent upon request by addressing Fish and Game Service, Montpelier, Vermont.

GOLF COURSES IN VERMONT

18-Hole Golf Courses

Name	Location
Burlington Country Club	Burlington
Lake Morey Inn	Fairlee
Ekwanok Country Club	Manchester
Equinox Links Club	Manchester
Rutland Country Club	Rutland
Woodstock Country Club	Woodstock

9-Hole Golf Courses

Name	Location
Barre Country Club	Barre
Midway Golf Course	Barre
Barton Country Club	Barton
Vergennes Golf Club	Basin Harbor
Bellows Falls Country Club	Bellows Falls
Mt. Anthony Country Club	Bennington
Bradford Golf Club	Bradford
Brandon Country Club	Brandon
Brattleboro Country Club	Brattleboro
Bristol Country Club	Bristol
New Waubanakee Golf Club	Burlington
Kingsbery Golf Club	Derby
Dorset Field Club	Dorset
Hampton Golf Club	Fair Haven
Mountain View Country Club	Greensboro
Hardwick Country Club	Hardwick
Lamoille Country Club	Hyde Park
Lake Bomoseen Country Club	Lake Bomoseen
The Lyndon Golf Club	Lyndonville
Lake Champlain Golf Club	Mallett's Bay
Middlebury Country Club	Middlebury
Montpelier Country Club	Montpelier
National Life Course	Montpelier
Newport Country Club	Newport
Northfield Country Club	Northfield
Orleans Country Club	Orleans
Proctor-Pittsford Country Club	Pittsford
Lake St. Catherine Country Club	Poultney
Montague Golf Club	Randolph
Richford Country Club	Richford
Champlain Country Club	St. Albans
St. Johnsbury Country Club	St. Johnsbury
Hyde Manor Golf Club	Sudbury
Waterbury Inn Golf Course	Waterbury
Wells-Wood Golf Club	Wells River
Williston Country Club	Williston
Wilmington Country Club	Wilmington
Windsor Country Club	Windsor

GREEN MOUNTAIN HORSE ASSOCIATION BRIDLE PATHS

The roads used for these so-called "Bridle Paths" are the dirt roads which run throughout the entire State, generally higher in the hills than the main motor roads. They are soft surfaced, shady, always beautiful and very seldom used by motor cars. At present there are over 1,000 miles of these roads marked, with stops arranged every ten to twenty miles for the riders' convenience for luncheon or over night.

One can generally count on the bridle paths being in good condition from May 1st to November 1st, and in some places for a longer season. The Association marks the routes with arrows, with the letters "G. Mt. H. A.," and issues a guide book giving the names of farm houses, inns and hotels where riders and horses will find comfortable quarters. Anyone may become a member of the Association upon payment of the dues of $2.00 a year. The guide book, maps and all necessary information as to condition of routes, expenses of a trip, rental of horses, lodgings, equipment, etc., will be supplied by the Green Mountain Horse Association, Rutland, Vermont.

The Publicity Service, Department of Conservation and Development, desires to be of help to all persons interested in Vermont and will gladly give information regarding hotels, boarding places, locations for summer homes, tours, recreational attractions and opportunities for hunting and fishing.

The following publications will be furnished: "Vermont Hunting and Fishing"; "Vermont Tours"; Directory of Hotels, Tourist Homes and Cabins; "Vermont Farms and Summer Homes for Sale"; "Cottages, Camps and Furnished Homes for Rent" with a list of boys' and girls' camps; folder, "Unspoiled Vermont." Special requests for information not contained in the foregoing are welcomed and will be answered as fully as possible. Address inquiries to

Vermont Publicity Service
Department of Conservation and Development
State House
Montpelier, Vermont

VISIT THE LONG TRAIL

From one end of Vermont to the other the Long Trail follows the sky-line of a two hundred mile mountain range, dipping into valleys, climbing over summits, passing through magnificent forests, sometimes skirting lakes. In all of the United States there is no foot-path like this. **You Can Visit the Trail or one of the Beautiful Summits in a Single Day's Trip from Various Convenient Points.**

On either side of the mountain range approach trails lead up to the Long Trail from nearby motor highways. In addition there are highways that cross the Trail itself.

HEALTH CONDITIONS IN VERMONT

All places offering lodging and meals must pass inspection by State Department of Public Health.

Vermont is justly known as a healthy state, and for years has maintained its position as a leader in the control of communicable diseases. Typhoid fever is almost unknown in this state, a result which has been accomplished by close supervision of the State Department of Public Health over all public water supplies, sewage disposal and other possible means of infection. Boys' and girls' camps are visited frequently by an experienced sanitary engineer, and camp owners make constant use of the facilities of the Department whenever sanitary or disease problems arise.

Besides the sanitary engineering division, the Department maintains active divisions of laboratory, communicable diseases, tuberculosis, infantile paralysis and public health nursing, all of which are at the service of tourists, campers and visitors, receiving attention either directly at the headquarters at Burlington, or through local health officers in the cities or towns.

INDEX AND POPULATION

Note: The letters and figures after names (as E-7) denote the square on the map in which the town is located, as indicated by the corresponding figures in the border.
Light face figures indicate population of the entire township. Black face figures indicate population of village only. Figures marked thus (*) are estimated for unincorporated villages. All others are latest U. S. Government Census figures.
Places marked thus † are not post office village points, but the names of townships, and will not be found on this map unless there is a village or post office bearing that name.

VERMONT

Counties

Addison N-3
Bennington R-3
Caledonia M-7
Chittenden M-3
Essex L-9
Franklin K-4
Grand Isle L-2
Lamoille L-5
Orange O-6
Orleans K-7
Rutland P-3
Washington N-5
Windham S-4
Windsor Q-5

Cities and Towns

Adamant, M-6...100*
Addison†, N-2...586
Albany, L-6...200
Alburg, K-2...638
Andover, Q-5...213
Arlington, R-3...1,418
Ascutney, Q-6...170*
Athens†, R-5...136
Averill, K-9...12
Bakersfield, K-4...827
Baltimore†, Q-5...85
Barnard, P-5...486
Barnet, M-7...1,596
Barre, N-6...10,909
Barton, L-7...1,262
Bartonsville, R-5...75*
Beebe Plain, K-7...185*
Beecher Falls, K-9...330*
Bellows Falls, R-6...4,236
Belmont, Q-4...171*
Belvidere Center, L-5...120*
Bennington, S-3...7,628
Benson, P-2...572
Benson Landing, P-2
Berkshire, K-4...1,156
Berlin†, N-5...1,111
Bethel, O-5...1,477
Bloomfield†, K-9...326
Bolton, M-4...287
Boltonville, N-7...105*
Bomoseen, P-3...125*
Bondville, R-4...95*
Bradford, O-7...693
Braintree, O-5...648
Brandon, O-3...2,979
Brattleboro, S-5...9,622
Bread Loaf, O-4
Bridgewater, P-5...895
Bridgewater Corners, P-5...155*
Bridport, O-2...665
Brighton†, K-8...1,754
Bristol, N-3...1,236
Brookfield, N-5...808
Brookline†, R-5...104
Browningtont†, K-7...689
Brownsville, Q-6...176*
Brunswick†, L-9...86
Burke, L-8...998
Burlington, M-3...27,686
Cabot, M-6...265
Calais, M-6...818
Cambridge, L-4...217
Cambridge Jct., L-4...110*
Cambridgeport, R-5...45*
Canaan, K-9...872
Castleton, P-3...1,601
Cavendish, Q-5...1,398
Cedar Beach, M-2
Center Rutland, P-3...448*
Charleston†, K-7-8...834
Charlotte, M-2-3...1,082
Chelsea, O-6...1,013
Chester, Q-5...749
Chester Depot, Q-5...320*
Chimney Point, N-2
Chittenden, P-4...379
Clarendon, P-4...868
Colchester, L-3...3,031
Concord, M-8...313
Corinth, N-6...822
Cornwall†, O-3...670
Coventry, K-6-7...549
Craftsbury, L-6...875
Craftsbury Common, L-6...125*
Cuttingsville, Q-4...195*
Danby, Q-3-4...1,112
Danville, M-7...1,472
Derby, K-7...346
Derby Line, K-7...661
Dorset, Q-3...1,128
Dover†, S-4...244
Dummerston†, S-5...615
Dummerston Sta., S-5
Duxbury†, M-4...554
East Arlington, R-3...220*
East Barnet, M-7...89*
East Barre, N-6...545*
East Berkshire, K-5...268*
East Bethel, O-5...70*
East Brookfield, N-5...112*
East Burke, L-8...98*
East Calais, M-6...144*
East Charleston, K-8...196*
East Clarendon, P-4...88*
East Concord, M-8...77*
East Corinth, N-7...238*
East Craftsbury, L-6...72*
East Dorset, R-3...208*
East Dover, S-4...76*
East Dummerston, S-5...68*
East Fairfield, K-4...428*
East Franklin, K-4...74*
East Georgia, L-3...94*
East Granville, N-4...56*
East Hardwick, L-6...192*
East Haven, L-8...92
East Highgate, K-4...156*
East Jamaica, R-5...42*
East Middlebury, O-3...116*
East Montpelier, M-6...1,025
East Peacham, M-7...58*
East Poultney, P-3...166*
East Randolph, O-5...184*
East Richford, K-5...85*
East Ryegate, N-7...82*
East Shoreham, O-2...46*
East Thetford, O-7...94
East Wallingford, Q-4...172*
Eden, L-5...498
Eden Mills, L-5-6...134*
Elmore, L-5...300
Ely, O-7...66*
Enosburg Falls, K-4...1,168
Essex, L-3...3,059
Essex Junction, M-3...1,901
Fairfax, L-3...1,229
Fairfield, K-4...1,444
Fair Haven, P-2...1,968
Fairlee, O-7...535
Fayston†, M-4...284
Ferdinand†, L-8-9...17
Ferrisburg, N-3...1,347
Fletcher†, L-4...549
Florence, P-3...80*
Forest Dale, O-3...216*
Fort Ethan Allen, M-3...950*
Franklin, K-4...1,021
Gassetts, Q-5...78*
Gaysville, O-5...94*
Georgia†, L-3...1,008
Gilman, M-9...278*
Glastenbury†, S-3...4
Glover, L-7...216
Goshen†, O-3-4...83
Grafton, R-5...393
Granby, L-8...76
Grand Isle, L-2...791
Graniteville, N-6...835*
Granville, O-4...247
Green River, S-5...68*
Greensboro, L-6...768
Greensboro Bend, L-6...243*
Groton, N-7...419
Guildhall, L-9...313
Guilford†, S-5...686
Halifax, S-5...353
Hancock, O-4...371
Hardwick, M-6...1,607
Hartford, P-6...4,978
Hartland, P-6...1,306
Hartland Four Corners, P-6...115*
Healdville, Q-4...73*
Highgate, K-3...1,647
Highgate Center, K-3...204*
Highgate Springs, K-3...102*
Hinesburg, M-3...1,000
Holland†, K-7-8...533
Hubbardton, P-3...346
Huntington, M-4...549
Huntington Center, M-4...87*
Hyde Park, L-5...330
Hydeville, P-3...296*
Ira†, P-3...248
Irasburg, K-6...852
Island Pond, K-8...1,306*
Isle La Motte, K-2...335
Jacksonville, S-4...240
Jamaica, R-4...567
Jay†, K-6...230
Jeffersonville, L-4...287
Jericho, M-3-4...254
Jericho Center, M-4...77*
Johnson, L-5...753
Jonesville, M-4...95*
Kirby†, M-8...252
Lake, K-8
Lake Dunmore, O-3
Landgrove†, Q-R-4...64
Leicester Jct., O-3...126
Lemington†, K-9...131
Lewiston, P-6...67*
Lincoln, N-4...745
Londonderry, R-4...859
Lowell, K-6...615
Lower Cabot, M-6...111*
Lower Waterford, M-8...72*
Ludlow, Q-5...1,780
Lunenburg, M-9...1,374
Lyndon, L-M-7...3,144
Lyndon Center, L-7...283
Lyndonville, L-7...1,444
McIndoe Falls, M-7...155
Maidstone†, L-9...96
Manchester, R-3...325
Manchester Center, R-3...786*
Manchester Depot, R-3...277*
Marlboro, S-5...225
Marshfield, M-6...292
Mendon†, P-4...313
Middlebury, N-3...2,123
Middlesex, M-5...817
Middletown Springs, Q-3...493
Miles Pond, M-8...58*
Milton, L-3...729
Monkton, N-3...575
Montgomery, K-5...1,208
Montgomery Center, K-5...150*
Montpelier, M-5...8,006
Moretown, M-5...975
Morgan, K-7...335
Morgan Centre, K-8...83*
Morristown†, L-5...3,130
Morrisville, L-5...1,967
Morses Line, K-4...44*
Moscow, M-5...131*
Mount Holly, Q-4...656
Mount Mansfield, L-4
Mount Tabor†, Q-4...213
Newark†, L-8...242
Newbury, N-7...391
Newfane, S-5...160
New Haven, N-3...881
Newport, K-7...4,902
Newport Center, K-6...276*
North Bennington, S-3...992
North Calais, M-6...52*
North Clarendon, P-4...192*
North Concord, M-8...40*
North Derby, K-7
North Ferrisburg, M-3...307*
North Hartland, P-6...442
North Hero, K-2...198*
North Hyde Park, L-5...162*
North Montpelier, M-6...315*
North Pomfret, P-6...58*
North Pownal, S-2...198*
North Sheldon, K-4
North Springfield, Q-5...486*
North Thetford, O-7...64*
North Troy, K-6...1,077
North Westminster, (non P. O.) R-5-6
North Williston, M-3...400
Northfield, N-5...2,129
Northfield Falls, N-5...197*
Norton, K-8...314
Norwich, P-6...1,418
Old Bennington (non P. O.), S-3...169
Orange†, N-6...482
Orleans, K-7...1,332
Orwell, O-2...876
Panton†, N-2...312
Passumpsic, M-7...97*
Pawlet, Q-3...1,192
Peacham, M-7...543
Perkinsville, Q-5...144
Peru, R-4...142
Pittsfield, O-4...259
Pittsford, P-3...576
Pittsford Mills, P-3...112*
Plainfield, M-6...521
Plymouth, P-5...432
Plymouth Union, P-5...57*
Pomfret, P-5...686
Pompanoosuc, O-7...155*
Post Mills, O-6...128*
Poultney, P-3...1,333
Pownal, S-3...1,402
Proctor, P-3...2,184
Proctorsville, Q-5...643
Putnamville, M-5...54*
Putney, S-5...904
Quechee, P-6...141*
Randolph, O-5...1,988
Randolph Center, O-5...92*
Reading, Q-5...437
Readsboro, S-4...667
Richford, K-5...1,889
Richmond, M-4...692
Ricker Mills, N-7...41*
Ripton, O-3...231
Riverside, L-4...54*
Riverton, N-5...213*
Rochester, O-4...1,129
Rockingham†, R-5-6...5,737
Roxbury, N-5...554
Royalton, O-5...1,291
Rupert, Q-3...678
Rutland, P-4...17,082
Ryegate, N-7...1,105
St. Albans, K-3...8,037
St. Albans Bay, K-3...318*
St. George†, M-3...87
St. Johnsbury, M-7...7,437
St. Johnsbury Center, M-7...438*
St. Johnsbury East, M-8...101*
Salisbury, O-3...581
Sandgate†, R-3...187
Saxtons River, R-5...740
Searsburg†, S-4...135
Shaftsbury, R-3...1,577
Sharon, O-6...530
Sheffield, L-7...465
Shelburne, M-3...1,010
Sheldon, K-4...1,471
Sheldon Junction, K-4...81*
Sheldon Springs, K-4...146*
Sherburne Center, P-4...68*
Shoreham, O-2...865
Shoreham Ctr., O-2...71*
Shrewsbury†, P-4...537
Simonsville, Q-R-5...44*
Somerset†, S-4...5
South Barre, N-6...320*
South Burlington†, M-3...1,736
South Dorset, R-3...102*
South Hero, L-2...611
South Lincoln, N-4...42*
South Londonderry, R-4...281*
South Lunenburg, M-9...84*
South Newbury, N-7...112*
South Newfane, S-5...71*
South Peacham, M-7...40*
South Pomfret, P-5...82*
South Royalton, O-5...689*
South Ryegate, N-7...346
South Shaftsbury, S-3...340*
South Strafford, O-6
South Wallingford, Q-4...88*
South Wardsboro, R-4
South Windham, R-5...44*
South Woodbury, M-6...65*
South Woodstock, P-5...171*
Springfield, Q-6...5,182
Stamford†, S-3...418
Stannard†, L-7...140
Starksboro, N-3...744
Stockbridge, O-4...490
Stowe, M-5...540
Strafford, O-6...598
Stratton†, R-4...117
Sudbury, O-3...321
Sunderland†, R-3...442
Sutton, L-7...561
Swanton, K-3...1,461
Taftsville, P-6...93*
Thetford, O-7...1,043
Thetford Center, O-7...58*
Tinmouth†, Q-3...346
Topsham, N-7...707
Townshend, R-5...210
Troy, K-6...1,869
Tunbridge, O-6...882
Tyson, Q-5...69*
Underhill, L-4...760
Underhill Center, M-4...46*
Union Village, O-6...42*
Vergennes, N-3...1,662
Vernon, S-5...559
Vershire, O-6...367
Victory, M-8...104
Waitsfield, N-4...706
Waits River, N-6...84*
Walden, M-7...547
Walden Hts., M-7
Wallingford, Q-4...1,450
Waltham†, N-2-3...184
Wardsboro, R-4...401
Warren, N-4...450
Washington, N-6...730
Waterbury, M-5...3,074
Waterbury Center, M-5...208*
Waterford, M-8...498
Waterville, L-4...386
Weathersfield†, Q-6...1,075
Websterville, N-6...780*
Wells, Q-3...420
Wells River, N-7...527
West Barnet, M-7...131
West Berkshire, K-4...195*
West Bolton, M-4
West Brattleboro, S-5
West Bridgewater, P-5...58*
West Burke, L-8...316
West Charleston, K-7...218*
West Corinth, N-6...42*
West Danville, M-7...92*
West Dover, S-4...54*
West Dummerston, S-5...126*
West Fairlee, O-6...428
West Glover, L-7...68
West Halifax, S-4...53*
West Hartford, P-6...114*
West Haven†, P-2...302
West Lincoln, N-3...64*
West Newbury, N-7...56*
West Pawlet, Q-3...210*
West Rupert, R-3...98*
West Rutland, P-3...2,922
West Topsham, N-6...138*
West Townshend, R-5...83*
West Wardsboro, R-4...72*
West Windsor†, Q-5-6...494
West Woodstock, P-5...118*
Westfield, K-6...354
Westford, L-3...698
Westminster, R-6...270
Westminster Sta., R-6...95*
Westminster West, R-5...54*
Westmore†, K-L-7...224
Weston, Q-4...457
Weybridge†, N-3...385
Wheelock, L-7...293
White River Junction, P-6...2,784*
Whiting, O-3...312
Whitingham, S-4...789
Wilder, P-6...253*
Williamstown, N-5...1,477
Williamsville, S-5...107*
Williston, M-3...1,021
Willoughby, L-7...160*
Wilmington, S-4...597
Windham, R-5...183
Windsor, Q-6...3,402
Winhall†, R-4...212
Winooski, M-3...6,036
Wolcott, L-6...722
Woodbury, M-6...463
Woodford†, S-3...170
Woodstock, P-5...1,325
Worcester, M-5...396

A Map of VERMONT
The Green Mountain State

(Office) CORRECTED COPY 8-17-45

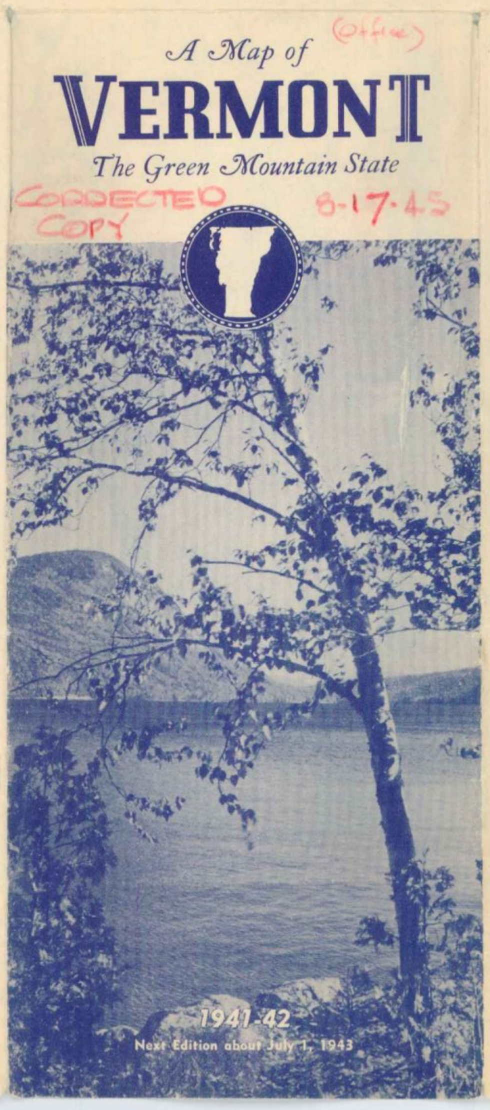

SYNOPSIS OF MOTOR VEHICLE LAWS

1941-42

SUBJECT TO CHANGES BY LEGISLATURE

Registration

Under the Vermont law a non-resident is exempt from registration of a pleasure car while in this state as a visitor, provided the state of his residence grants the same reciprocity to residents of Vermont. No permit or registration required of chartered busses.

Careless or Negligent Operators; Speed

The laws of Vermont provide that a motor vehicle shall not be operated on a public highway in a careless or negligent manner, nor in a manner to endanger the safety, life, or property of any person, and the speed limit for pleasure cars is fifty miles per hour, and for pleasure cars with trailer coaches or house trailers forty miles per hour.

Cities and incorporated villages have authority to make special regulations relative to speed of motor vehicles provided such limit is fixed at not less than twenty miles per hour.

Accidents; Duties of Operator

The operator of any motor vehicle involved in an accident must immediately stop and give his name, residence, license number and the name of the owner of the motor vehicle then under his control, to the party whose person or property is injured.

The operator is further required to report the accident, within twenty-four hours, to the Commissioner of Motor Vehicles at Montpelier, Vt., if there are personal injuries or the damages exceed $25.

Not Over Three Persons Allowed on Front Seat

A person must not operate a motor vehicle in Vermont, with more than three persons on the front seat, or in the front or driving compartment of a motor vehicle occupied by the operator of such vehicle.

In any emergency apply to the nearest motor vehicle inspector. They are for your service, aid and protection.

For any information relative to the motor vehicle laws, address the Motor Vehicle Department, Montpelier, Vermont.